


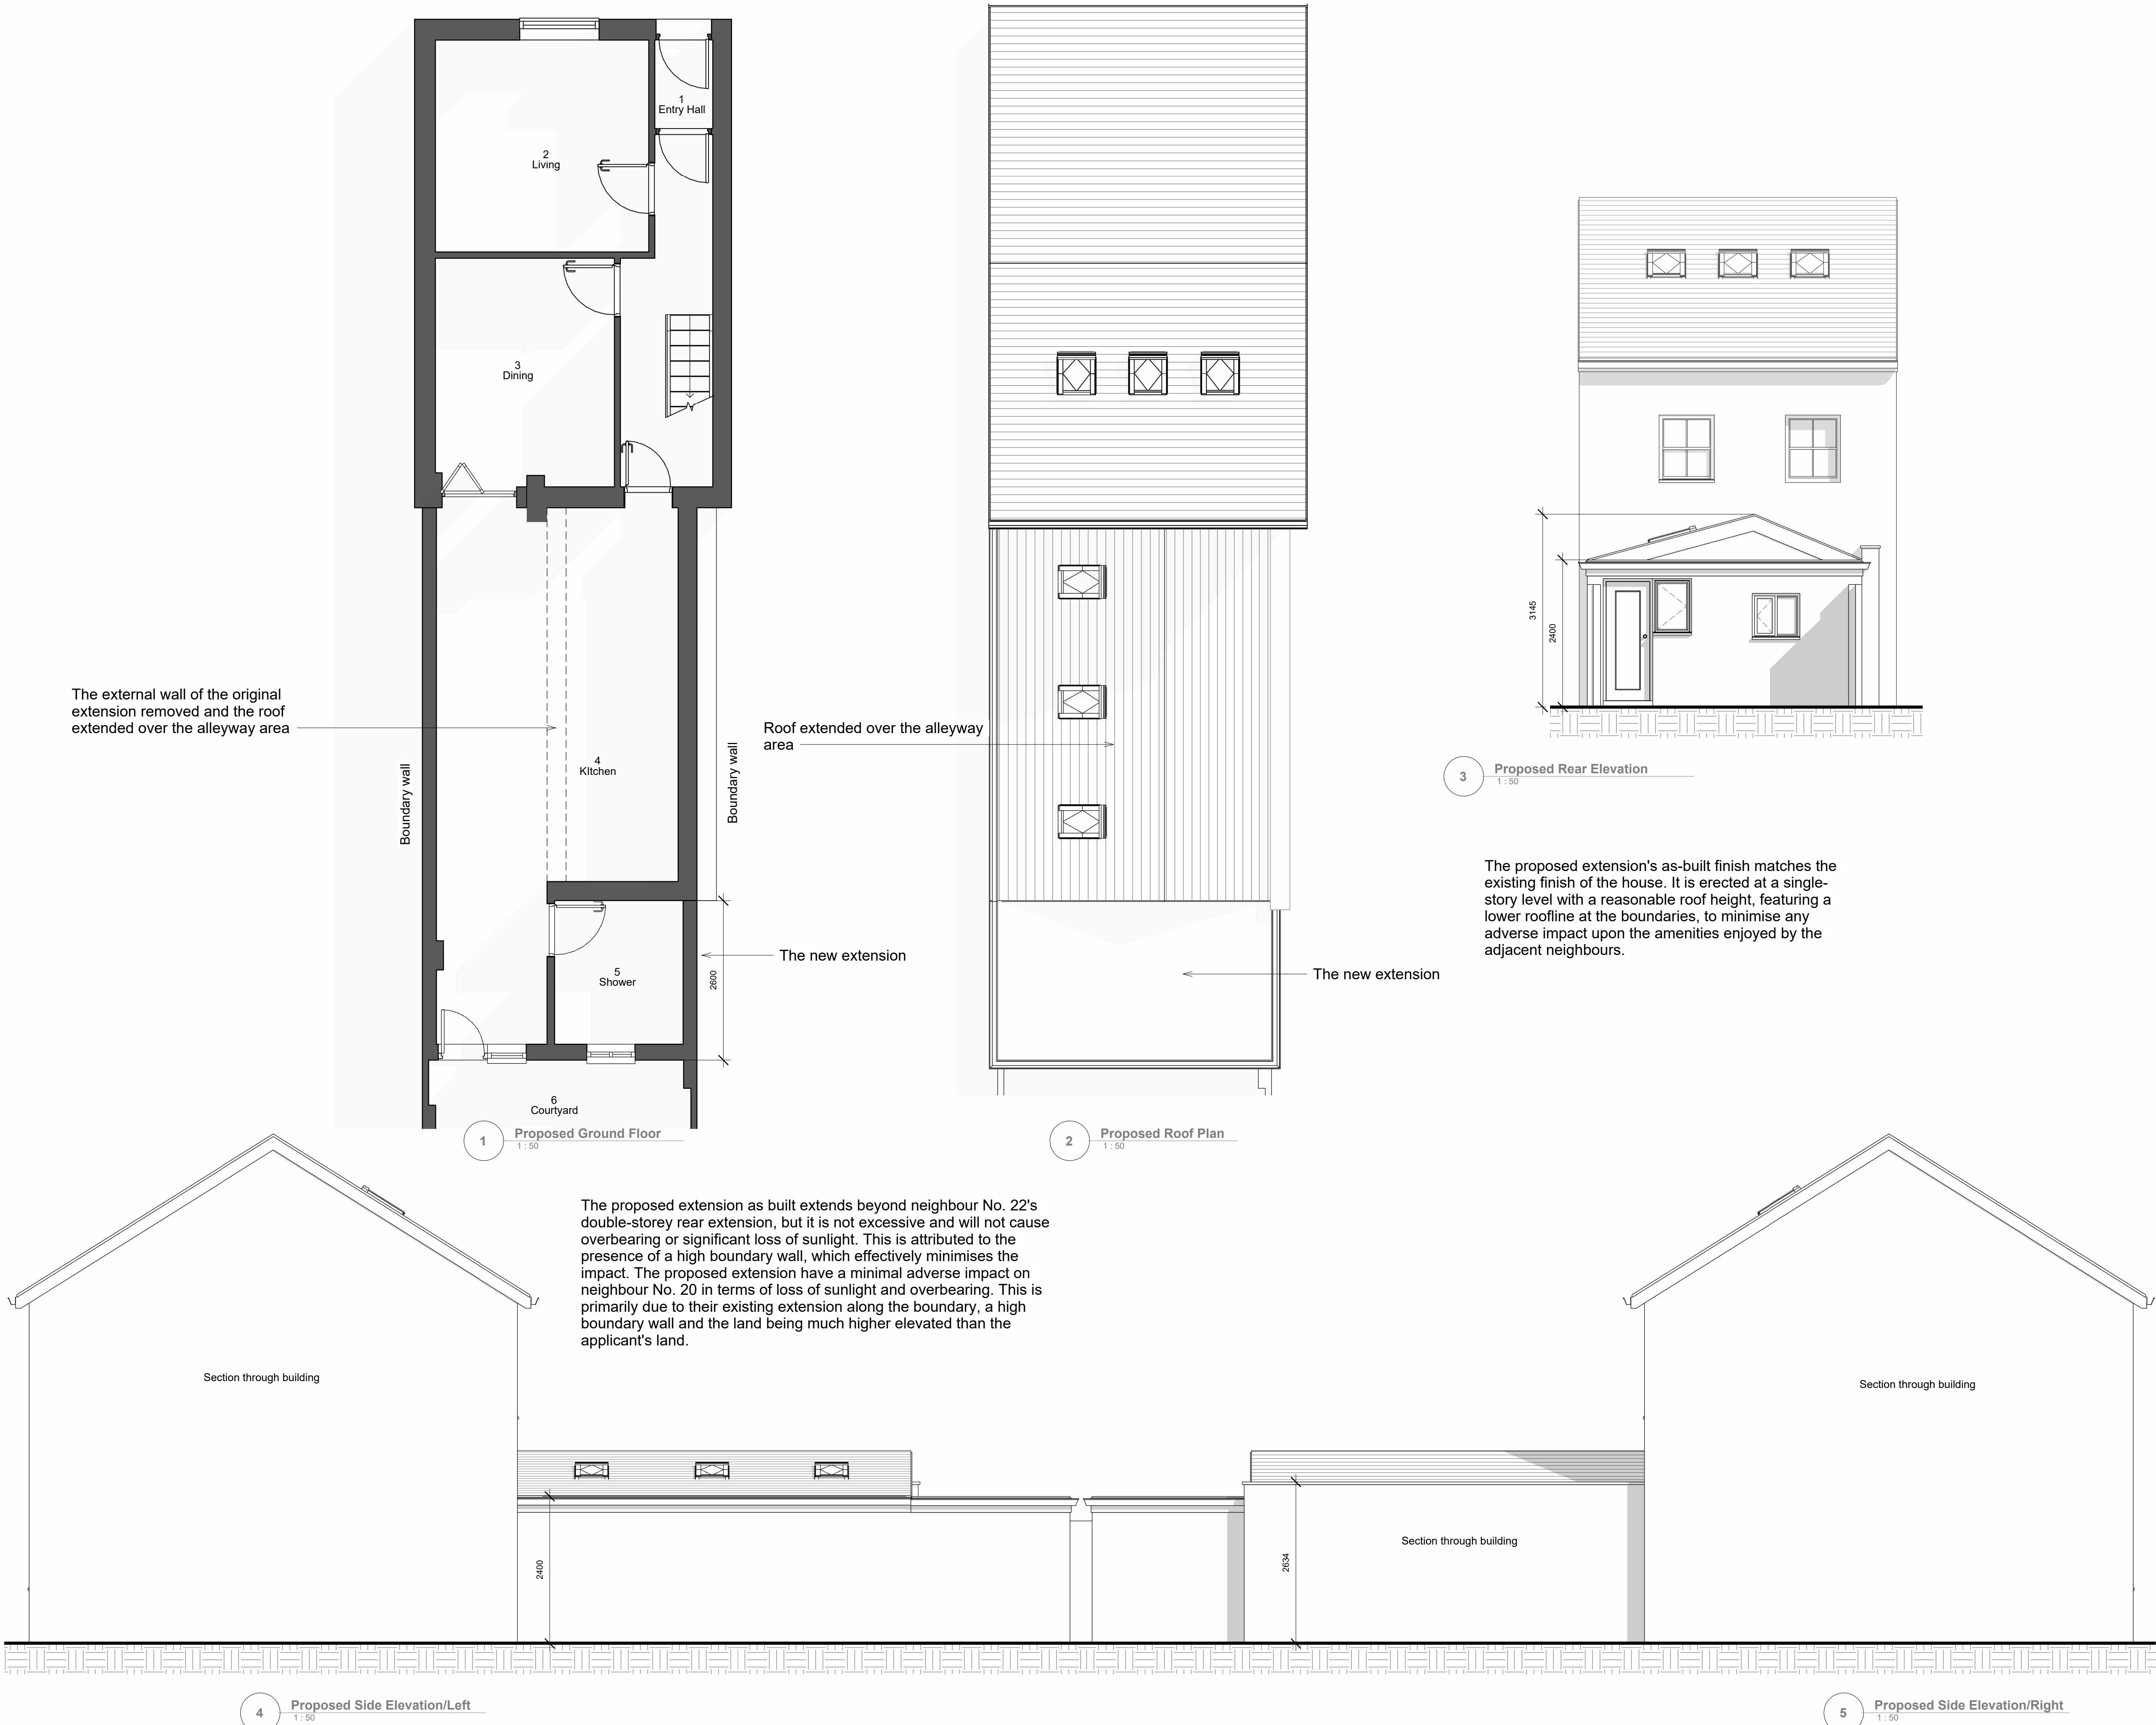

CODE	SUITABILITY DESCRIPTION		
STATUS	PURPOSE OF ISSUE Planning Permission		
	Tel:07506795182 Info:info@iamarchitecture.co.uk		
PROJECT Retroperspective single-storey rear infill extension			
TITLE Proposed Plans and Elevation (As-built)			
CLIENT 21 South Market Street			
DRAWN BY MF	CHECKED BY AH	DATE 08/13/25	
SCALE (@ A1) 1 : 50		PROJECT NUMBER 10087	
DRAWING NUMBER SM 02			REV