

DO NOT SCALE

ATKINS

This 'As Built' drawing has been produced based on information provided by Norwest Holst Construction Ltd

NOTE:


PLAN ISSUED FOR COMMENT ONLY; NOT FOR CONSTRUCTION

PL - Pitch Level

BOS - Bottom of Steps
TOS - Top of Steps


BOW - Bottom of Wall
TOW - Top of Wall

All levels to bottom of kerb unless otherwise noted

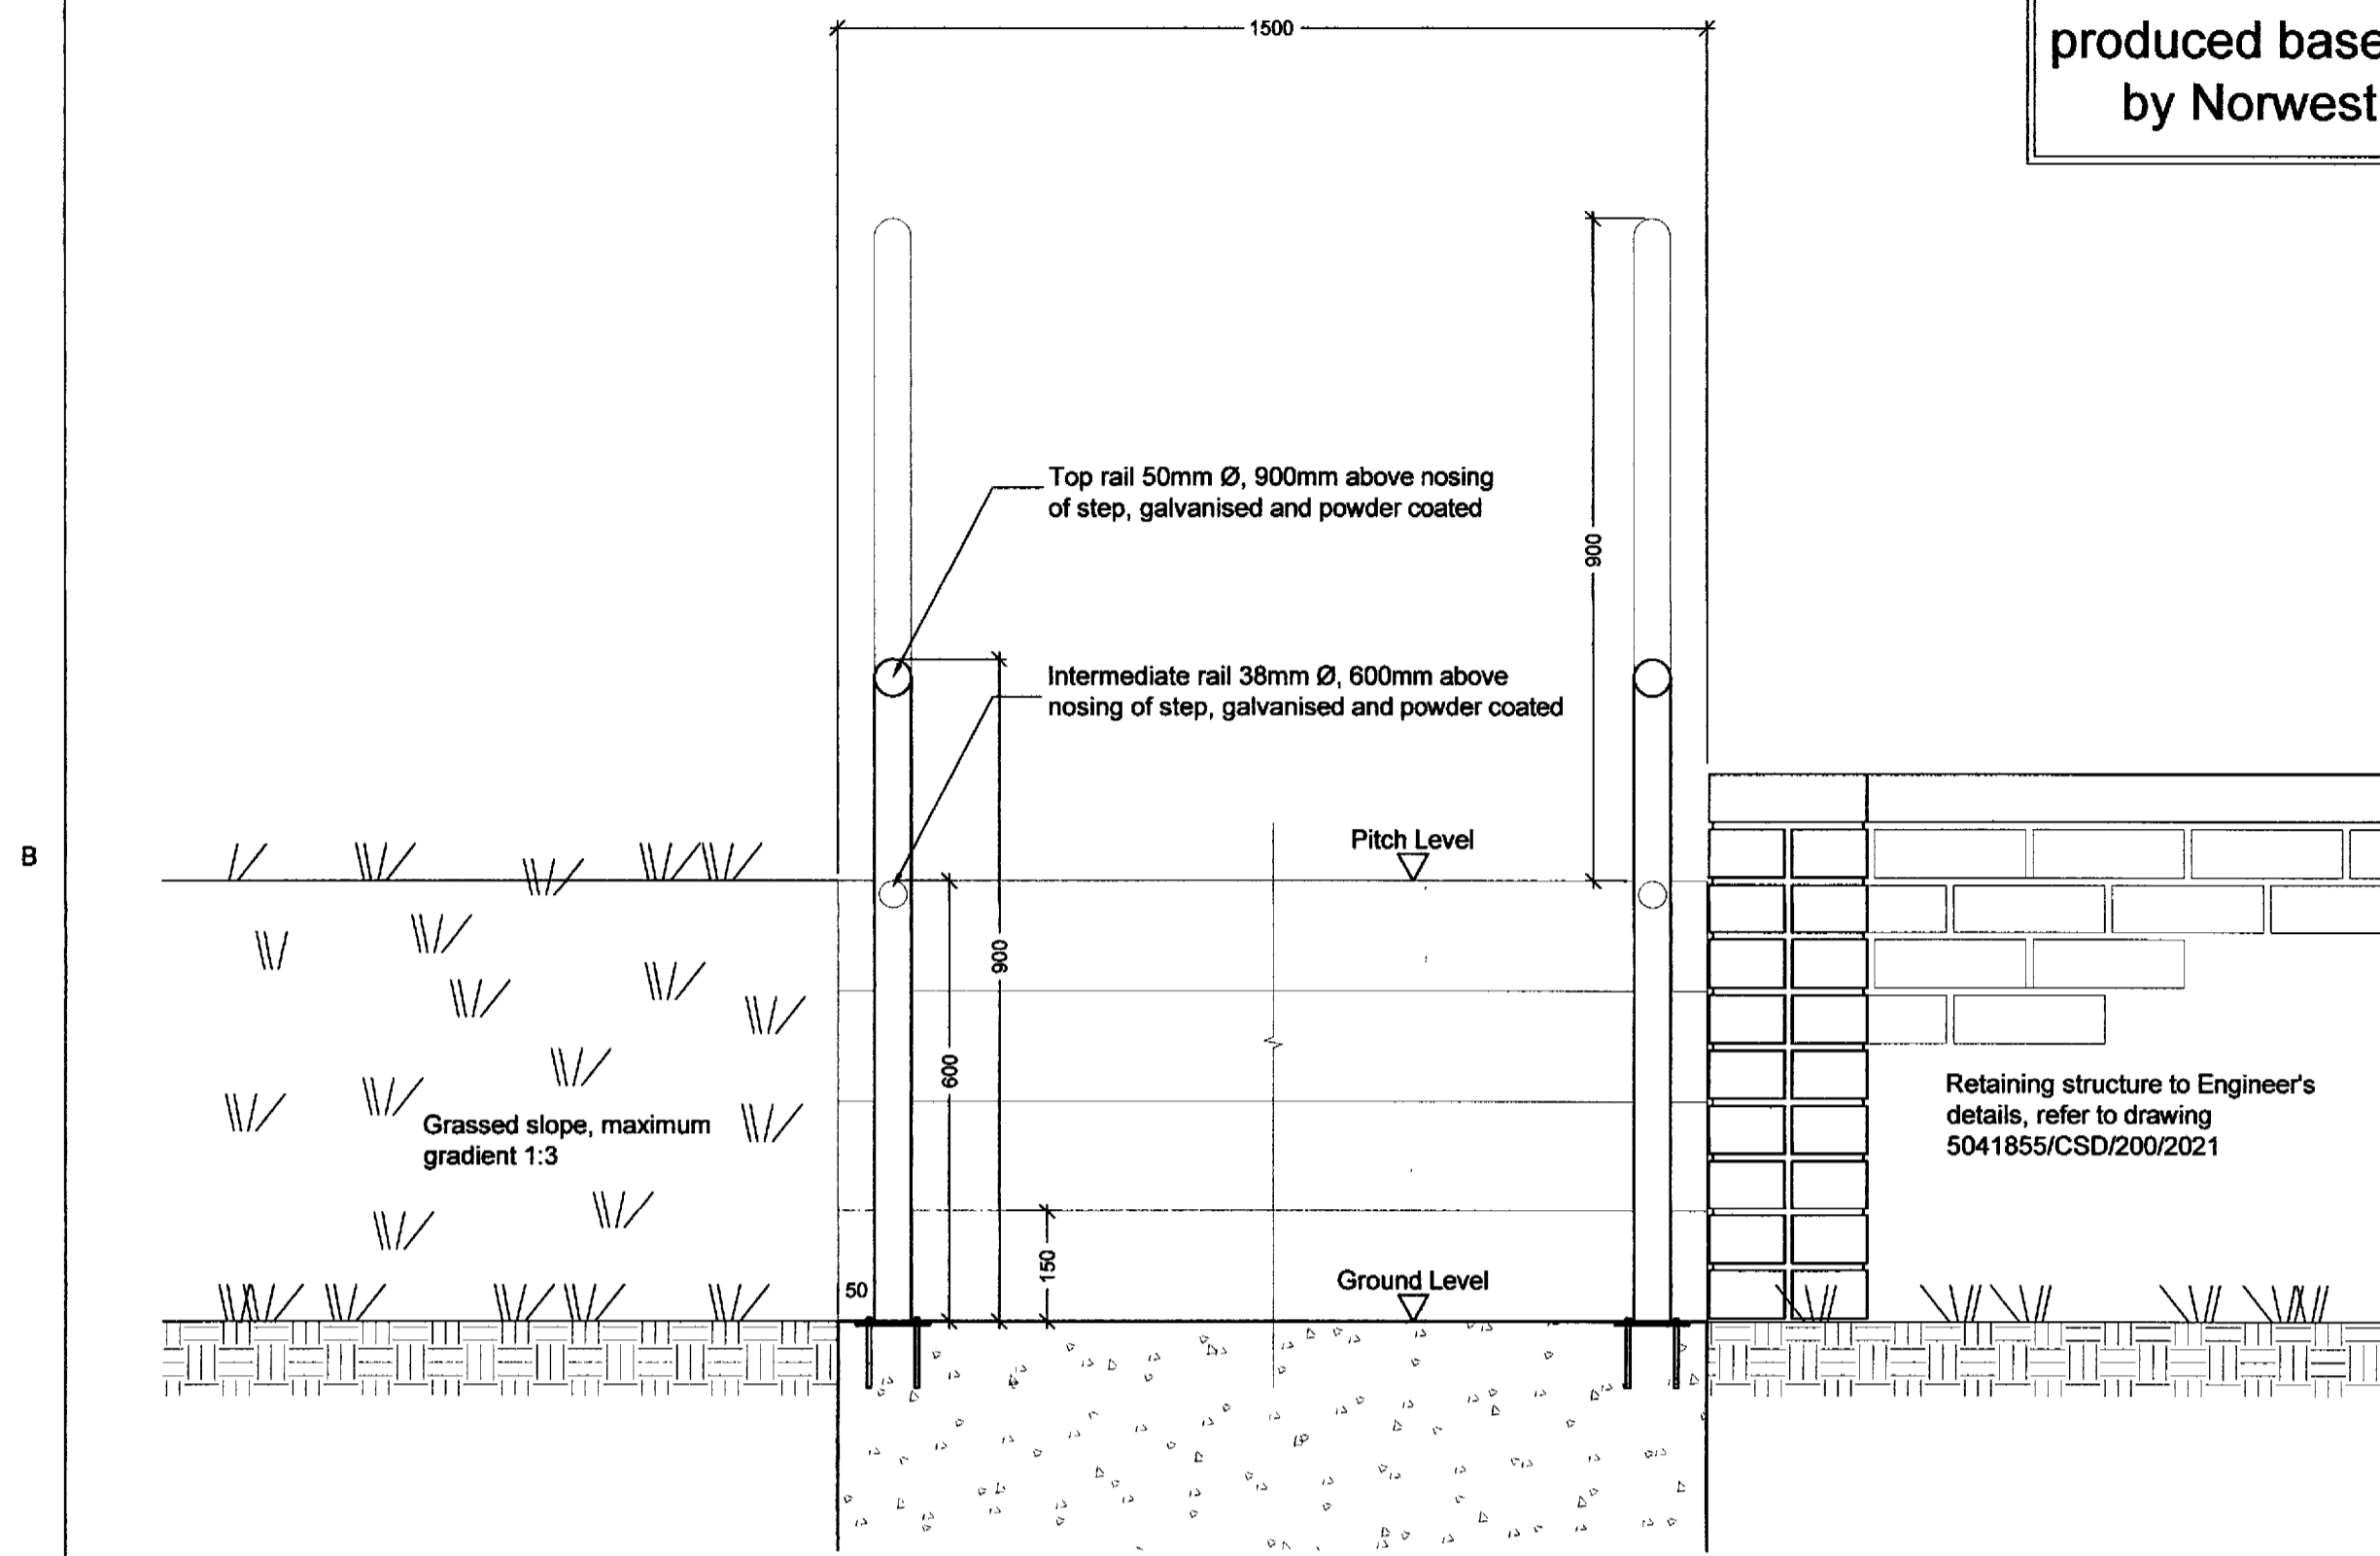


MUGA Maintenance Access Steps

Scale 1:10

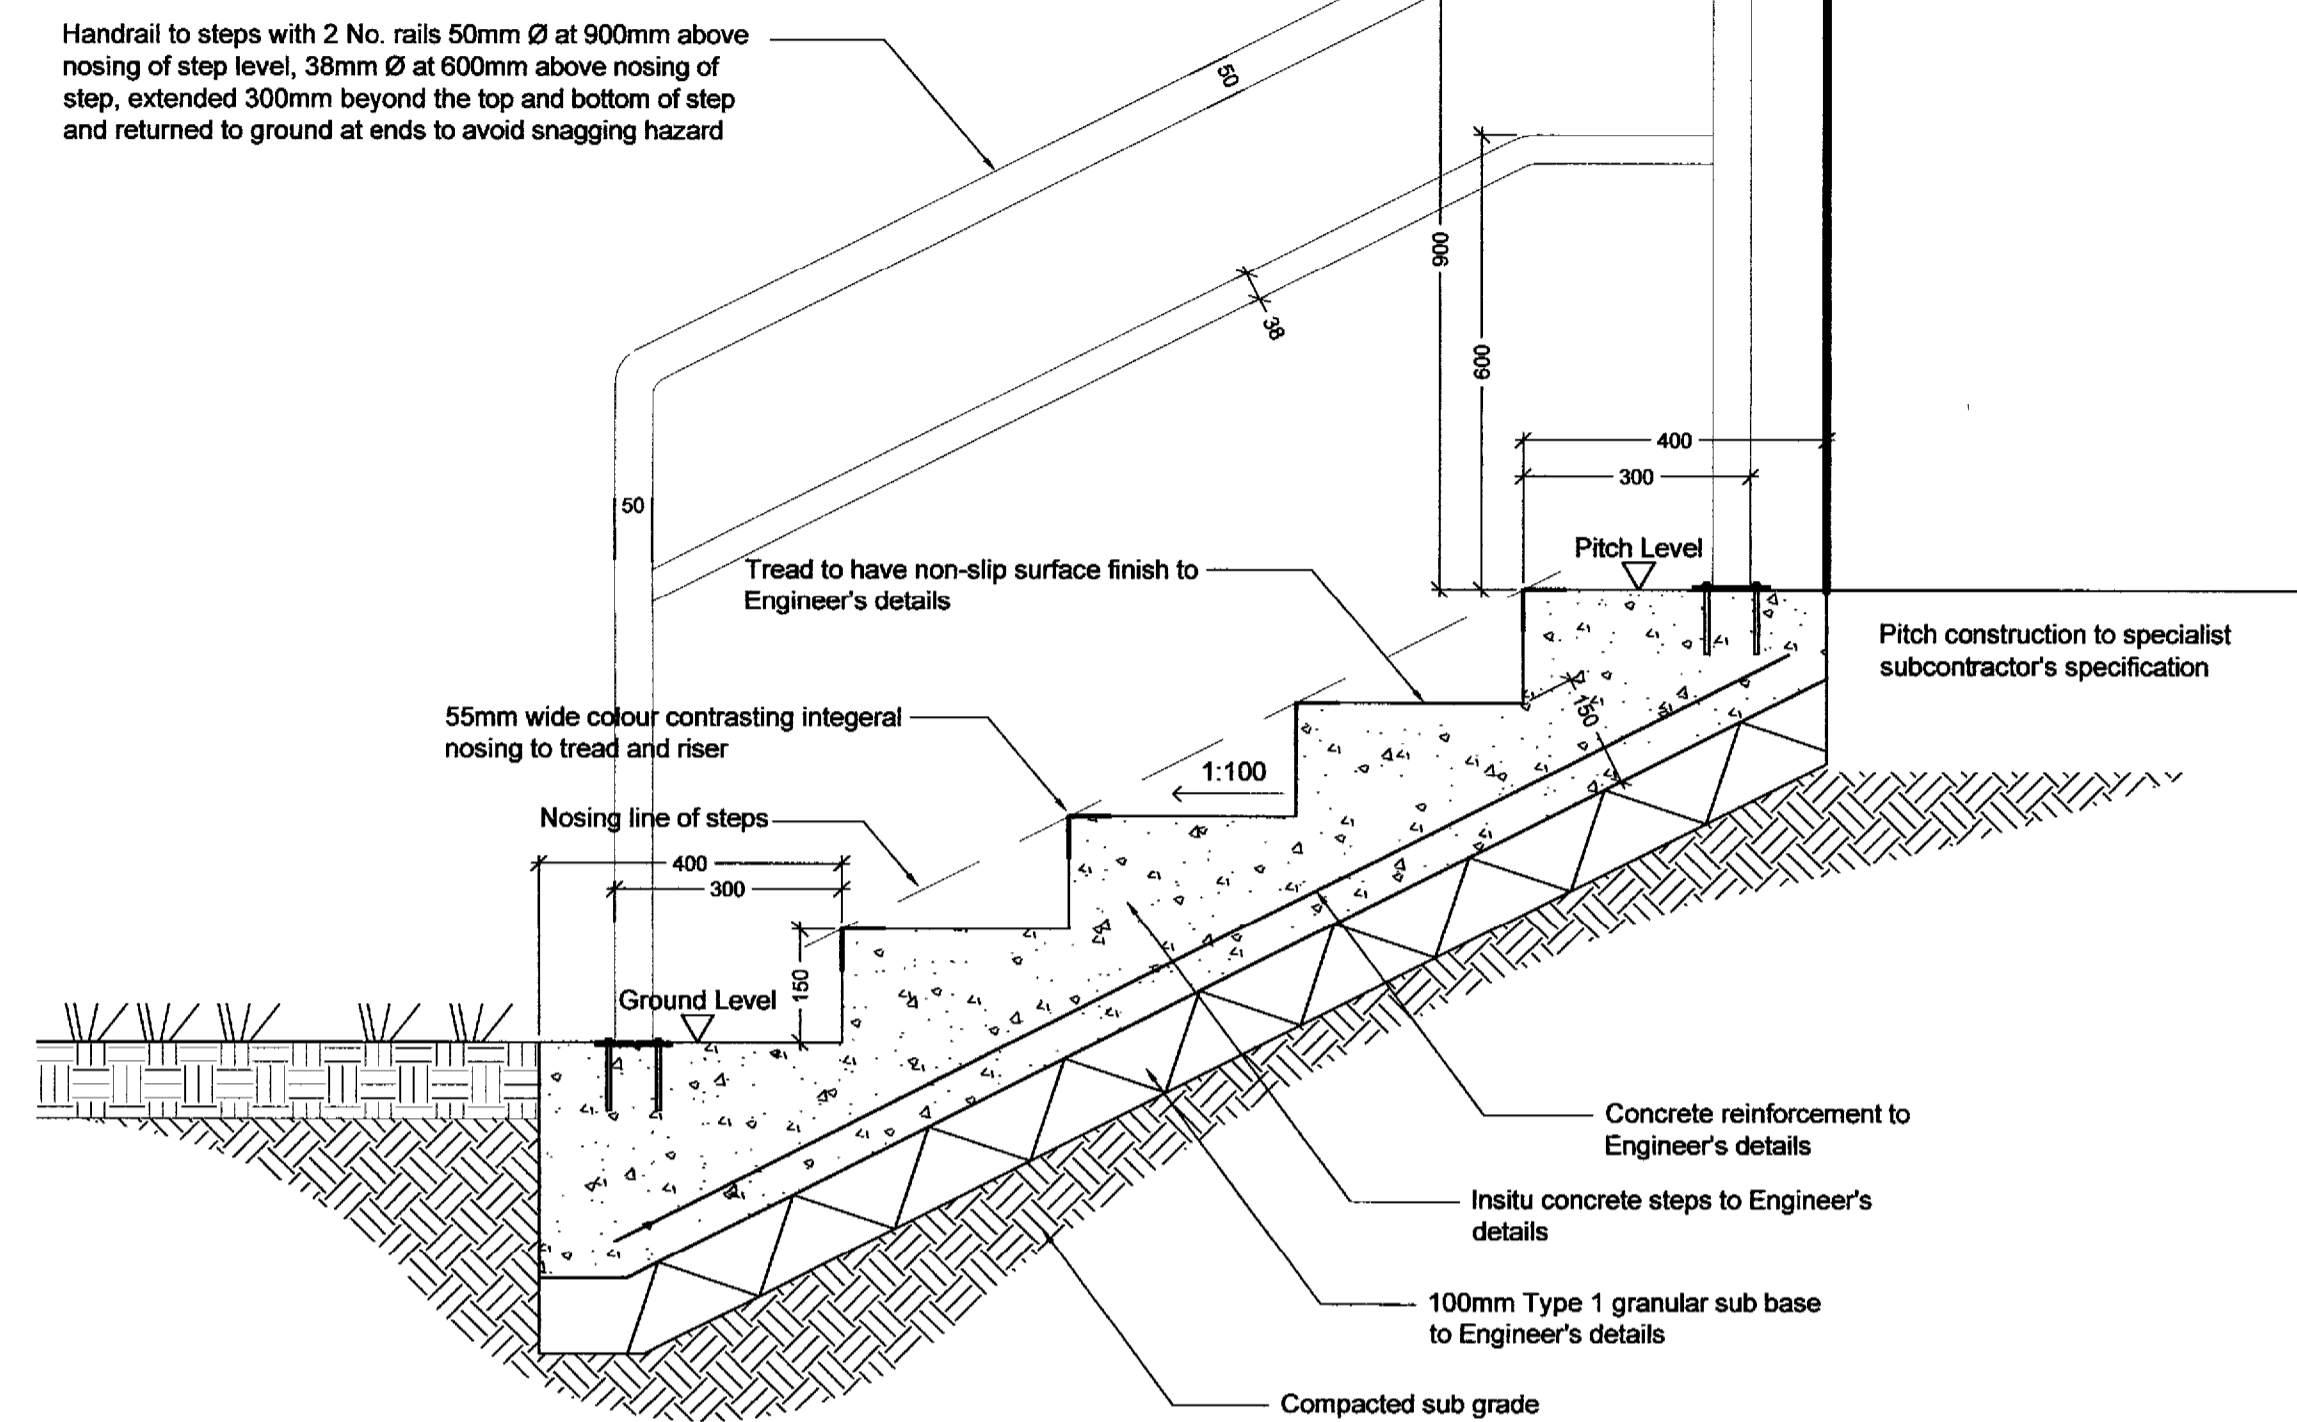

MUGA Maintenance Access Steps Section

Scale 1:10

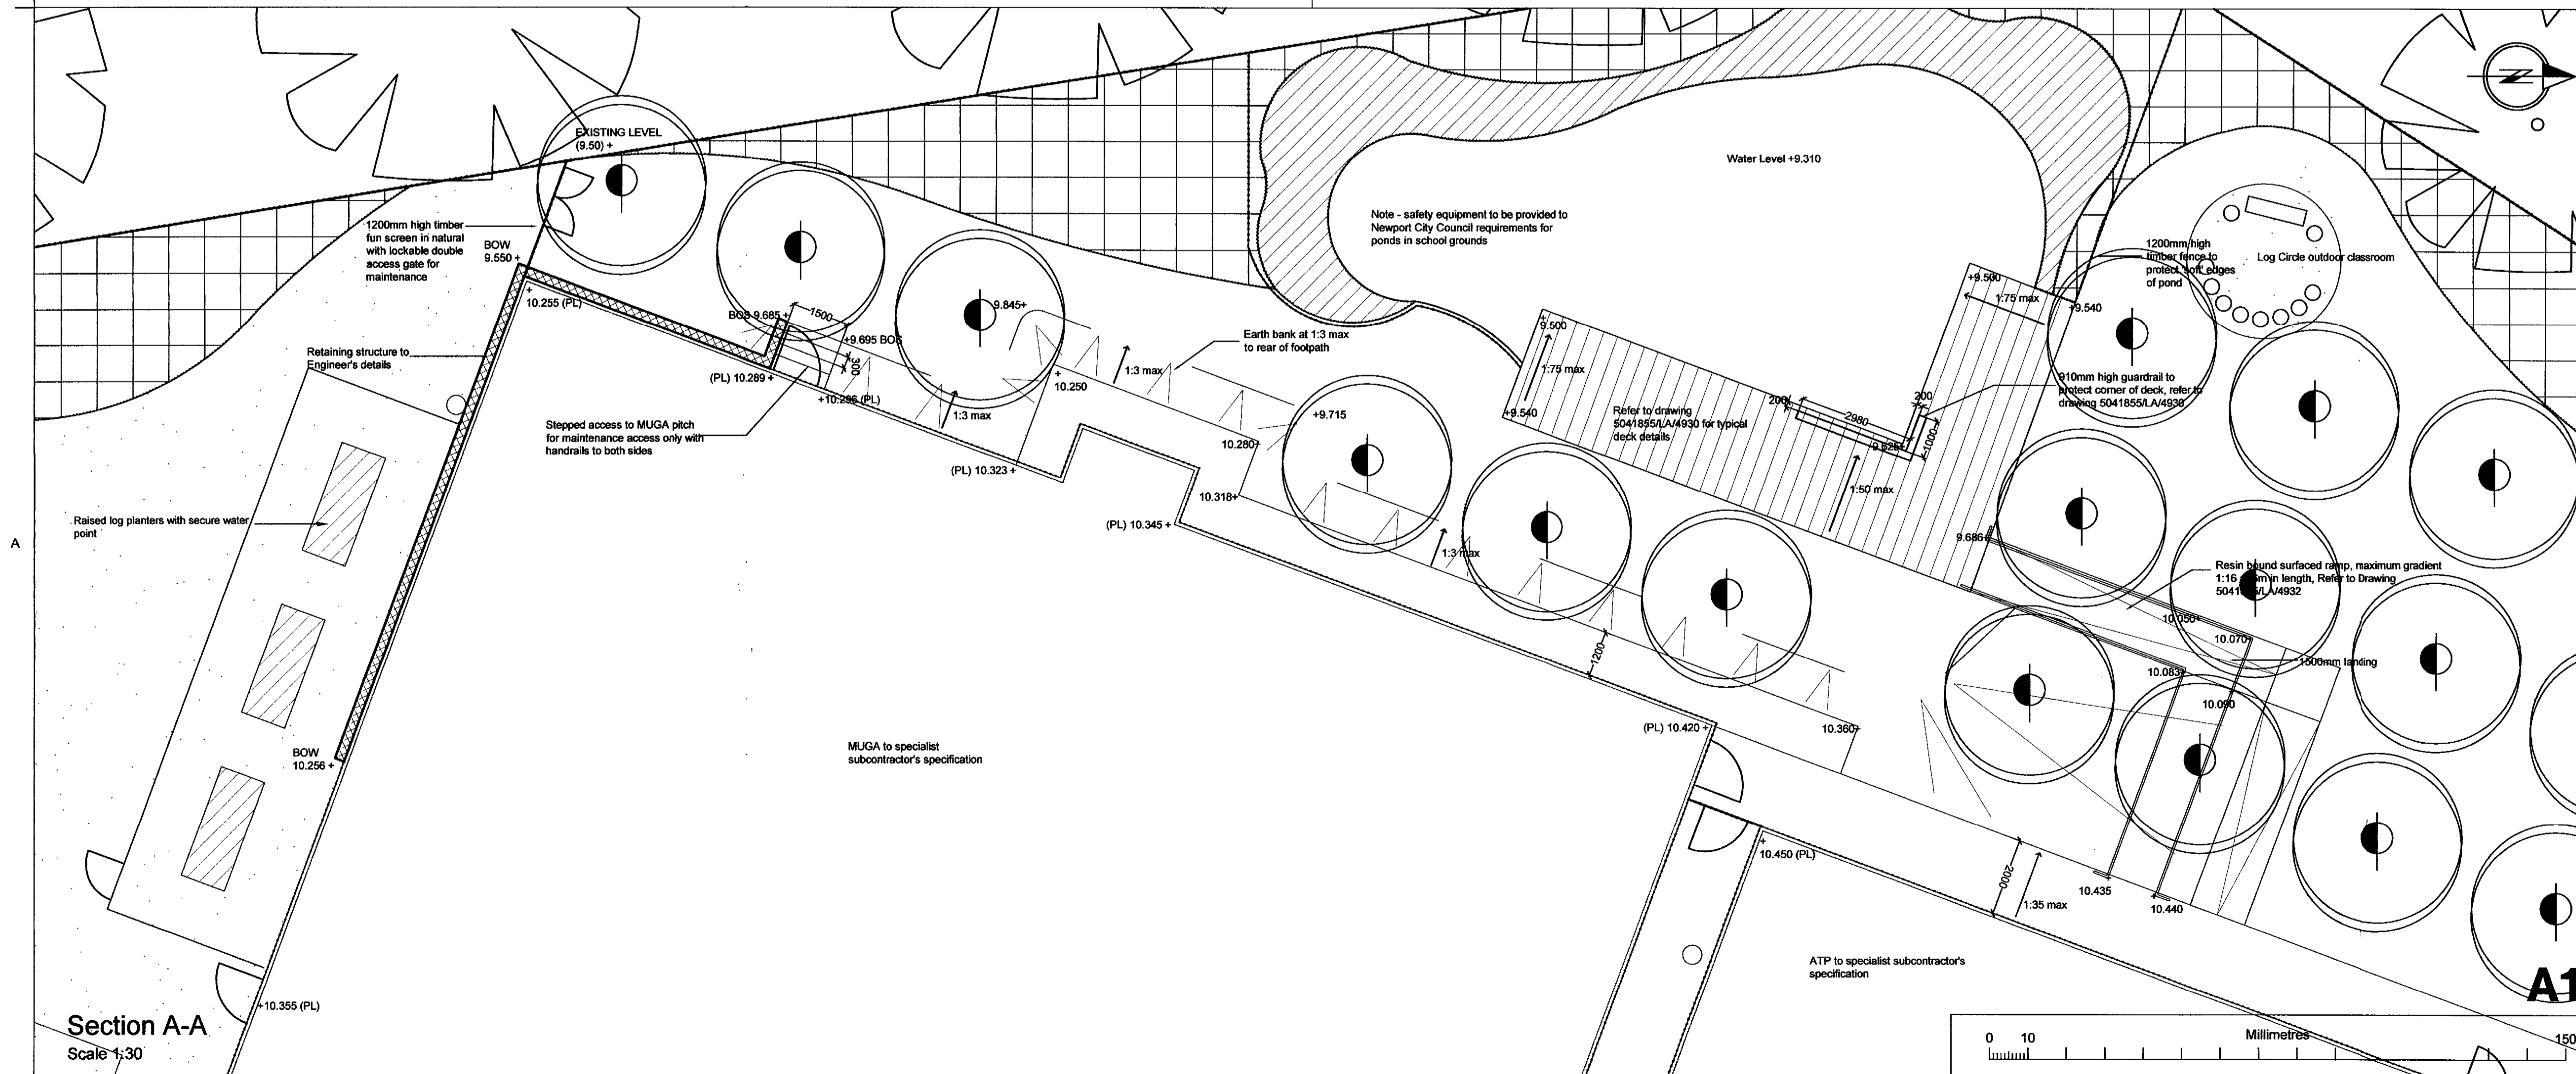

Section A-A

Scale 1:30

Rev.	Description	By	Date	CHK	Auth
H	AS BUILT ISSUE	AL	28/10/09	NR	NR
A	PLANNING		29/05/09	NR	NR
O	FOR COMMENT		08/04/09	COMMENT	



WS Atkins Consultants Limited
Design, Environment & Engineering
160 Aztec West, Almondsbury, Bristol. BS32 4TU.
Tel. 01454 201400 / Fax. 01454 201568

Project
Glebelands Development
St Julians
Newport

Title
Glan Usk School
AS BUILT
Outdoor Resource Area MUGA Access Steps

Original Scale	Drawn	Checked	Authorised
Var.	AIL	Date: 07/04/09	Date:

Drawing Number: 5041855 / LA / 4933

Rev: B