



This 'As Built' drawing has been produced based on information provided by Norwest Holst Construction Ltd

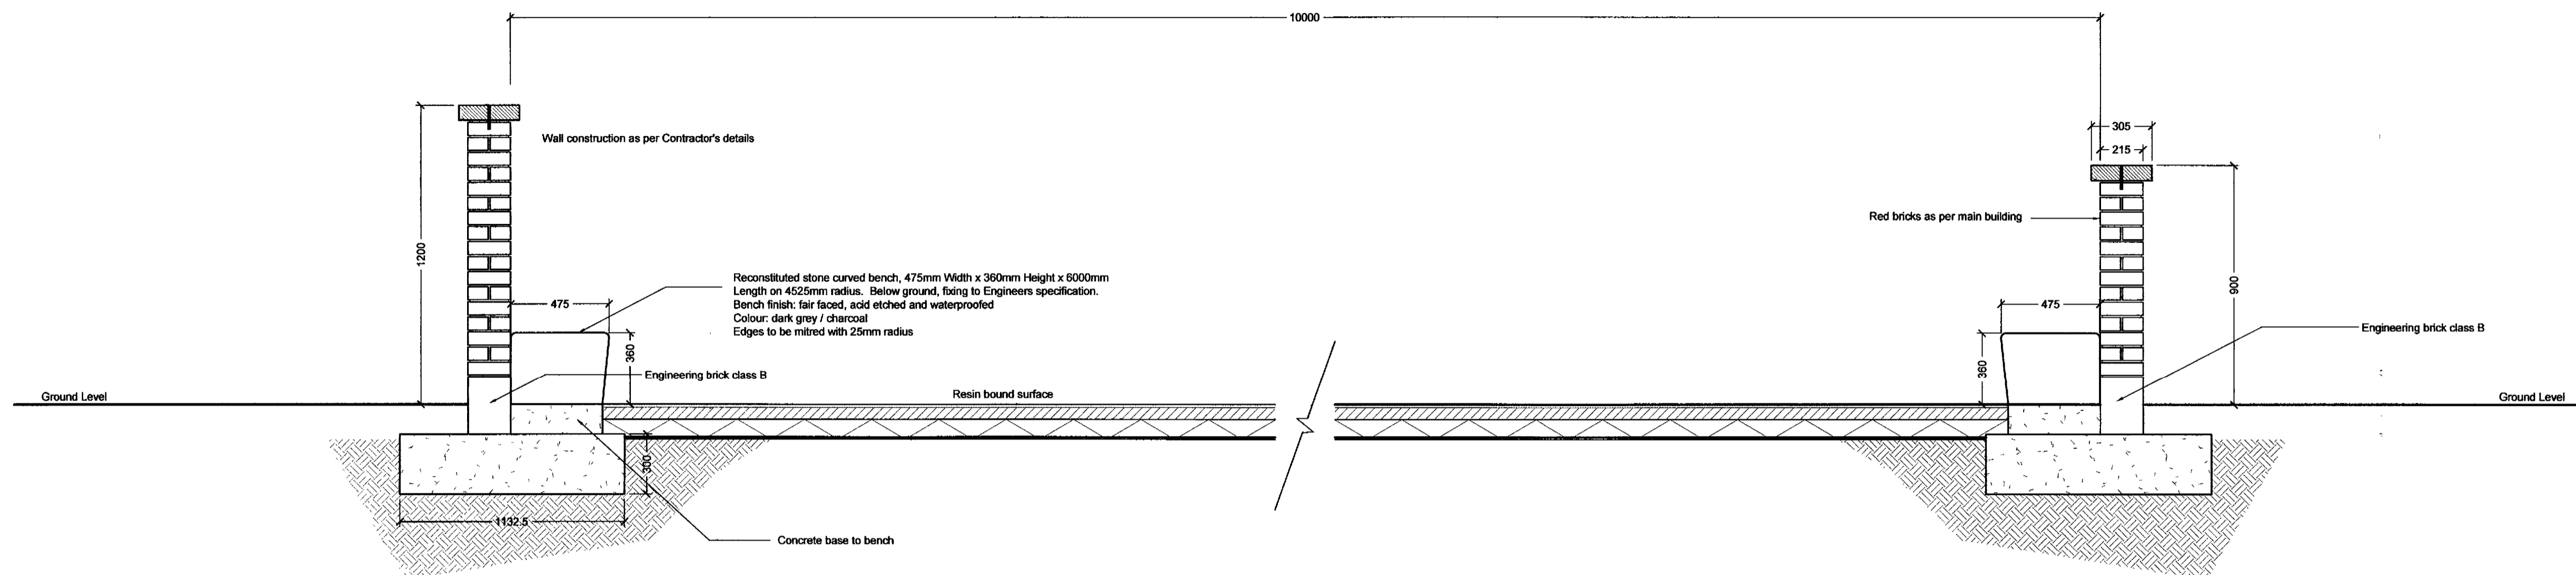

Section through Walled Seating Area

Scale 1:20

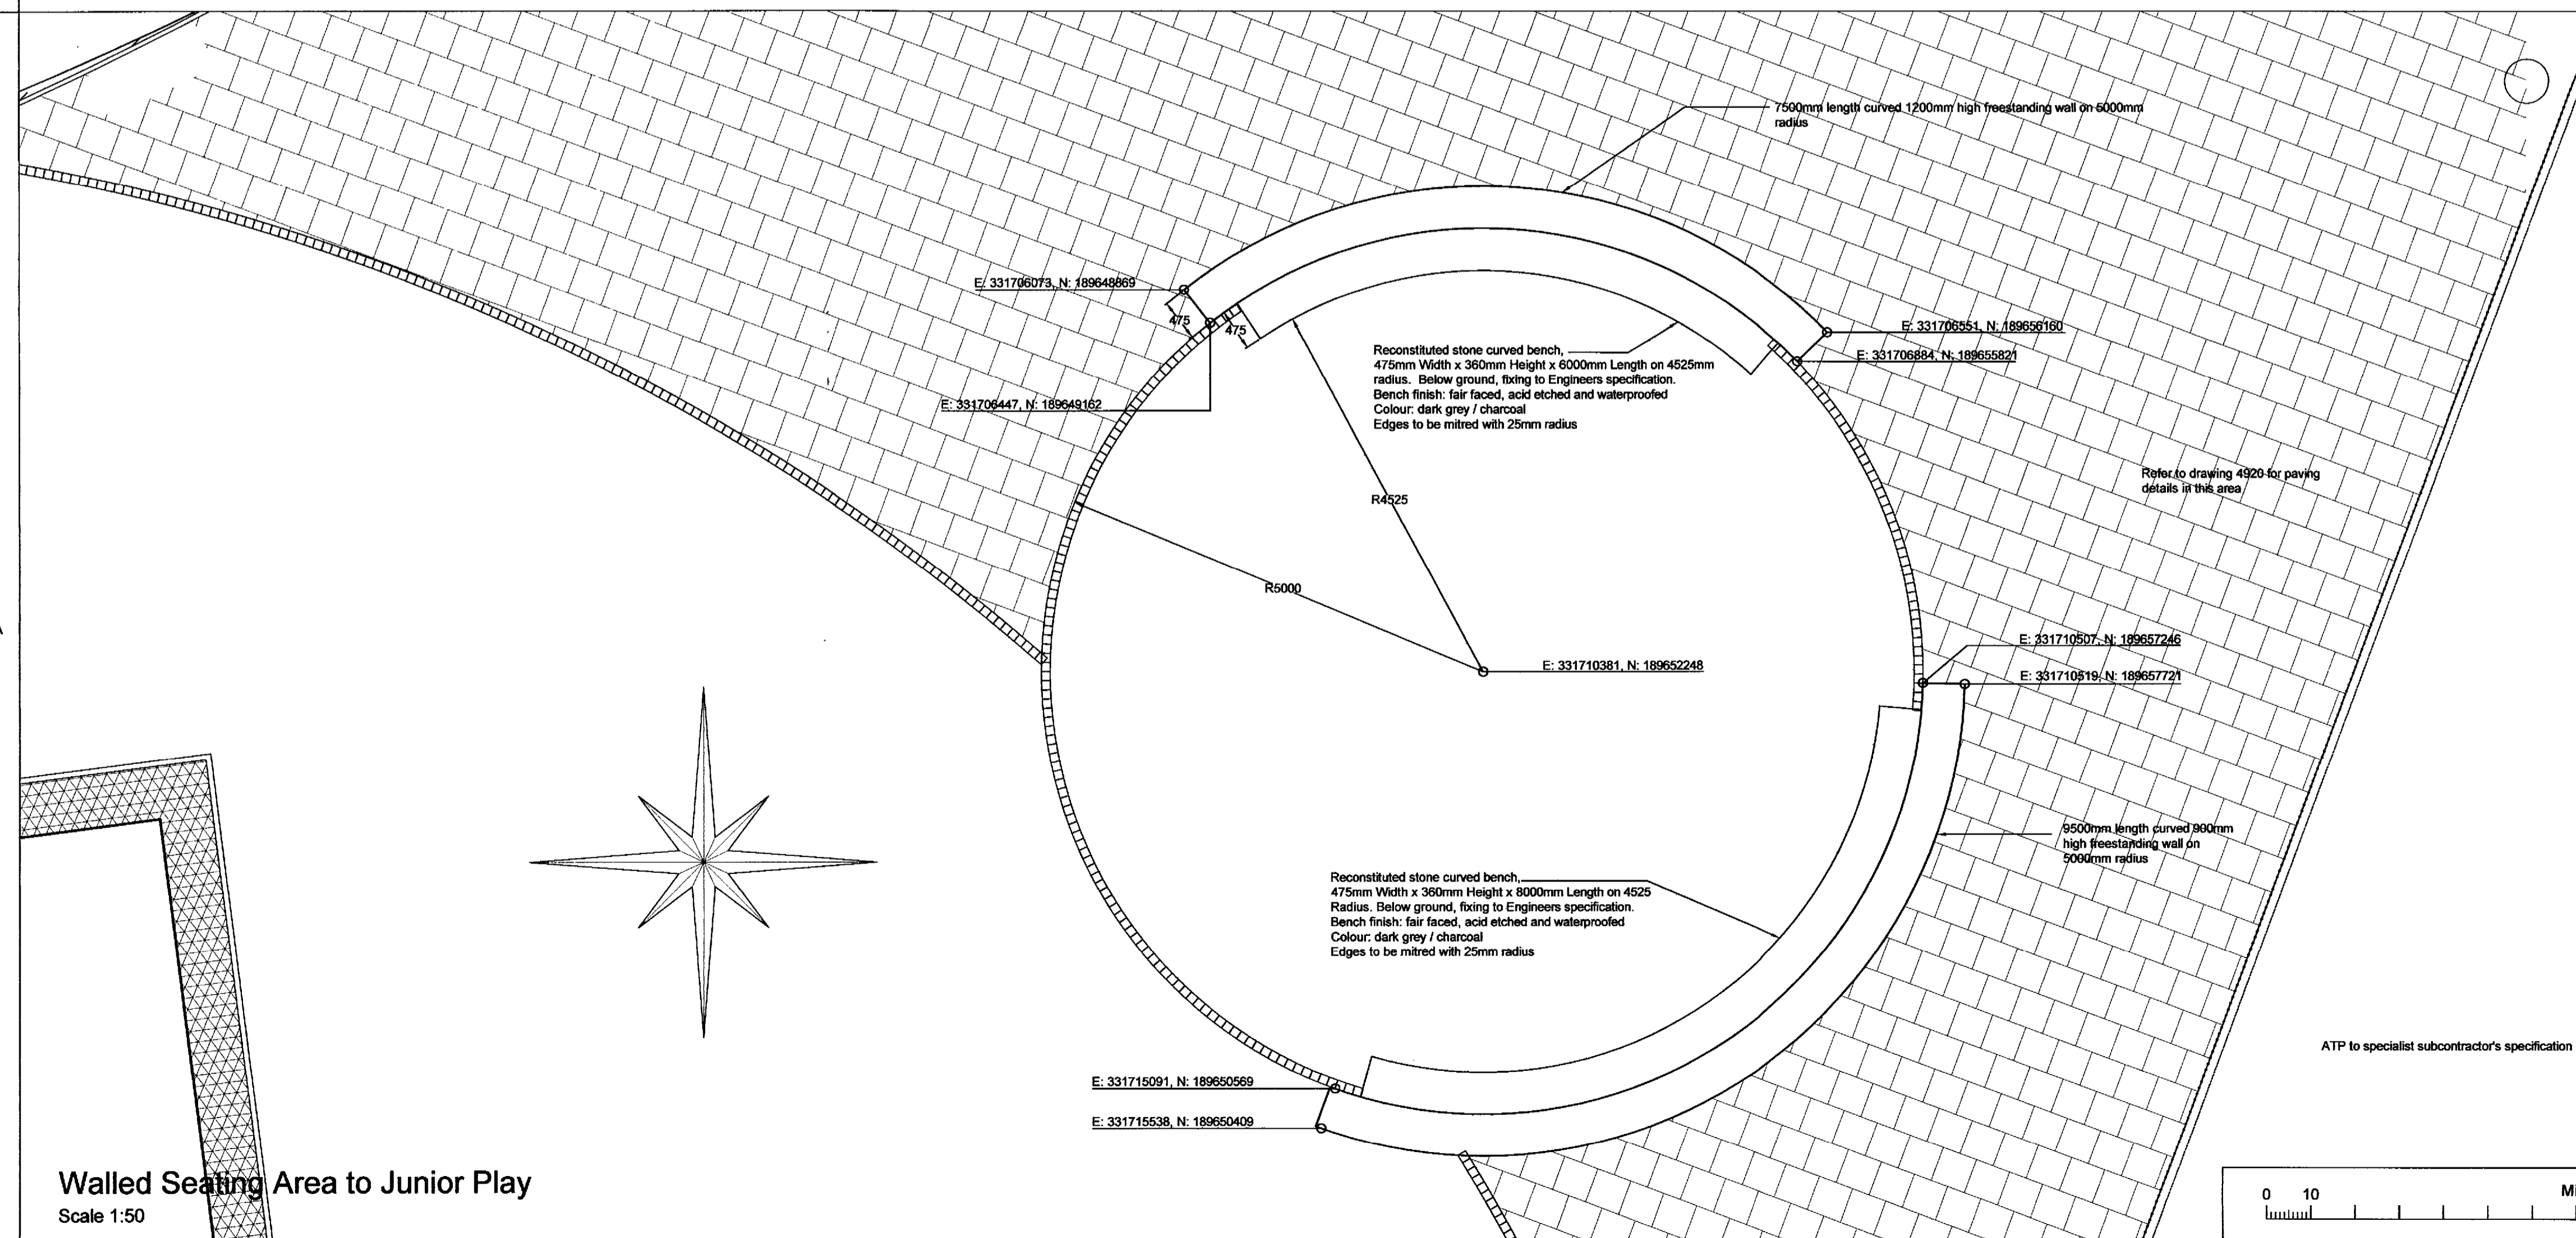

Walled Seating Area to Junior Play

Scale 1:50

| Rev | Description                        | By | Date     | CHK'd | Auth |
|-----|------------------------------------|----|----------|-------|------|
| B   | AS BUILT ISSUE                     | AL | 28/10/09 | NR    | NR   |
| A   | Coordinates added to ends of walls | AL | 14/07/09 | NR    | NR   |
| B   | AS BUILT                           |    | 28/10/09 |       | NR   |
| A   | CONSTRUCTION                       |    | 14/07/09 |       | NR   |
| O   | CONSTRUCTION                       |    | 01/07/09 |       | NR   |




**WS Atkins Consultants Limited**  
 Design, Environment & Engineering  
 160 Aztec West, Almondsbury, Bristol. BS32 4TU.  
 Tel. 01454 201400 / Fax. 01454 201588

Project  
 Glebelands Development  
 St Julians  
 Newport

Title  
 Glen Usk School  
 AS BUILT  
 Junior Play Area Wall Details

| Original Scale | Drawn    | Checked  | Authorised | Rev |
|----------------|----------|----------|------------|-----|
| Var.           | AHL      | NR       | NR         | B   |
| Drawing Number | Date     | Date     | Date       |     |
| 5041855 / LA / | 01/07/09 | 01/07/09 | 01/07/09   |     |
| 4937           |          |          |            |     |

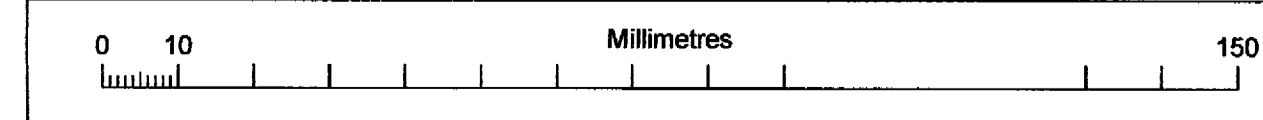

**A1**