

This 'As Built' drawing has been produced based on information provided by Norwest Holst Construction Ltd

DO NOT SCALE

ATKINS

- Key
- Existing Trees to be Retained
 - Proposed Grass Areas
 - Proposed Native Wildflower Meadow
 - Proposed Safety Surface Grass Matting
 - Proposed Shrub Planting
 - Proposed Woodland Planting Mix
 - Proposed Tree planting
 - Proposed Native Hedge

AS BUILT ISSUE
Amendments to as built conditions: Fenceline to main entrance amended, playground markings moved from nursery to infant play area, litter bins removed, gas intake enclosure added

Proposed location for flagpole indicated. Cycle parking arrangement updated to accommodate covered shelter. Location of equipment store adjusted to suit levels. Location of shelter adjusted to suit gate locations. Bridge Street entrance proposals updated as per Authority request.

Grasscover matting added to coloured pencils and toolstoys within grassed areas. Log circle reduced to 3m diameter as per school's request. 1 No. log planter omitted as per Authority instruction. Indicative school signage locations identified as per Authority request. MEWP access route to school added.

White lining and signage added to public car park as per Authority request. Designated delivery bay identified as per ACN 08 041. Rubberised play surface area revised as per Authority request. 2 No. optional locations for raised planters identified for Authority selection.

Amendments to Authority Change Notices: Freestanding shelters to main entrance and southeast school access omitted. Tree planting to front of school relocated to Village Green. Area for infants garden indicated. Reconstructed stone benches relocated from Clubhouse to school grounds. Wildlife area arrangement revised to increased sport pitch levels. Location for log circle indicated and proposed orchard tree located to accommodate.

Drop kerb added to car park with kickrail to prevent vehicle access to recreation ground. School car park intercom location added. Location of sprinkler building adjusted to avoid building canopy. Outdoor classroom location indicated. Equipment store location indicated. White lining to bin store added. Pedestrian gate to resource centre omitted.

Rev.	Description	By	Date	CHK
H	AS BUILT		28/10/09	NR
G	CONSTRUCTION		29/08/09	MD
F	CONSTRUCTION		04/08/09	MD
E	PLANNING		29/05/09	NR
D	COMMENT & APPROVAL BY AUTHORITY		22/05/09	MD
C	COMMENT		15/05/09	NR
B	CONSTRUCTION		14/11/08	NR
A	CONSTRUCTION		06/08/08	NR
Rev.	Purpose of issue	Date	Authoris	

VINCI

NORWEST
HOLST


WS Atkins Consultants Limited
Design, Environment & Engineering
160 Aztec West, Almondsbury, Bristol, BS32 4TU.
Tel. 01454 201400 / Fax. 01454 201568

Project
Glebelands Development
St Julians
Newport

Title
Glan Usk School
AS BUILT
General Arrangement

Original Scale	Drawn	Checked	Authorised
1:500	AHL	NR	NR
Drawing Number	Date	Date	Date
5041855 / LA /	10/01/08	07/02/08	07/02/08
4900			
Rev			
H			

River Usk (Afon Wysg)

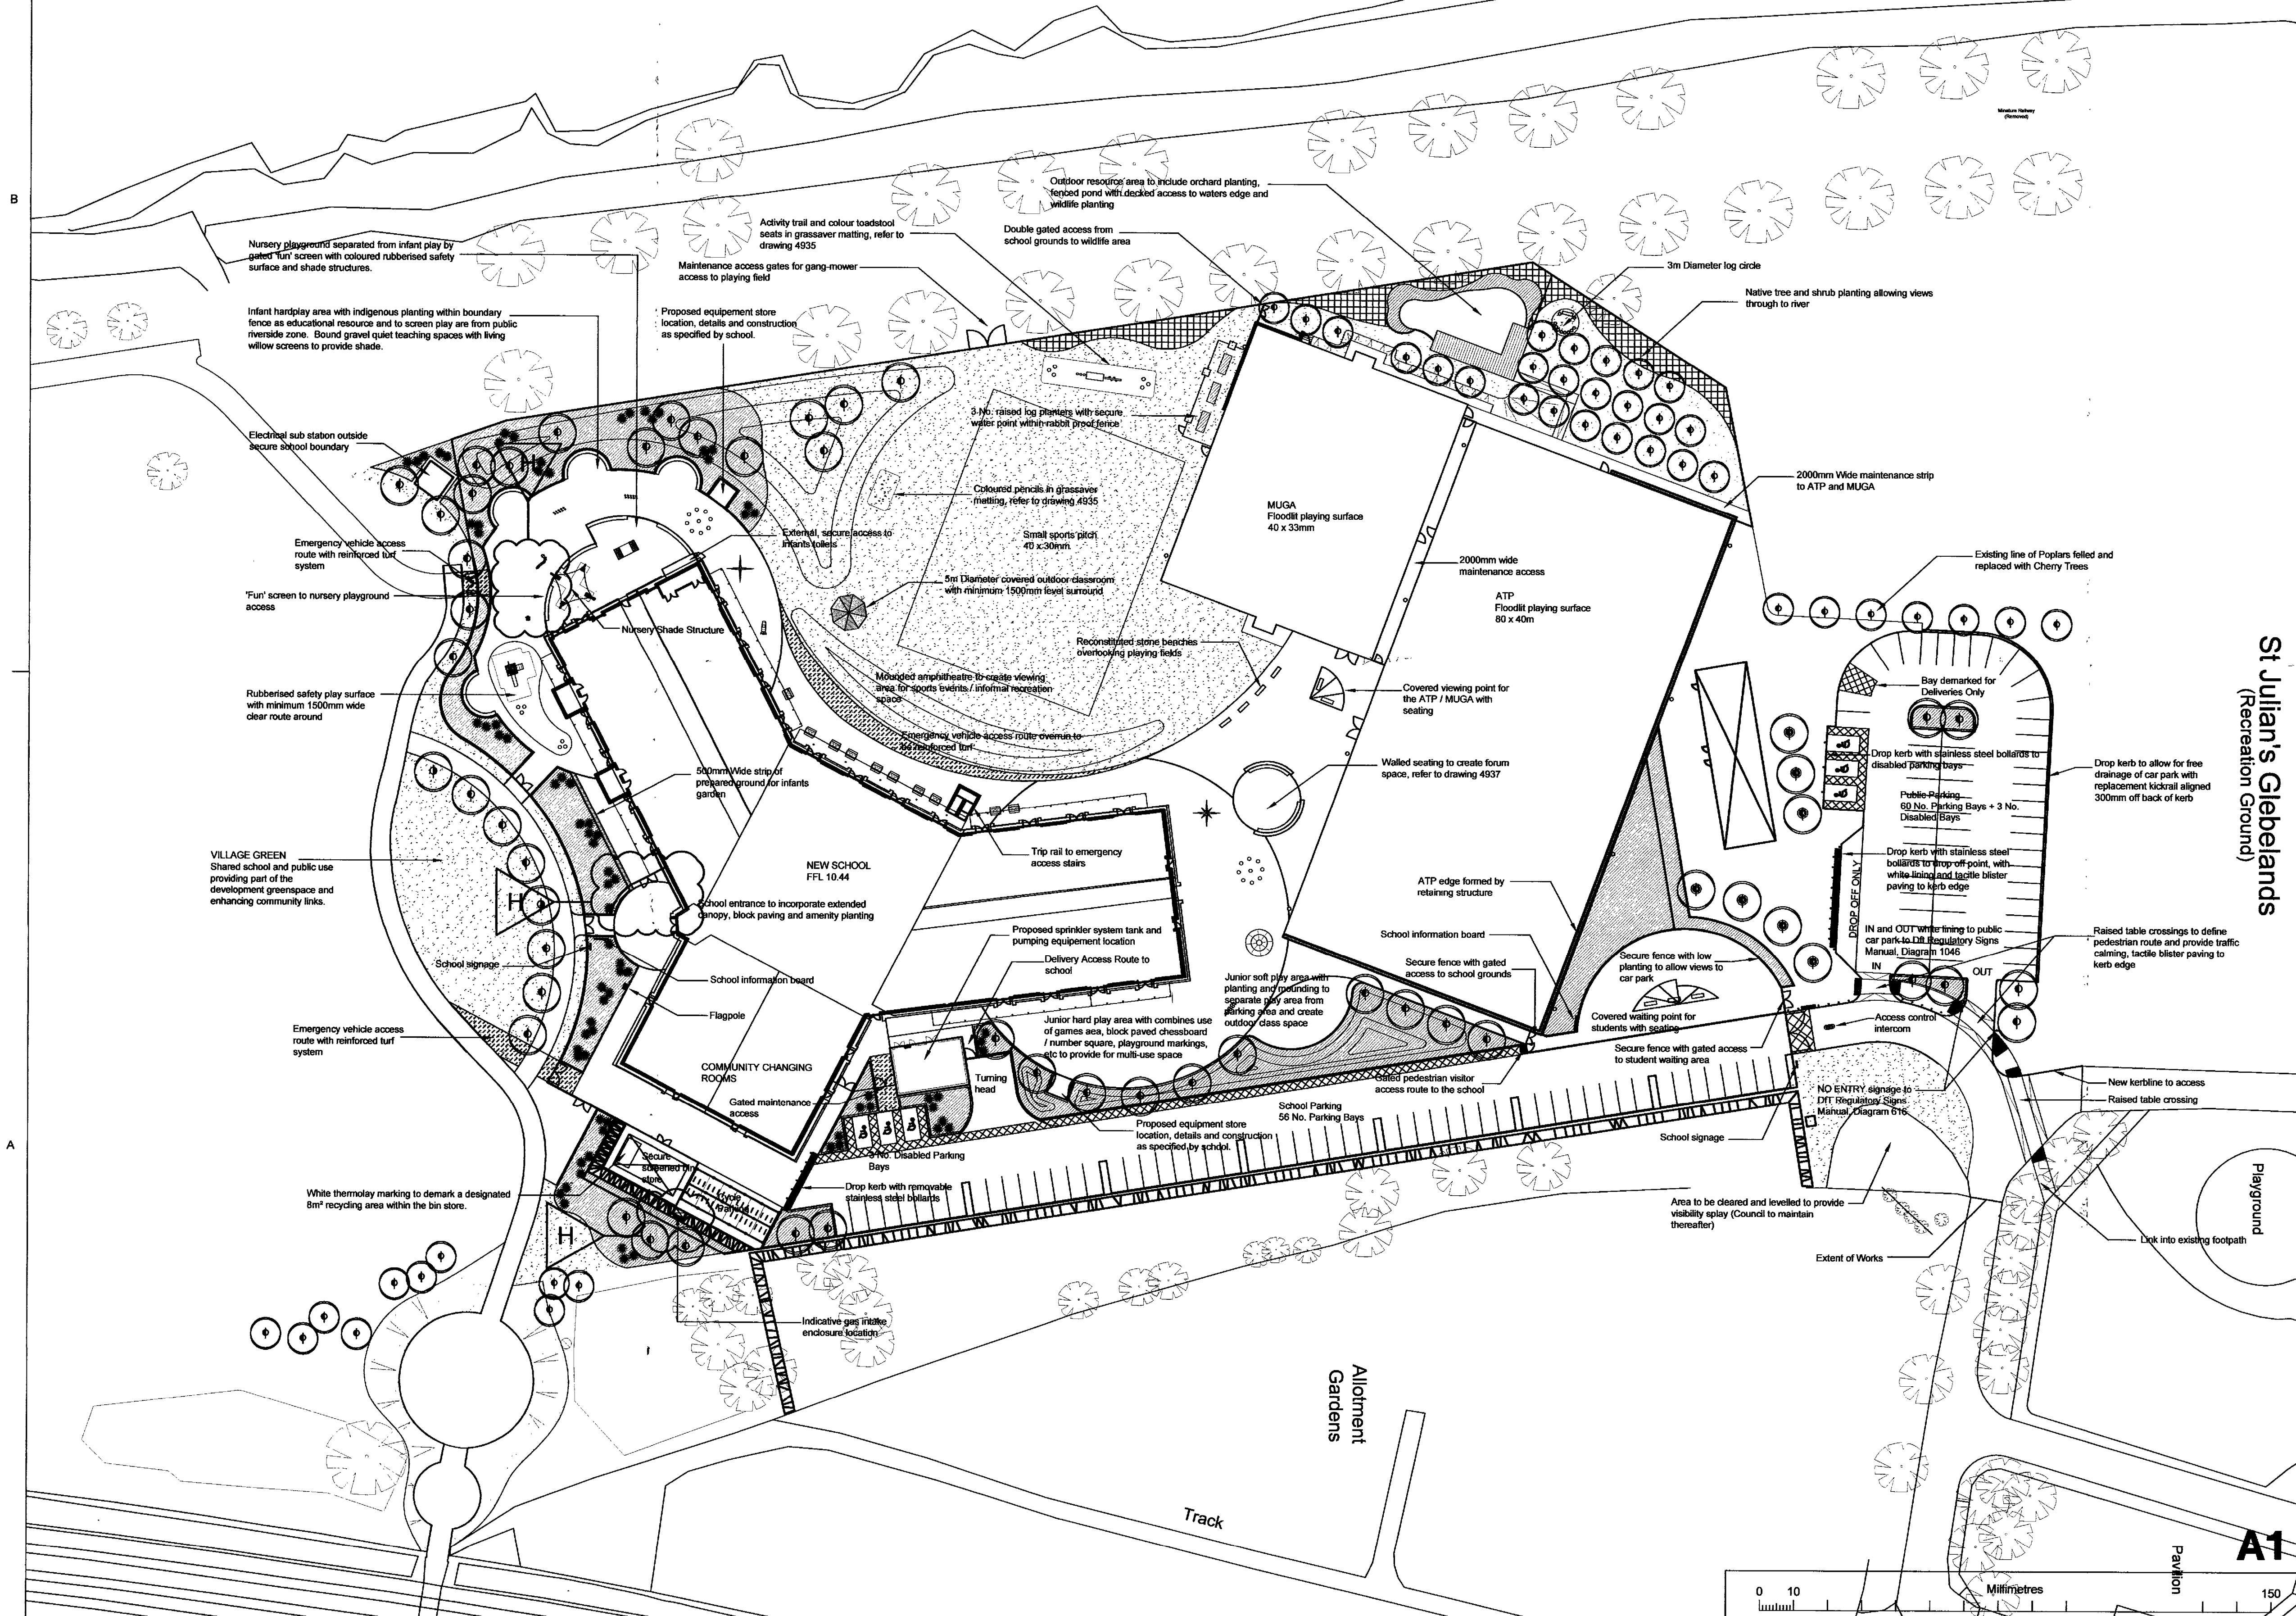

St Julian's Glebelands
(Recreation Ground)

Playground

Pavilion

A1

