



Location Plan
Scale 1:100

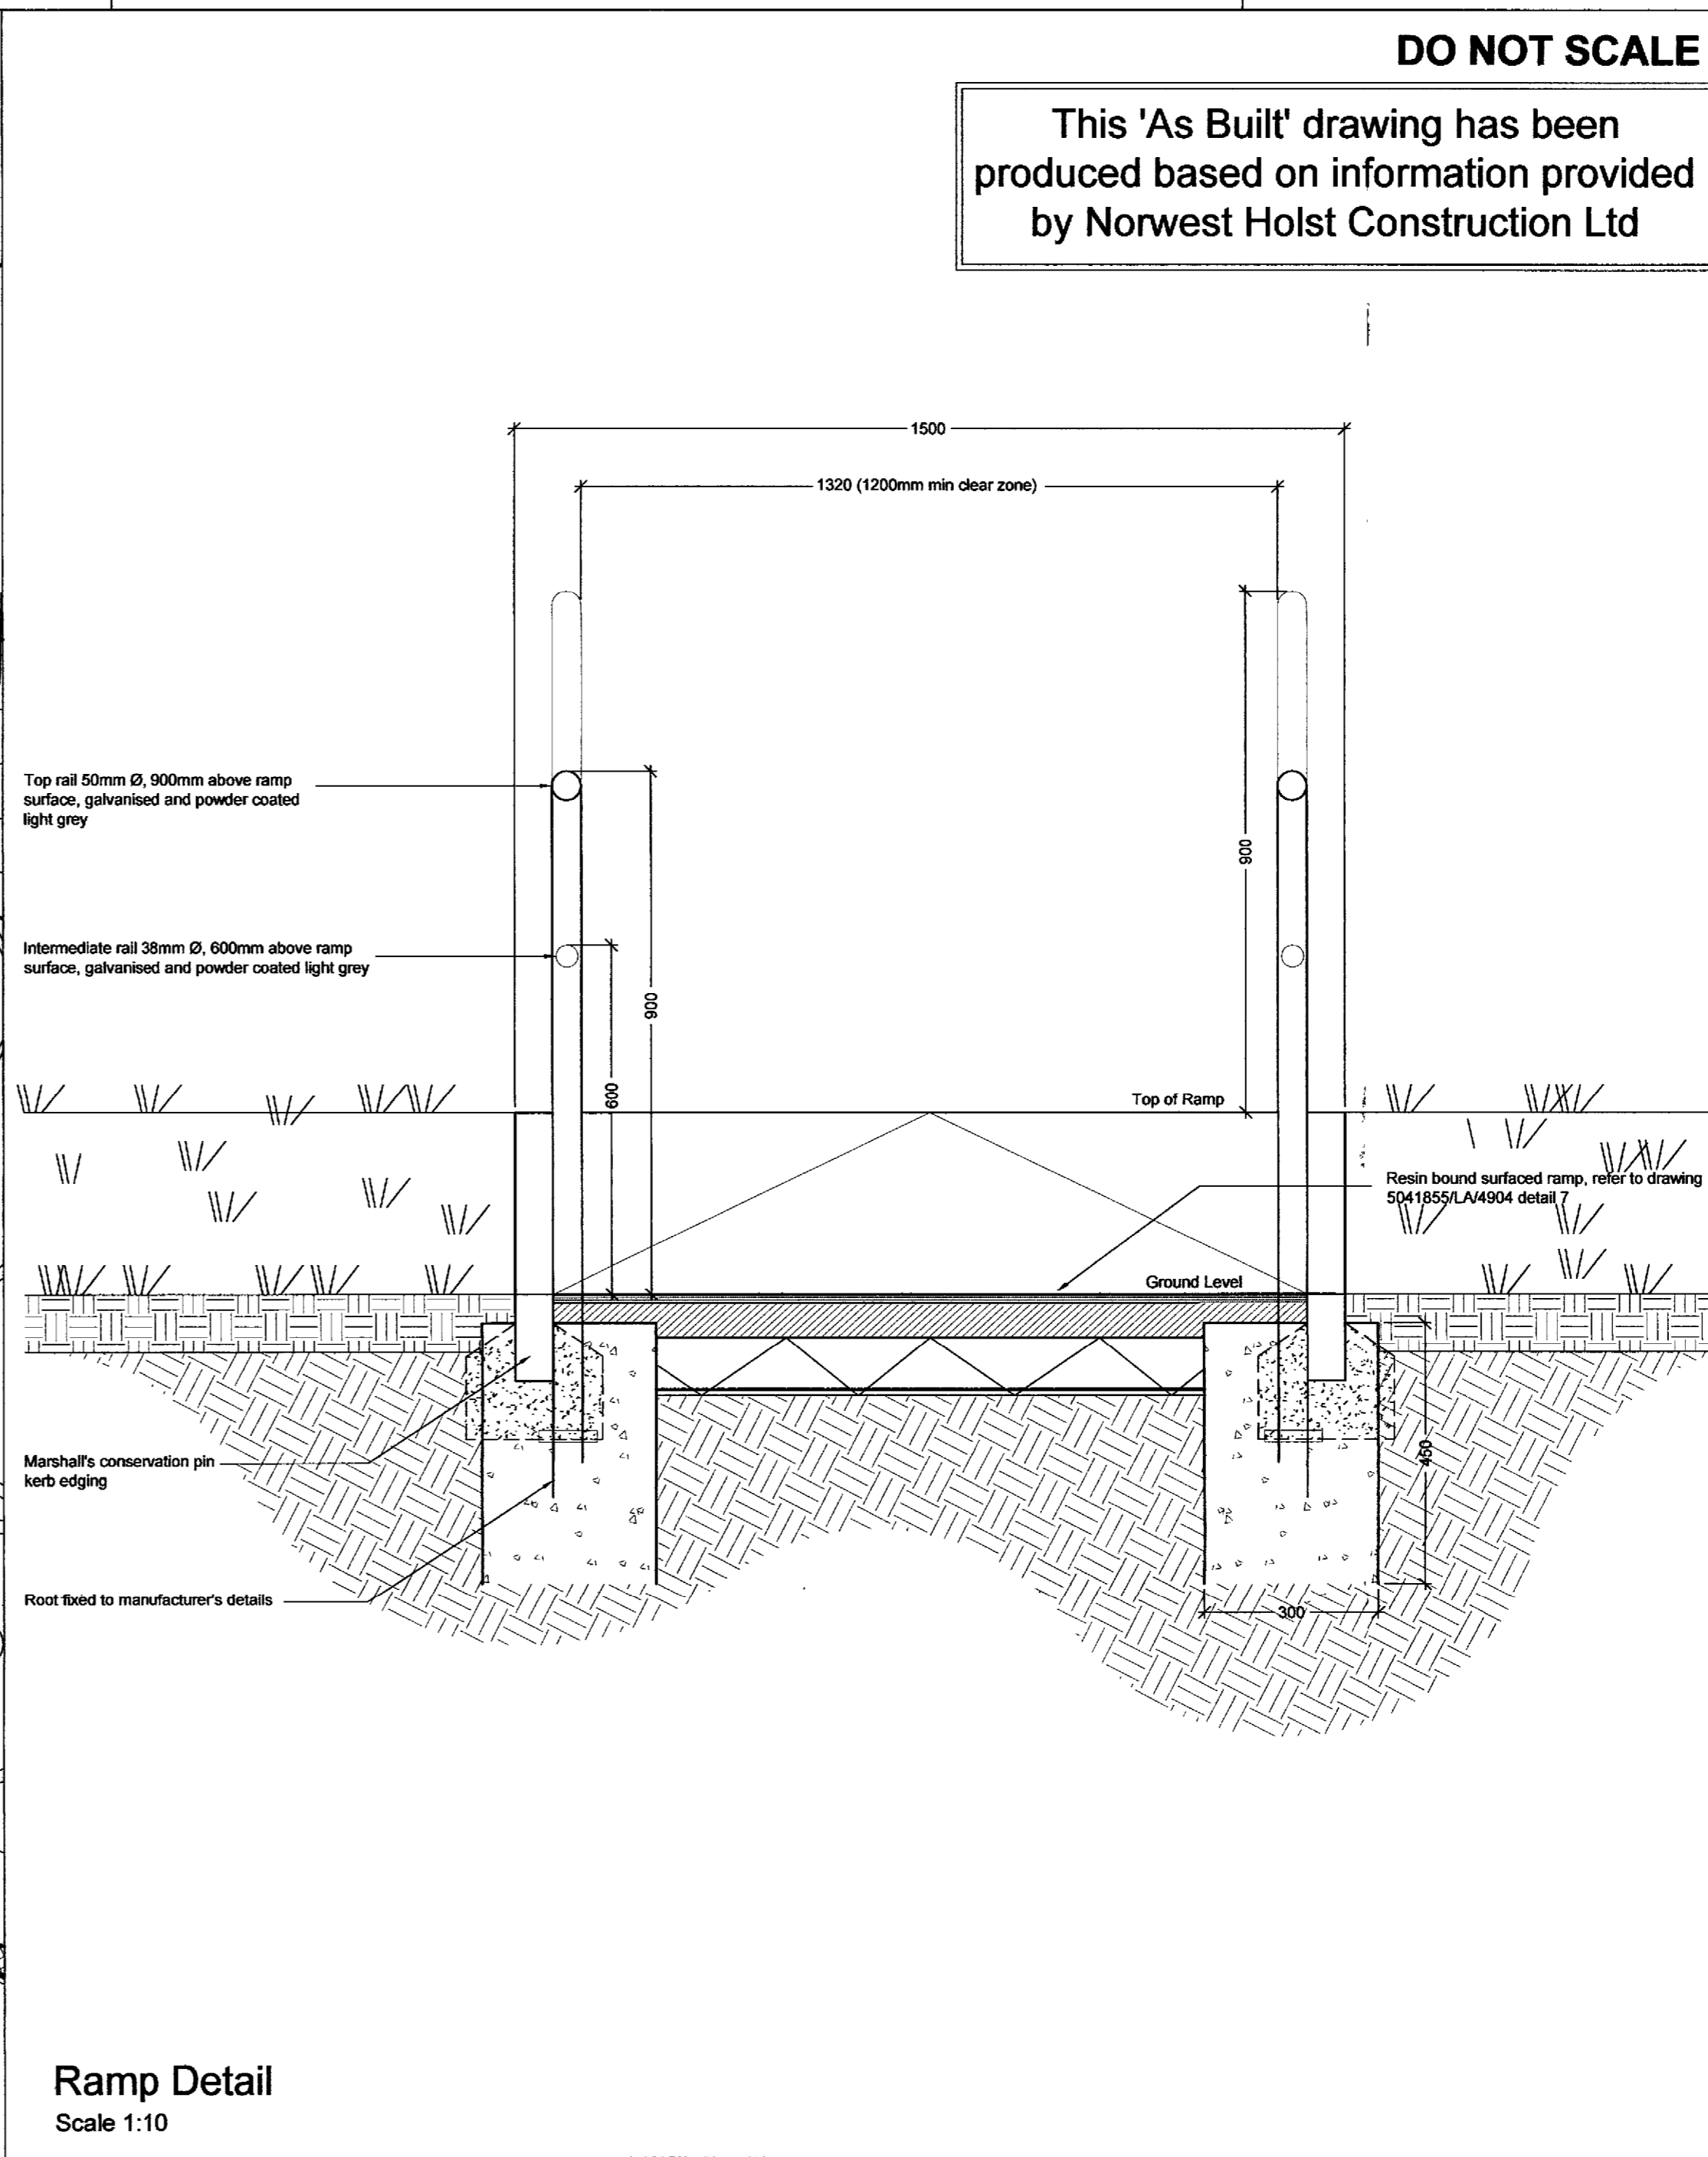

Ramp Detail
Scale 1:10

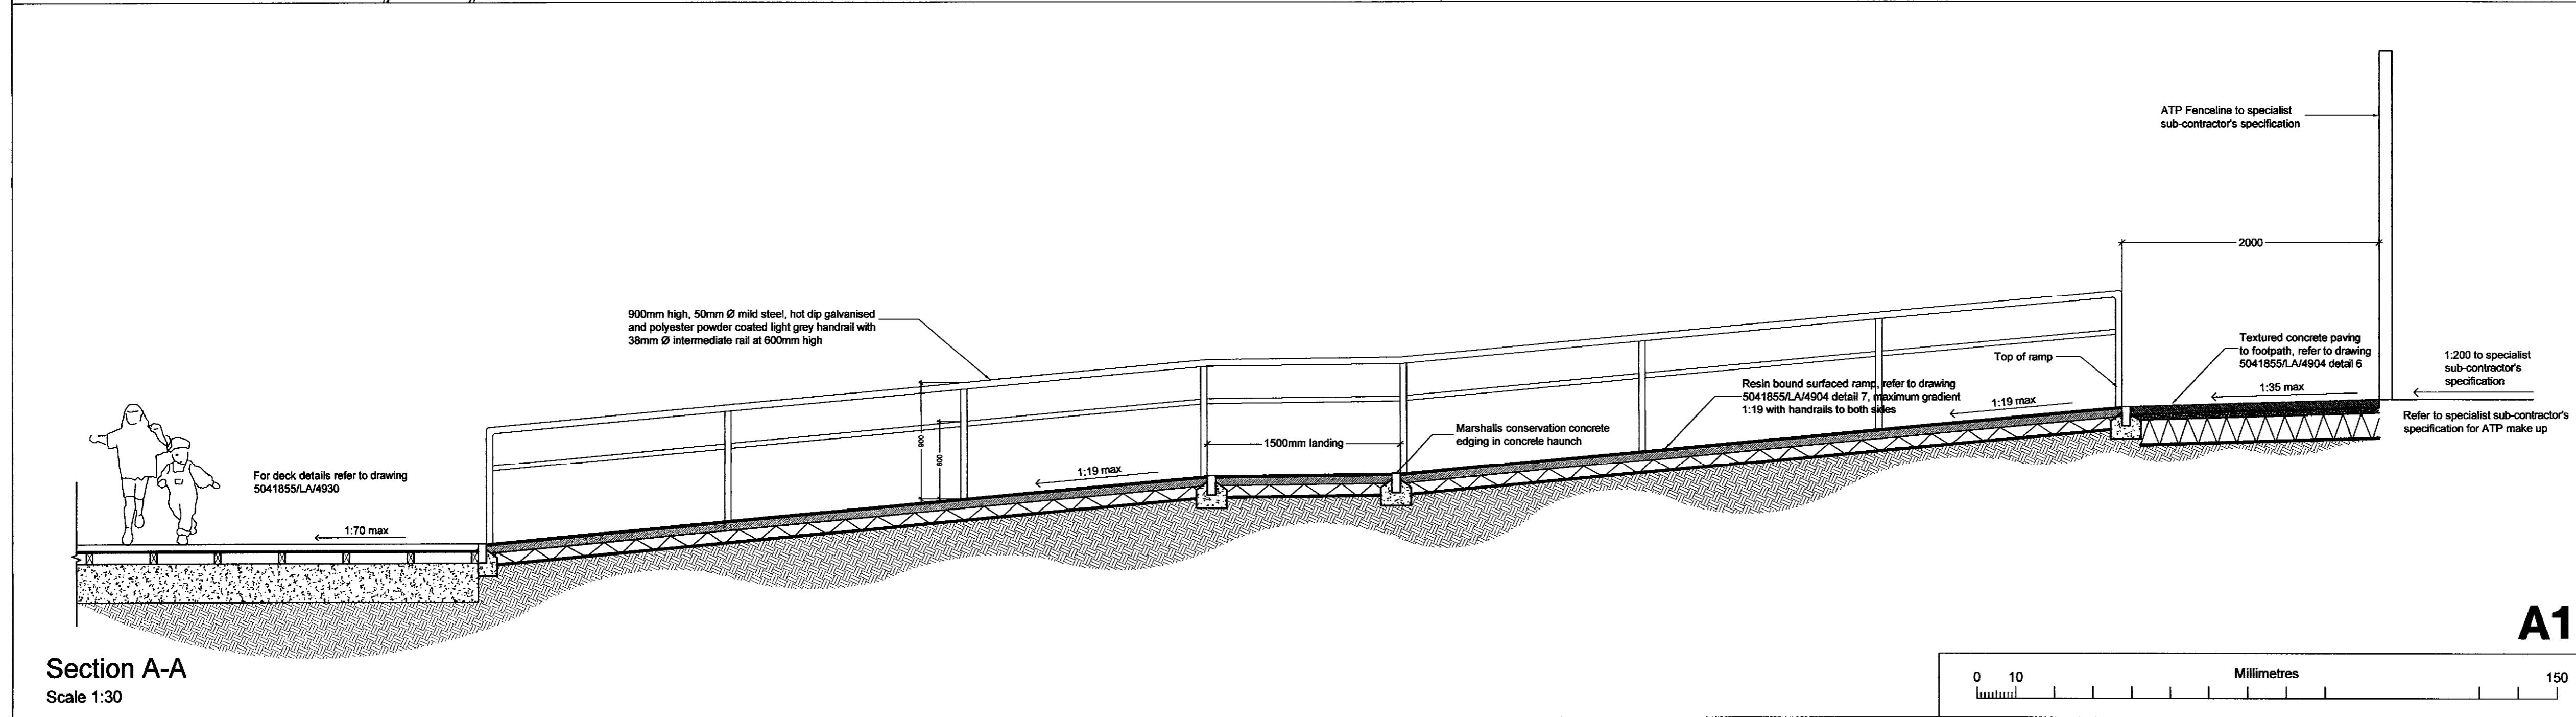

Section A-A
Scale 1:30

DO NOT SCALE

This 'As Built' drawing has been produced based on information provided by Norwest Holst Construction Ltd

ATKINS

NOTE:
Plan issued for comment only; issue not for construction
Care to be taken where working in vicinity of As Built trees to avoid damage to root ball.
Ramp gradient to be confirmed on site to tie in with As Built trees.

Rev	Description	By	Date	CHK'd	Auth
E	AS BUILT ISSUE	AL	28/10/09	NR	NR
D	Log circle amended as per Authority's instruction	AL	07/06/09	NR	NR
C	Ramp arrangement amended to suite As Built tree locations. Proposed Log Circle location added.	AL	10/05/09	MD	MD
A	Ramp arrangement amended to suite As Built pitch levels	AL	07/04/09	-	-

Rev	Purpose of Issue	Date	Authorised
E	AS BUILT	28/10/09	NR
D	INFORMATION	07/06/09	NR
C	FOR COMMENT	10/05/09	MD
B	PLANNING	29/05/09	NR
A	FOR COMMENT	07/04/09	COMMENT
O	FOR COMMENT	06/03/09	NR



WS Atkins Consultants Limited
Design, Environment & Engineering
160 Aztec West, Almondsbury, Bristol BS32 4TU.
Tel. 01454 201400 / Fax. 01454 201568

Project
Glebelands Development
St Julians
Newport

Title
Glan Usk School
AS BUILT
Outdoor Resource Area Ramp Details

Original Scale	Drawn	Checked	Authorised
Var.	AHL	NR	NR
Date	06/03/09	Date	06/03/09
Date	06/03/09	Date	06/03/09

Drawing Number	Rev
5041855 / LA / 4932	E

A1