



DO NOT SCALE

**ATKINS**


This 'As Built' drawing has been produced based on information provided by Norwest Holst Construction Ltd

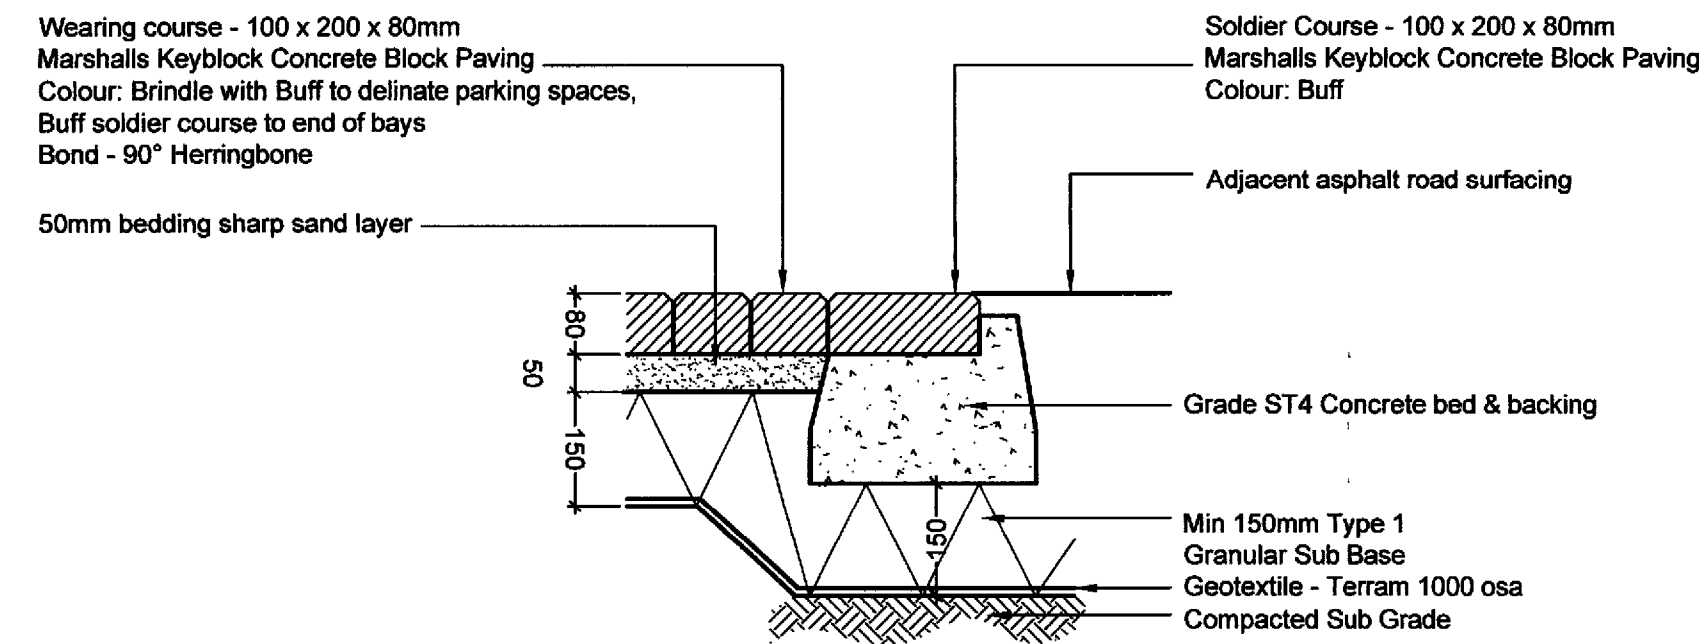


**DETAIL 1**  
CONCRETE BLOCK PAVING - STAFF CAR PARK BAYS with EDGE DETAIL  
Scale 1:10

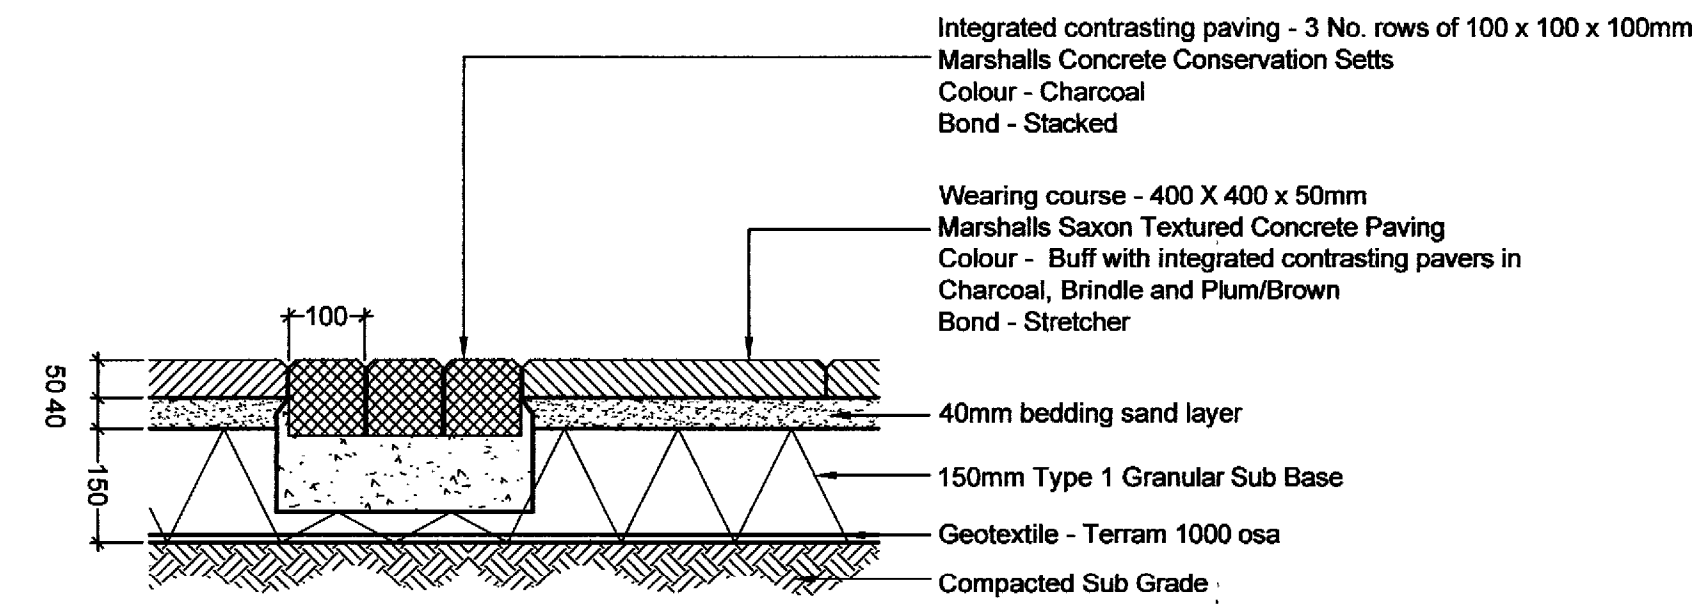


**DETAIL 5**  
TEXTURED CONCRETE PAVING TO PEDESTRIAN AREAS TYPE 1  
Scale 1:10

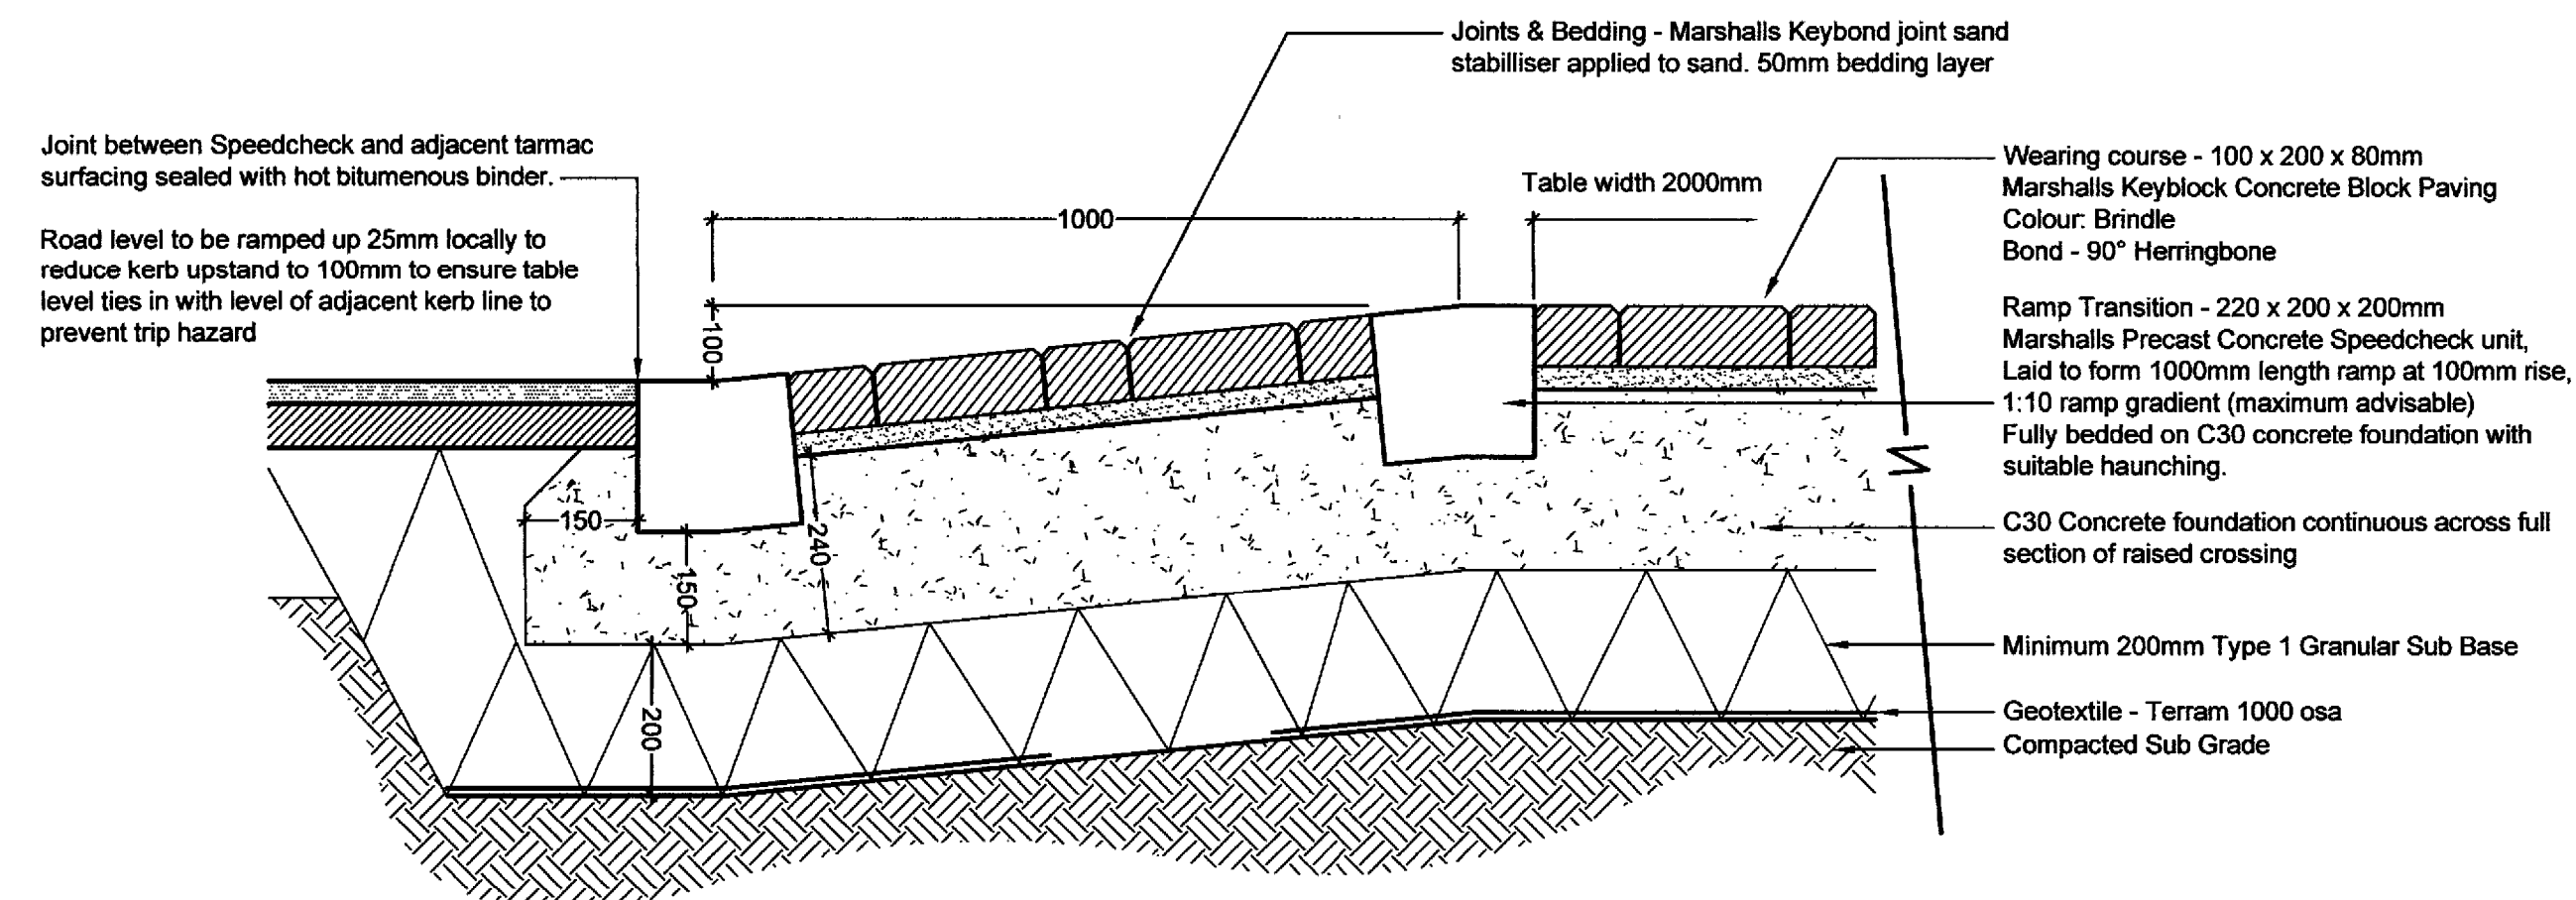


**DETAIL 2**  
RAISED TABLE CROSSING WITH BLOCK PAVING to TARMACADAM ROADWAY  
Scale 1:10

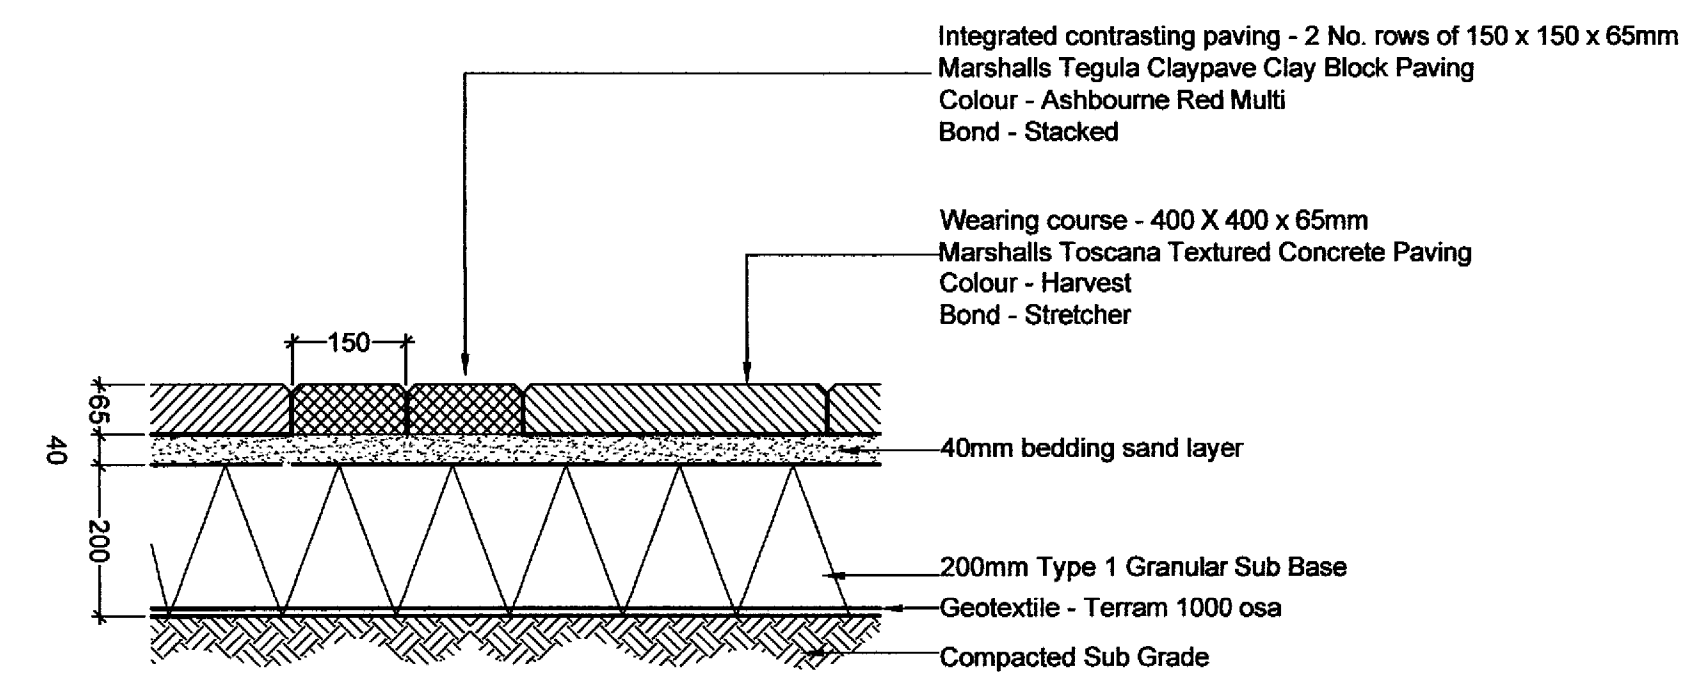


**DETAIL 6**  
TEXTURED CONCRETE PAVING TO PEDESTRIAN AREAS TYPE 2  
Scale 1:10

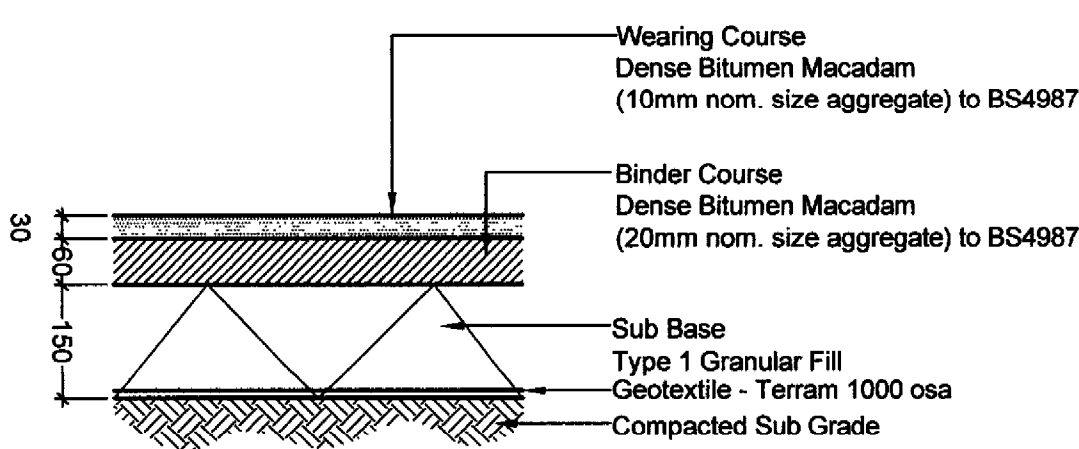


**DETAIL 3**  
MACADAM TO ROADWAYS AND AISLES  
Scale 1:10

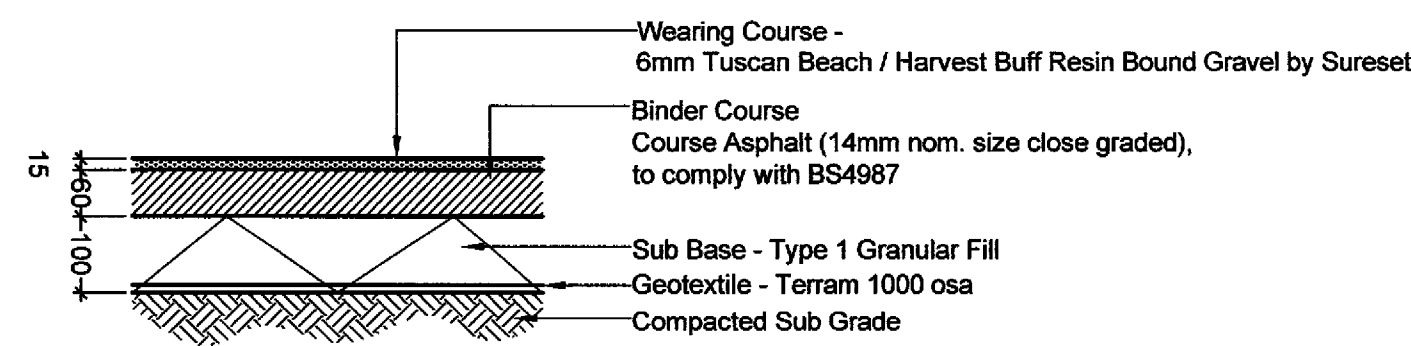


**DETAIL 7**  
RESIN BOUND PAVING TO PEDESTRIAN AREAS  
Scale 1:10

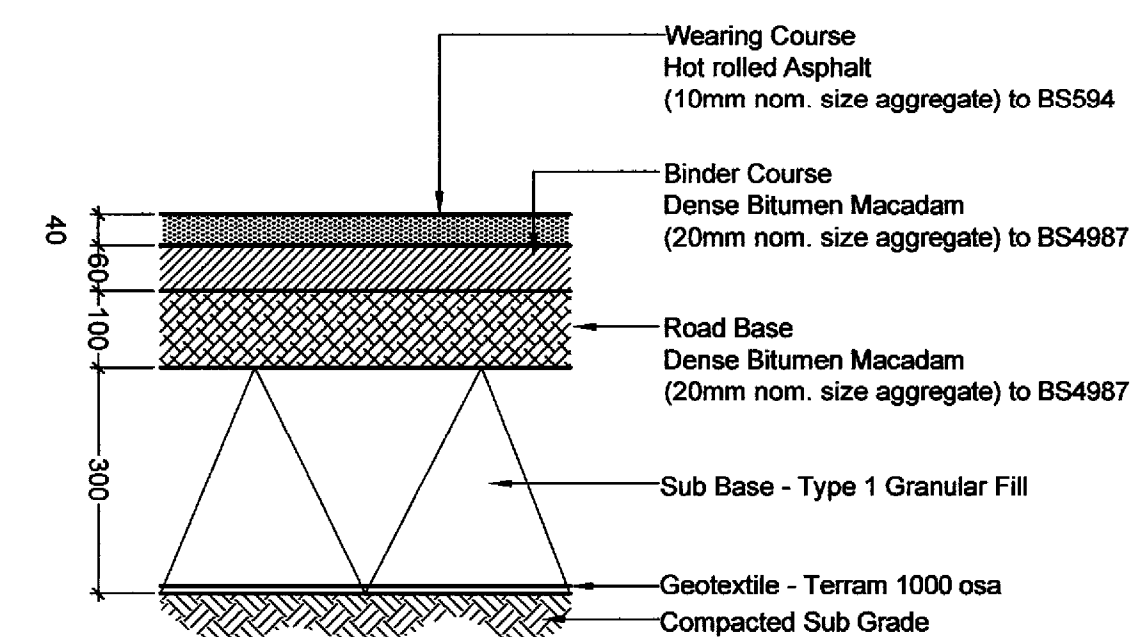

**DETAIL 9**  
MACADAM TO MAIN ACCESS ROADWAYS  
Scale 1:10

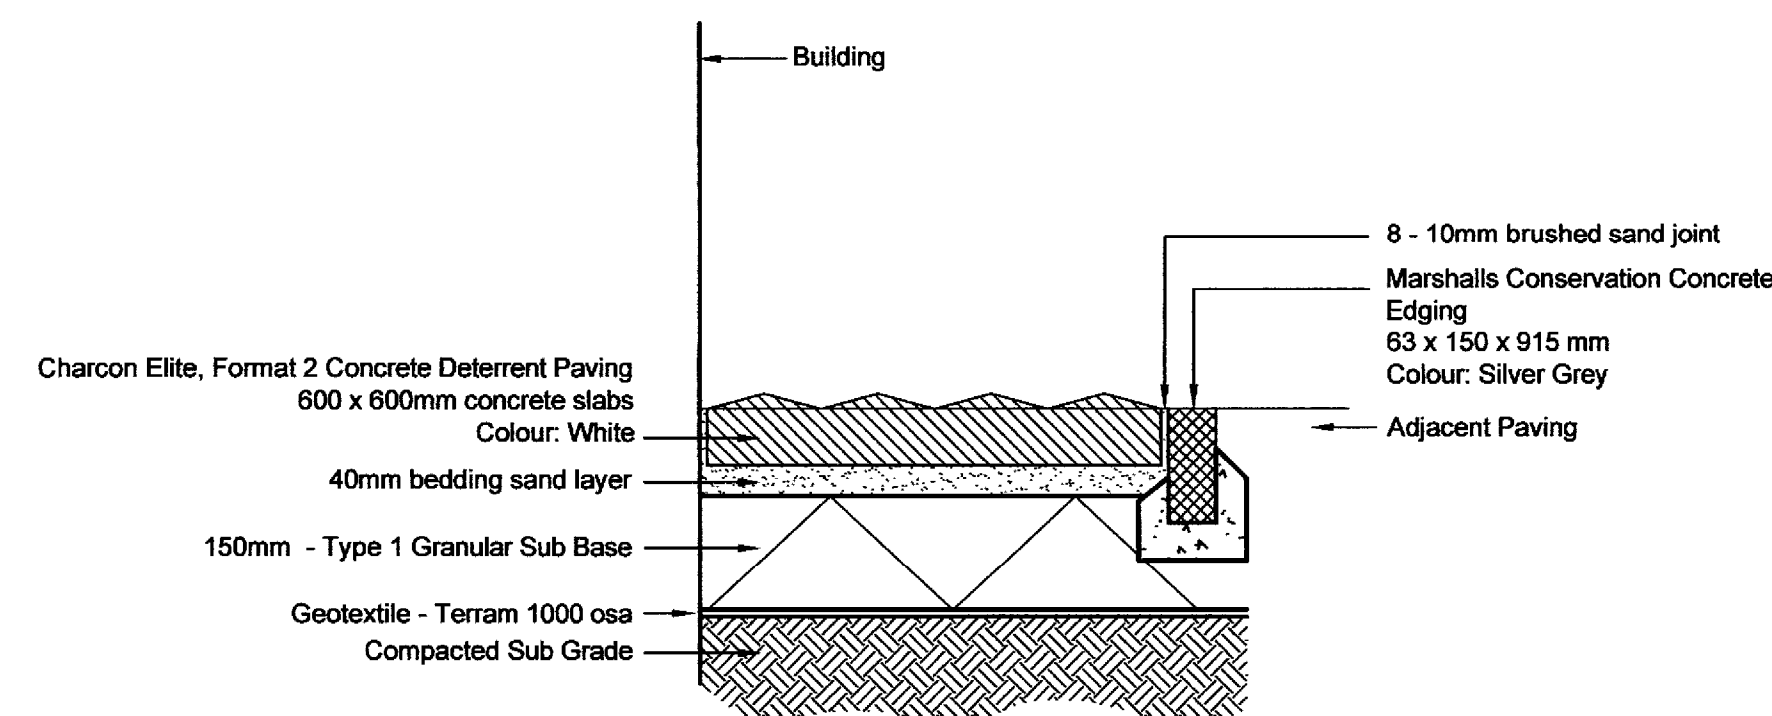

**DETAIL 8**  
CONCRETE PAVING TO BUILDING APRON  
Scale 1:10

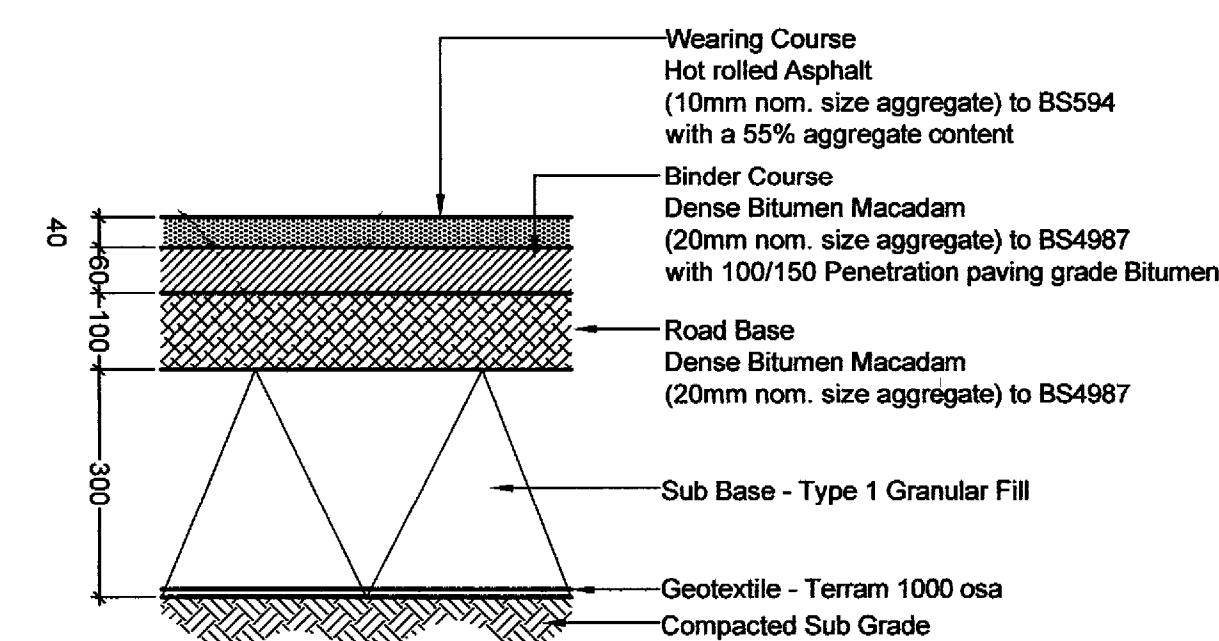

**DETAIL 10**  
MACADAM TO MAIN ACCESS ROADWAYS : HIGH STRESS AREAS  
Scale 1:10

**DETAIL 4**  
OMITTED

Rev.	Description	By	Date	CHK	Auth
F	AS BUILT ISSUE	AL	28/10/09	NR	NR
E	Building apron product amended to Charcon Elite, Format 2. Resin bound product information amended.	AL	04/05/09	MD	MD
D	Concrete slab paving pattern amended to stretcher bond	AL	01/07/09	NR	NR
C	Building Apron detail amended as per Contractor's instruction	OB	22/06/09	MD	MD
B	Contrasting paver detail added to details 5 and 6	AL	25/02/09	NR	NR

Rev.	Purpose of issue	Date	Authorised
F	AS BUILT	28/10/09	NR
E	CONSTRUCTION	04/05/09	MD
D	CONSTRUCTION	01/07/09	NR
C	CONSTRUCTION	22/06/09	MD
B	CONSTRUCTION	25/02/09	NR
A	CONSTRUCTION	20/05/08	MD



**WS Atkins Consultants Limited**  
Design, Environment & Engineering  
160 Aztec West, Almondsbury, Bristol. BS32 4TU.  
Tel. 01454 201400 / Fax. 01454 201568

Project  
Glebelands Development  
St Julians  
Newport

Title  
Glan Usk School  
AS BUILT  
Hardworks Details

Original Scale	Drawn	Checked	Authorised
Var.	AHL	GD	NR
Drawing Number	Date	Date	Date
5041855 / LA /	10/01/06	29/03/06	30/03/06
4904			

**A1**

