



DO NOT SCALE

ATKINS

This 'As Built' drawing has been produced based on information provided by Norwest Holst Construction Ltd

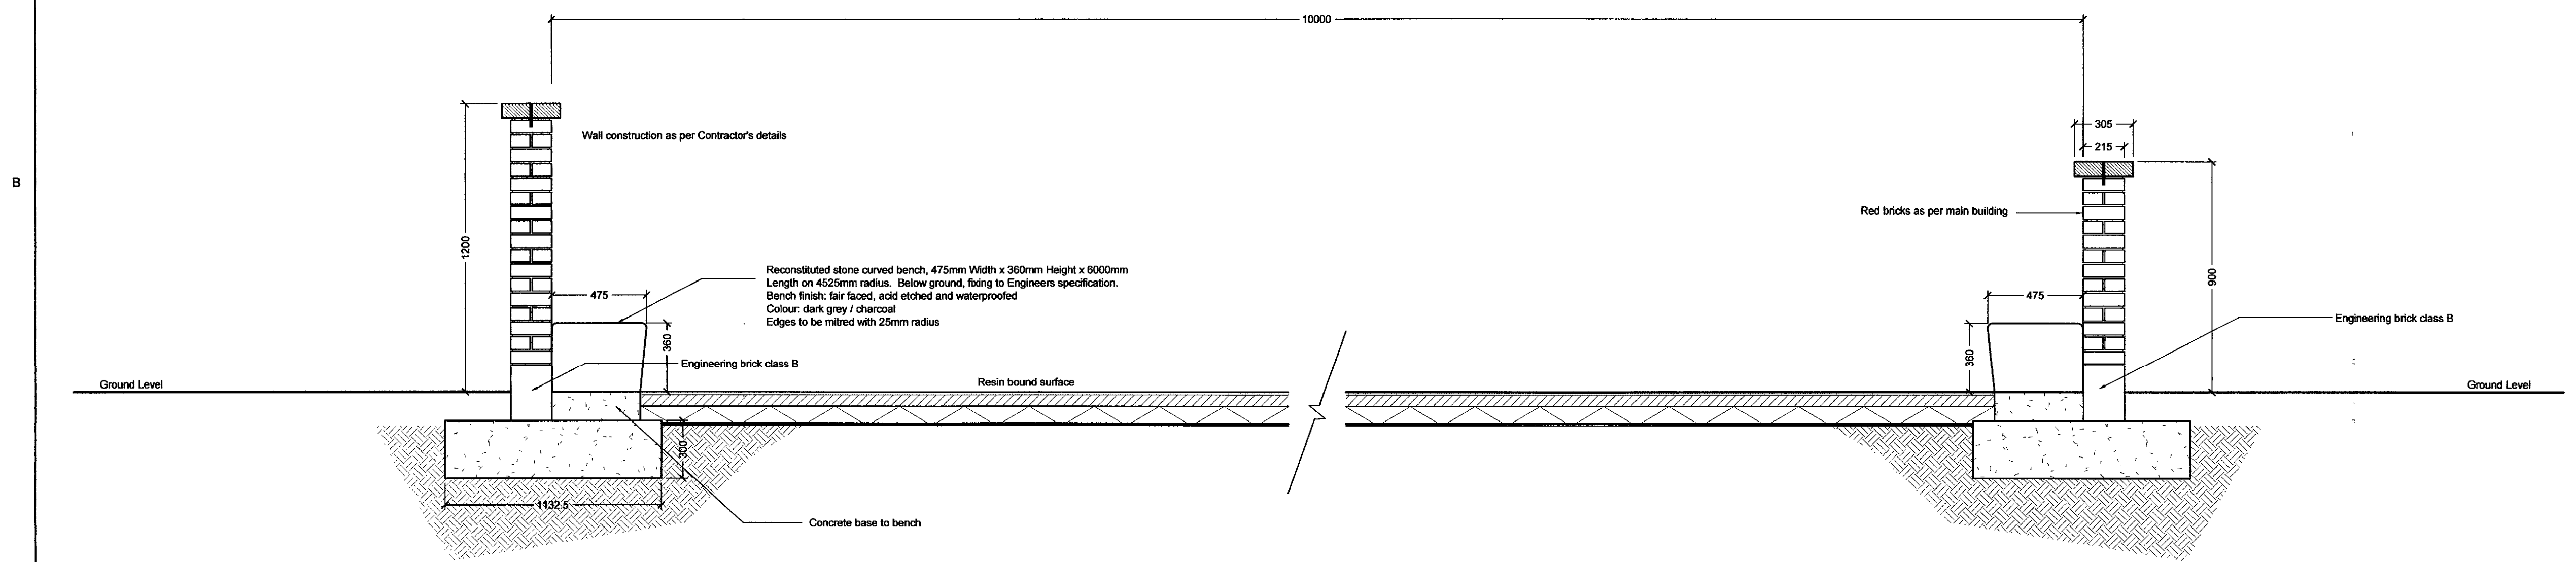

Section through Walled Seating Area
Scale 1:20

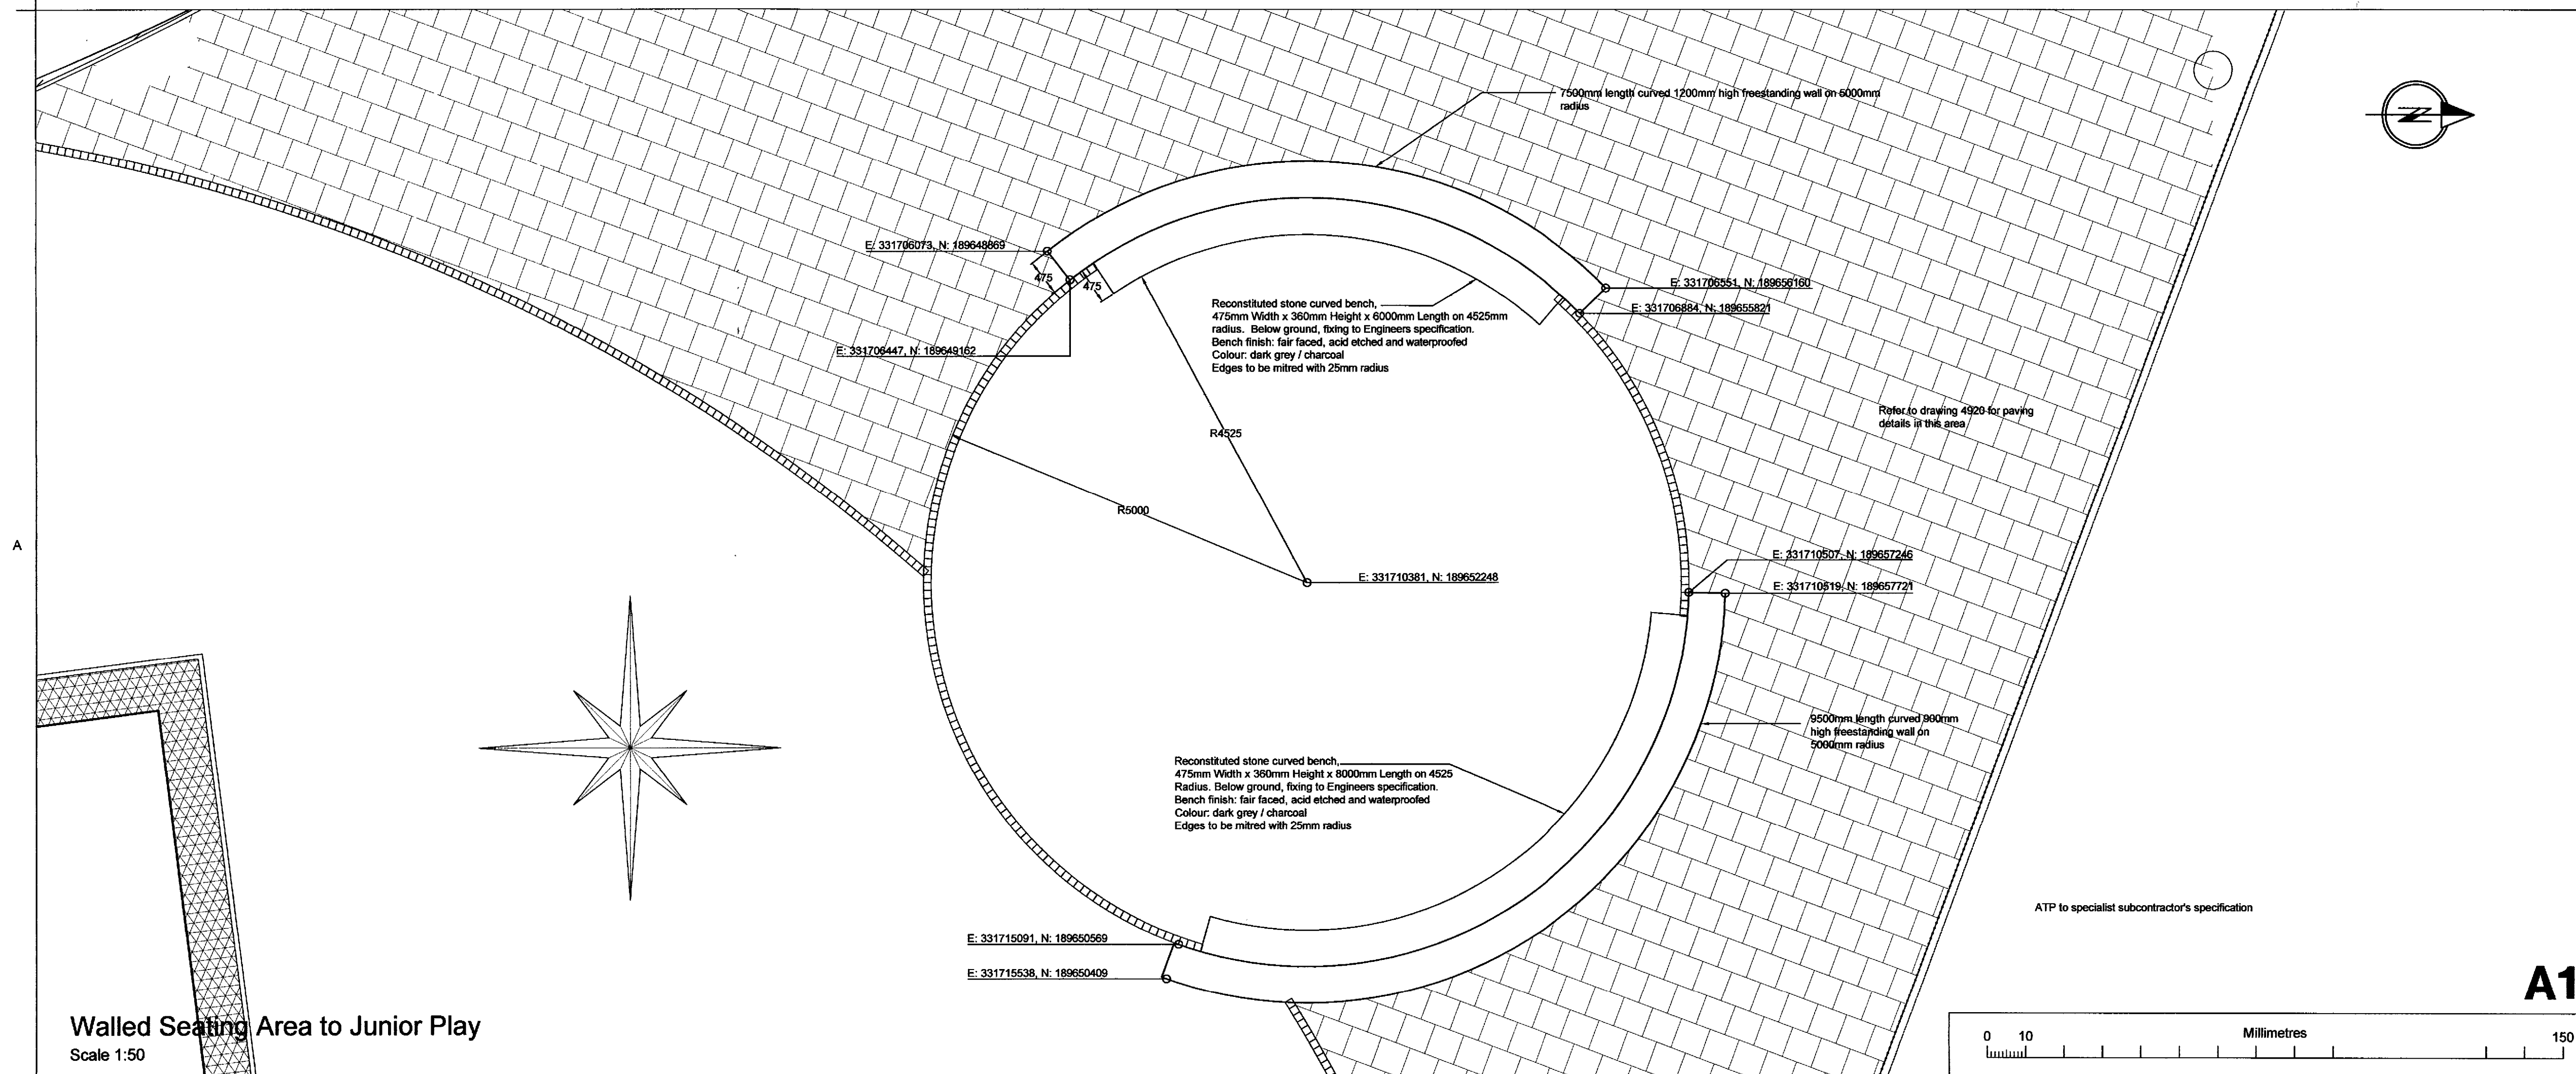

Walled Seating Area to Junior Play
Scale 1:50

Rev.	Description	By	Date	Chk'd	Auth
B	AS BUILT ISSUE	AL	28/10/09	NR	NR
A	Coordinates added to ends of walls	AL	14/07/09	NR	NR

B	AS BUILT	28/10/09	NR
A	CONSTRUCTION	14/07/09	NR
O	CONSTRUCTION	01/07/09	NR

Rev.	Purpose of issue	Date	Authorised
B	AS BUILT	28/10/09	NR
A	CONSTRUCTION	14/07/09	NR
O	CONSTRUCTION	01/07/09	NR

WS Atkins Consultants Limited
Design, Environment & Engineering
160 Aztec West, Almondsbury, Bristol. BS32 4TU.
Tel. 01454 201400 / Fax. 01454 201568

Project
Glebelands Development
St Julians
Newport

Title
Glan Usk School
AS BUILT
Junior Play Area Wall Details

Original Scale	Drawn	Checked	Authorised
Var.	AHL	NR	NR
Date	01/07/09	Date	01/07/09

Drawing Number
5041855 / LA / 4937

Rev
B