

This 'As Built' drawing has been produced based on information provided by Norwest Holst Construction Ltd

River Usk (Afon Wysg)

Hardworks Key

- Parking Bays
Marshalls Keylock
Colour: Brindle, bays delineated by Buff or similar approved
See Drawing 5041855/LA/4904 Detail 1
- Raised Table Crossing
Marshalls Keylock
Colour: Brindle
Or similar approved
See Drawing 5041855/LA/4904 Detail 2
- Access Routes, Aisles and Bays
10mm Stone Mastic Asphalt, Car Parking Bays delineated by thermoplastic white lining
See Drawing 5041855/LA/4904 Detail 3
- Main Access Road
10mm Stone Mastic Asphalt
See Drawing 5041855/LA/4904 Detail 9
- Main Access Road: High Stress Areas
10mm Stone Mastic Asphalt
See Drawing 5041855/LA/4904 Detail 10
- Pedestrian Areas
Marshalls Saxon, 400 x 400 x 50mm concrete slabs
Colour: Buff with integrated contrasting conservation sets in Charcoal
Or similar approved
See Drawing 5041855/LA/4904 Detail 5
- Marshalls Saxon, 400 x 400 x 50mm concrete slabs
Colour: Buff
Or similar approved
See Drawing 5041855/LA/4904 Detail 5
- Marshalls Toscana 400 x 400 x 50mm concrete slabs
Colour: Harvest with integrated contrasting Tegula pavers in Ashbourne Red Multi
Or similar approved
See Drawing 5041855/LA/4904 Detail 6
- Resin Bound Gravel
Colour: 6mm Tuscan Beach
Suset or similar approved
See Drawing 5041855/LA/4904 Detail 7
- ATP
Synthetic Sports Surface
Sand filled
Colour: Green
- MUGA
Cushioned Acrylic Sports Surface
Colour: Red
- Infants / Nursery Enclosure
Rubberised Safety Play Surface
Colour: Red
- Hardplay / Breakout Space
Dark Red Asphalt
- Building Apron
Charcon Elite, Format 2 Concrete Deterrent Paving
600 x 600mm concrete slabs
Colour: White
- Emergency Vehicle Access
Nelson Advanced Turf
Mesh reinforced turf system
- 200mm Thick Concrete Slab Grade C40.
With infill mesh (Allow: 25kg/m²)

DO NOT SCALE


- Resin Bound Gravel
Colour: 6mm Harvest Buff
Suset or similar approved
See Drawing 5041855/LA/4904 Detail 7

ATKINS

K

*** Emergency Vehicle Access**
Bodipave interlocking cellular paving system with grass filled surface

* Denotes - Refer to Manufacturers Details

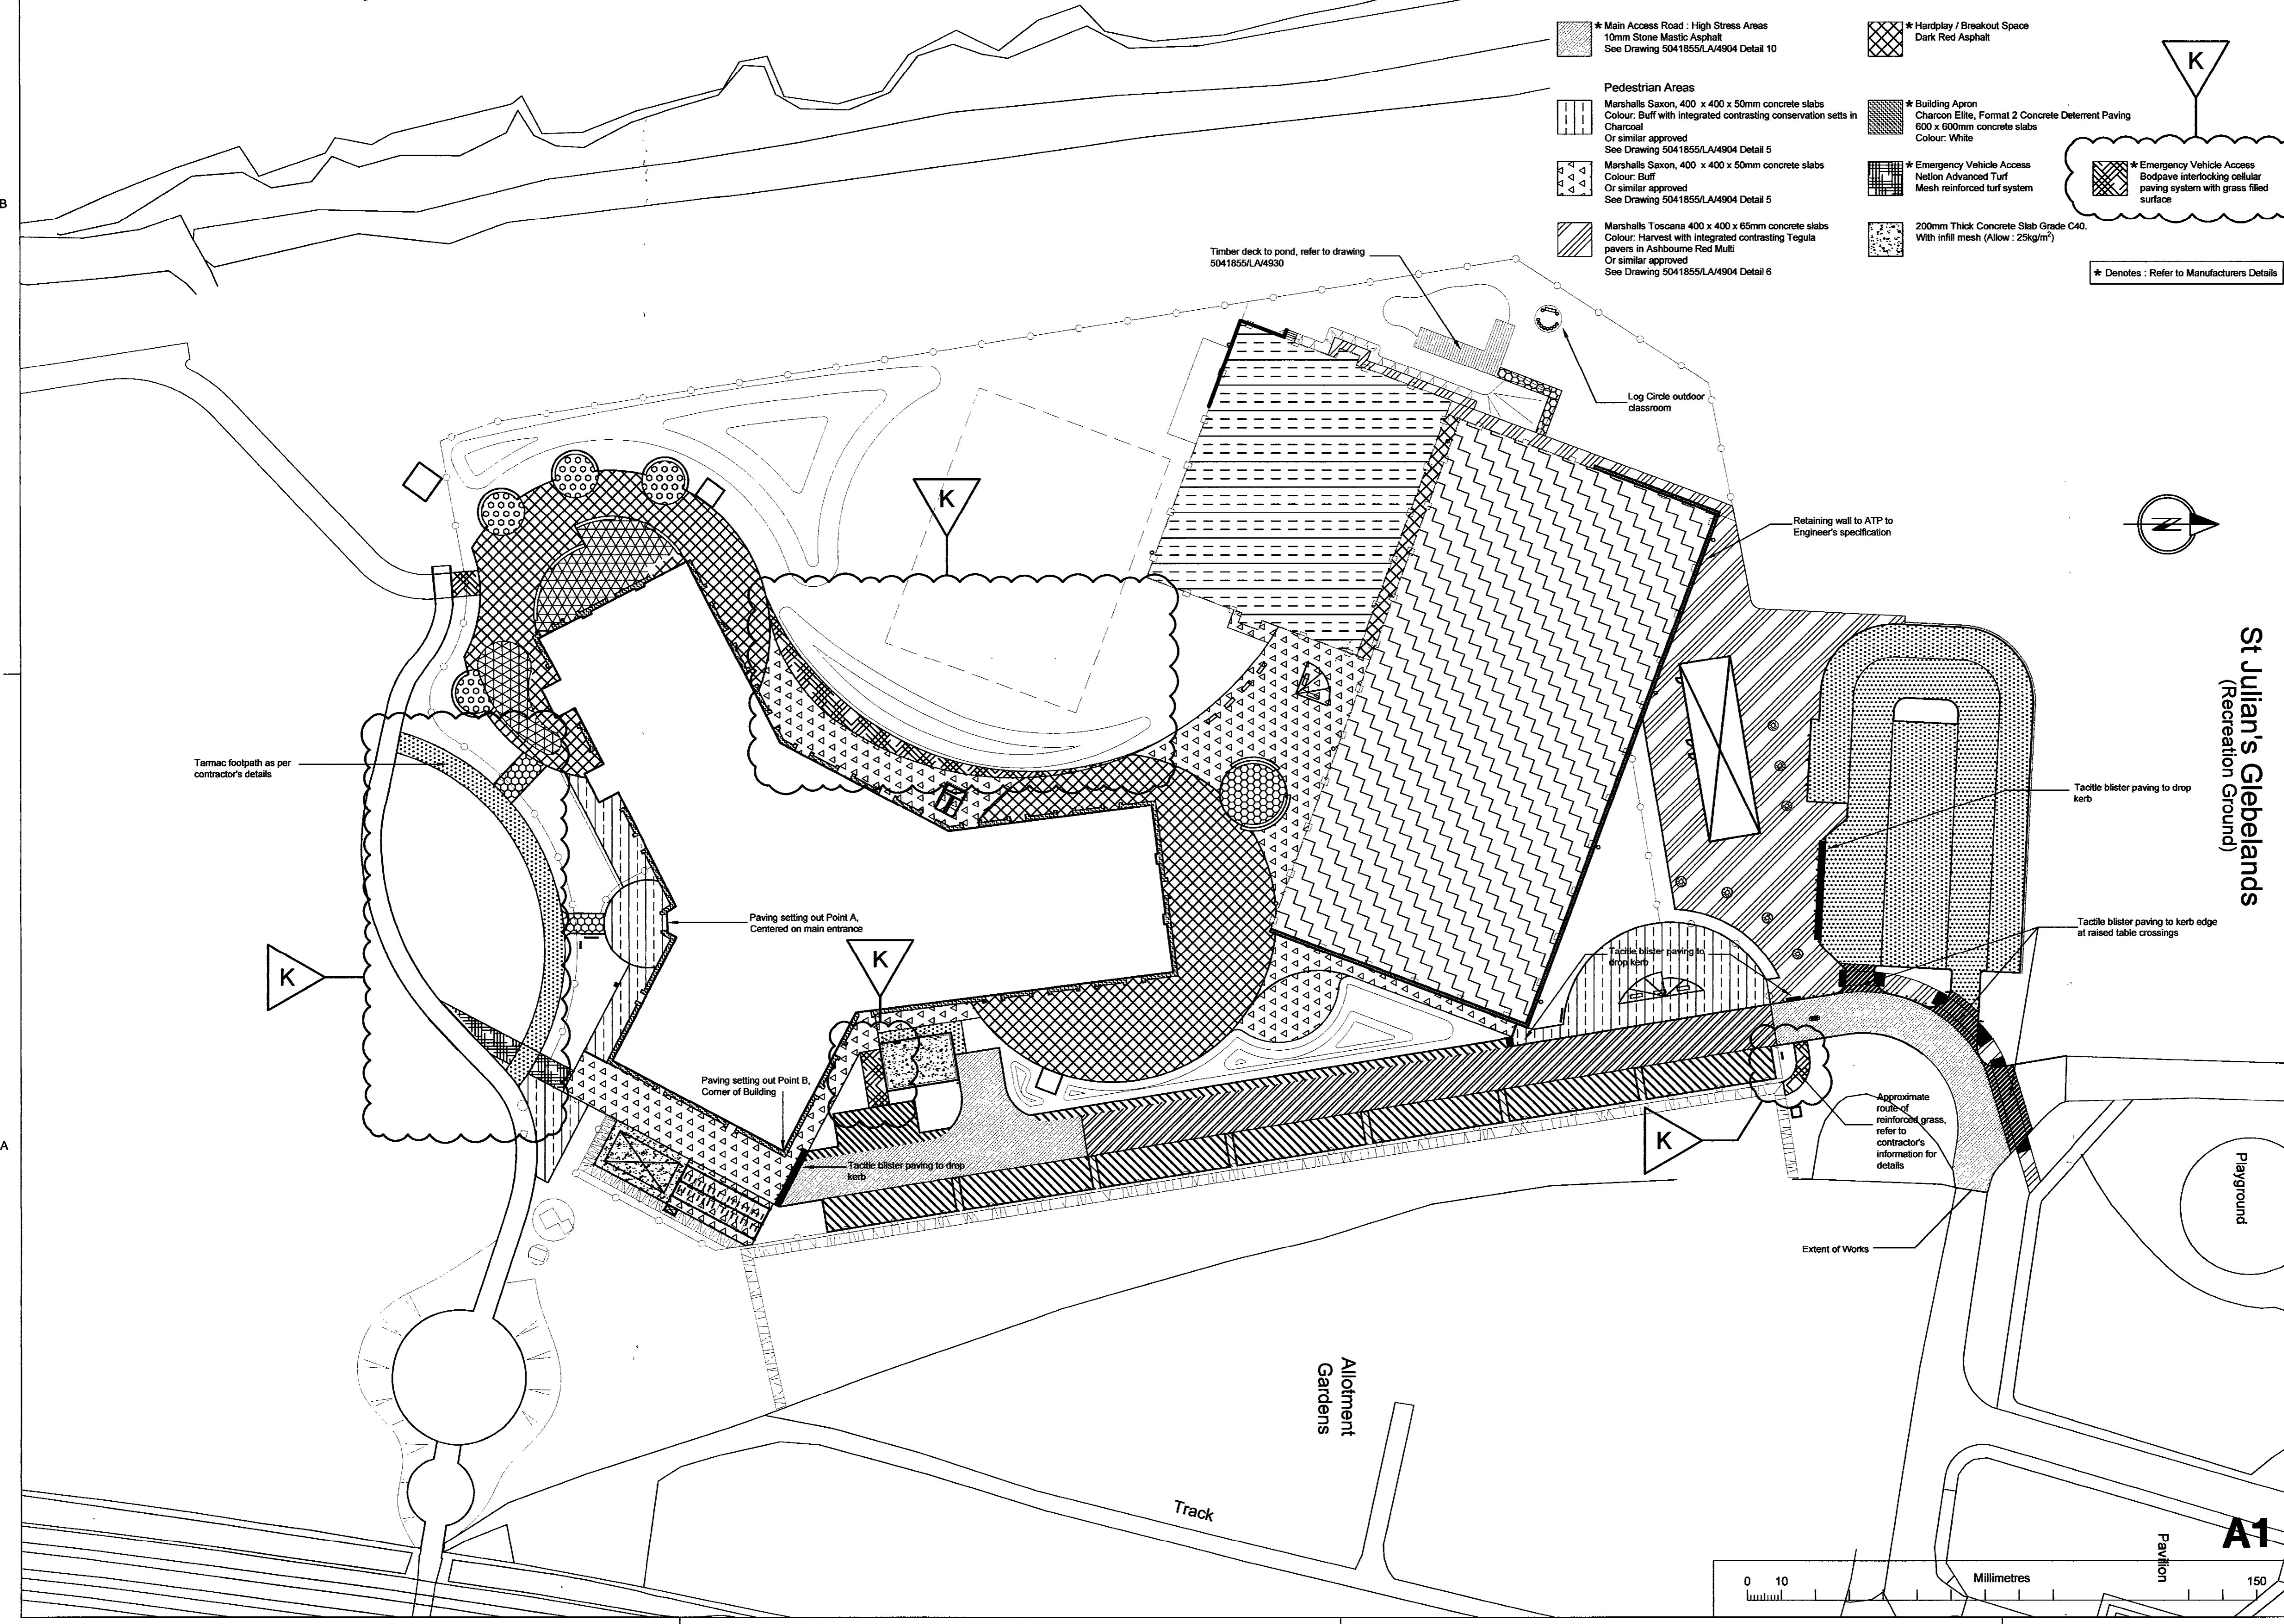

AS BUILT ISSUE
Amendments to as built conditions: Reinforced grass amended for change to Bodipave cellular system

Rev.	Description	By	Date	CHK'd	Auth
K	AS BUILT		28/10/09		NR
J	CONSTRUCTION		28/06/09		MD
I	CONSTRUCTION		04/08/09		MD
H	CONSTRUCTION		01/07/09		NR
G	CONSTRUCTION		22/06/09		MD
F	PLANNING		28/05/09		NR
E	CONSTRUCTION		25/03/09		MD
D	CONSTRUCTION		26/02/09		NR

Notes:
 J Paving layout updated to revised cycle store area. Deterrent paving amended at emergency steps to allow DDA circulation around building. Tarmac surfaces amended to SMA as per manufacturer's recommendations.
 I Resin bound product information added for infants play surface to bin store amended to concrete, rubberised play surface colour amended to red as per Authority's instruction.
 H Car park islands to be block paved as per parking bays.
 G Building apron amended as per Contractor's instruction.
 E Contrasting conservation sets omitting from slab paving to playground, key updated.
 D Notes updated.
 C Paving updated to revised Sprinkler building location. Paving areas amended in accordance with technical queries 22 and 23. School access to Charwood underpass amended as per revised layout.



WS Atkins Consultants Limited
 Design, Environment & Engineering
 160 Aztec West, Almondsbury, Bristol. BS32 4TU.
 Tel. 01454 201400 / Fax. 01454 201568

Project
 Glebelands Development
 St Julians
 Newport

Title
 Glan Usk School
 AS BUILT
 General Hardworks Plan

Original Scale	Drawn	Checked	Authorised
1:500	AHL	NR	NR
Drawing Number	Date	Date	Date
5041855 / LA / 4903	10/01/06	07/02/06	07/02/06

Rev
K