



- Notes
- 1- All work is to be carried out the requirements, to the satisfaction of the Local Authorities. These drawings are for planing purposes only.
 - 2- Responsibility is not accepted for errors made by others in scaling from this drawing. All construction information should be cross checked on the site.
 - 3- All discrepancies and change of design requests by authorities should be reported to surveyor immediately.
 - 4- All drawings to be read in conjunction with the project specification with all works carried out in accordance with the latest British Standards and codes of practice. Planning drawings are not to be used for the purpose of building & installation regulations.
 - 5-It is assumed that all works will be carried out by a competent contractor working, where appropriate, to an approved method statement.
 - 6-It is contractor's responsibility to notify the Building Control and get approval before any work commences.
 - 7- It is contractors responsibility to determine if any wall is load-bearing.
 - 8-Dimensions are based on information provided and existing records.
 - 9-All dimensions are in millimeters.
 - 10-The copyright of this drawing belongs to Se & Se Consultancy Ltd.

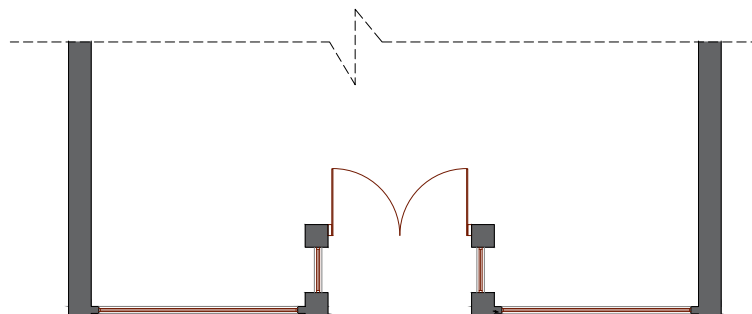


Upper Floors Estimated
Not/Unable To Survey

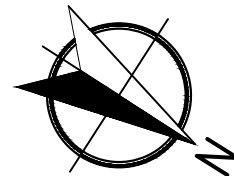



Pre-Existing Front Elevation

1:100 @A4

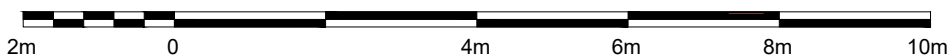

Address 164 Commercial Street, Newport, NP20 1JN.		Rev V4		 Architecture - Town Planning Premises Licensing E: info@seandse.co.uk T: 020 4579 53 00 M: +44 (0) 7404765500 W: www.seandse.co.uk
Sheet 1/8	Name Pre-Existing Front Elevation.	Date 17/11/2025		
Reference 164CS-1711-PEFE		Drawn By MDF	Checked By SS	

- Notes
- 1- All work is to be carried out the requirements, to the satisfaction of the Local Authorities. These drawings are for planing purposes only.
 - 2- Responsibility is not accepted for errors made by others in scaling from this drawing. All construction information should be cross checked on the site.
 - 3- All discrepancies and change of design requests by authorities should be reported to surveyor immediately.
 - 4- All drawings to be read in conjunction with the project specification with all works carried out in accordance with the latest British Standards and codes of practice. Planning drawings are not to be used for the purpose of building & installation regulations.
 - 5-It is assumed that all works will be carried out by a competent contractor working, where appropriate, to an approved method statement.
 - 6-It is contractor's responsibility to notify the Building Control and get approval before any work commences.
 - 7- It is contractors responsibility to determine if any wall is load-bearing.
 - 8-Dimensions are based on information provided and existing records.
 - 9-All dimensions are in millimeters.
 - 10-The copyright of this drawing belongs to Se & Se Consultancy Ltd.

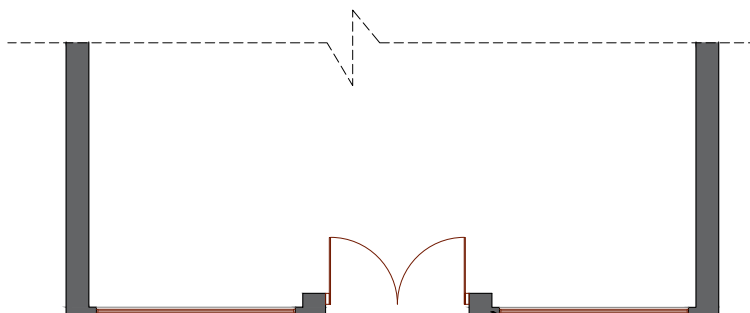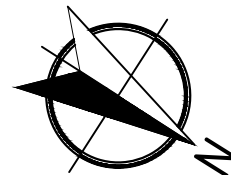



Existing As-built Front Elevation

1:100 @A4



Address 164 Commercial Street, Newport, NP20 1JN.		Rev V4	 Architecture - Town Planning Premises Licensing E: info@seandse.co.uk T: 020 4579 53 00 M: +44 (0) 7404 765500 W: www.seandse.co.uk
Sheet 2/8	Name Existing As-built Front Elevation.	Date 17/11/2025	
Reference 164CS-1711-EFE		Drawn By MDF	
		Checked By SS	

- Notes
- 1- All work is to be carried out the requirements, to the satisfaction of the Local Authorities. These drawings are for planing purposes only.
 - 2- Responsibility is not accepted for errors made by others in scaling from this drawing. All construction information should be cross checked on the site.
 - 3- All discrepancies and change of design requests by authorities should be reported to surveyor immediately.
 - 4- All drawings to be read in conjunction with the project specification with all works carried out in accordance with the latest British Standards and codes of practice. Planning drawings are not to be used for the purpose of building & installation regulations.
 - 5-It is assumed that all works will be carried out by a competent contractor working, where appropriate, to an approved method statement.
 - 6-It is contractor's responsibility to notify the Building Control and get approval before any work commences.
 - 7- It is contractors responsibility to determine if any wall is load-bearing.
 - 8-Dimensions are based on information provided and existing records.
 - 9-All dimensions are in millimeters.
 - 10-The copyright of this drawing belongs to Se & Se Consultancy Ltd.

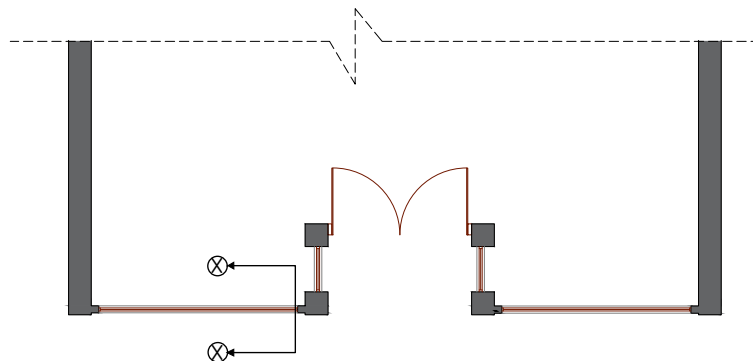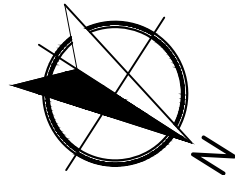


New Fully Retractable Awning
Canopy Concealed Underneath Cornice
not Visible When Retracted.

Proposed Front Elevation
(Awning Open).



Planning Application For Alterations
to Shopfront In Progress

1:100 @A4

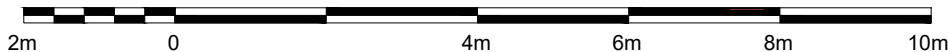

Address 164 Commercial Street, Newport, NP20 1JN.		Rev V4		 Architecture - Town Planning Premises Licensing E: info@seandse.co.uk T: 020 4579 53 00 M: +44 (0) 7404765500 W: www.seandse.co.uk
Sheet 3/8	Name Proposed Front Elevation (Awning Open).	Date 17/11/2025		
Reference 164CS-1711-PFE1		Drawn By MDF	Checked By SS	

- Notes
- 1- All work is to be carried out the requirements, to the satisfaction of the Local Authorities. These drawings are for planing purposes only.
 - 2- Responsibility is not accepted for errors made by others in scaling from this drawing. All construction information should be cross checked on the site.
 - 3- All discrepancies and change of design requests by authorities should be reported to surveyor immediately.
 - 4- All drawings to be read in conjunction with the project specification with all works carried out in accordance with the latest British Standards and codes of practice. Planning drawings are not to be used for the purpose of building & installation regulations.
 - 5-It is assumed that all works will be carried out by a competent contractor working, where appropriate, to an approved method statement.
 - 6-It is contractor's responsibility to notify the Building Control and get approval before any work commences.
 - 7- It is contractors responsibility to determine if any wall is load-bearing.
 - 8-Dimensions are based on information provided and existing records.
 - 9-All dimensions are in millimeters.
 - 10-The copyright of this drawing belongs to Se & Se Consultancy Ltd.

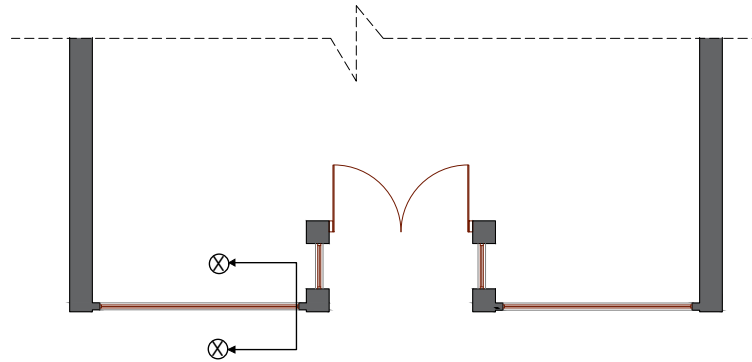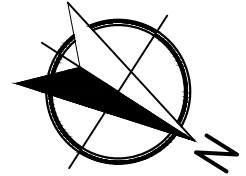

Internally illuminated acrylic box projecting sign.

Internally illuminated white fret-cut acrylic letters.

New Fully Retractable Awning Canopy Concealed Underneath Cornice not Visible When Retracted.

Proposed Front Elevation (Awning Closed).



Planning Application For Alterations
to Shopfront In Progress

1:100 @A4




Address 164 Commercial Street, Newport, NP20 1JN.		Rev V4		 Architecture - Town Planning Premises Licensing E: info@seandse.co.uk T: 020 4579 53 00 M: +44 (0) 7404765500 W: www.seandse.co.uk
Sheet 4/8	Name Proposed Front Elevation (Awning Closed).		Date 17/11/2025	
Reference 164CS-1711-PFE2			Drawn By MDF	


- Notes
- 1- All work is to be carried out the requirements, to the satisfaction of the Local Authorities. These drawings are for planing purposes only.
 - 2- Responsibility is not accepted for errors made by others in scaling from this drawing. All construction information should be cross checked on the site.
 - 3- All discrepancies and change of design requests by authorities should be reported to surveyor immediately.
 - 4- All drawings to be read in conjunction with the project specification with all works carried out in accordance with the latest British Standards and codes of practice. Planning drawings are not to be used for the purpose of building & installation regulations.
 - 5-It is assumed that all works will be carried out by a competent contractor working, where appropriate, to an approved method statement.
 - 6-It is contractor's responsibility to notify the Building Control and get approval before any work commences.
 - 7- It is contractors responsibility to determine if any wall is load-bearing.
 - 8-Dimensions are based on information provided and existing records.
 - 9-All dimensions are in millimeters.
 - 10-The copyright of this drawing belongs to Se & Se Consultancy Ltd.

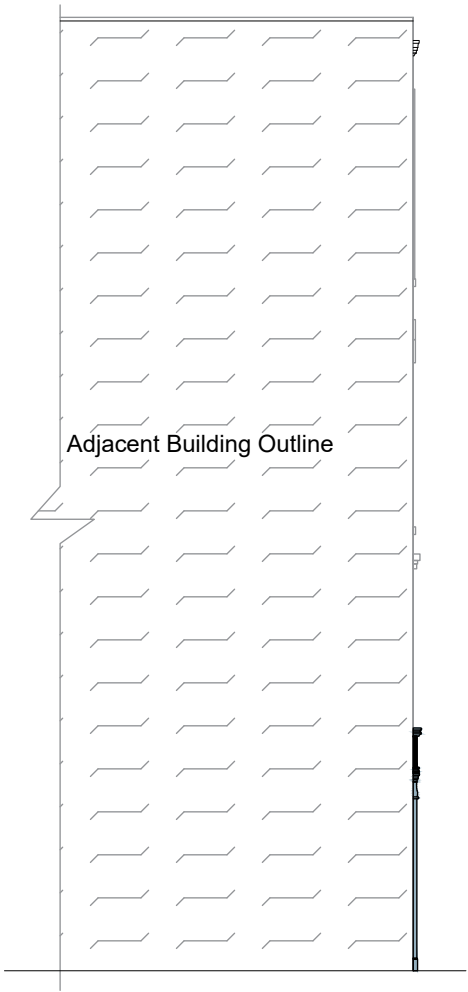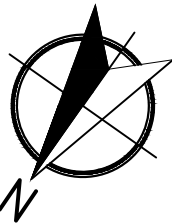


Pre-Existing Right Side Elevation

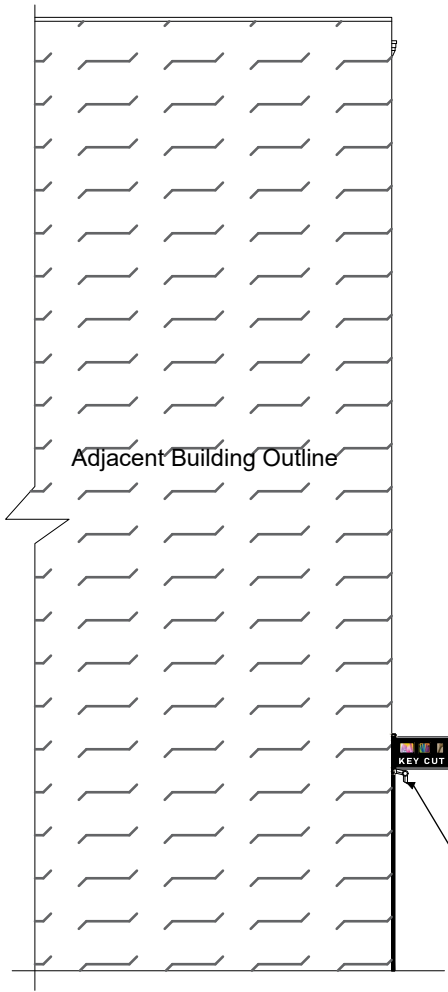

Existing As-built Right Side Elevation

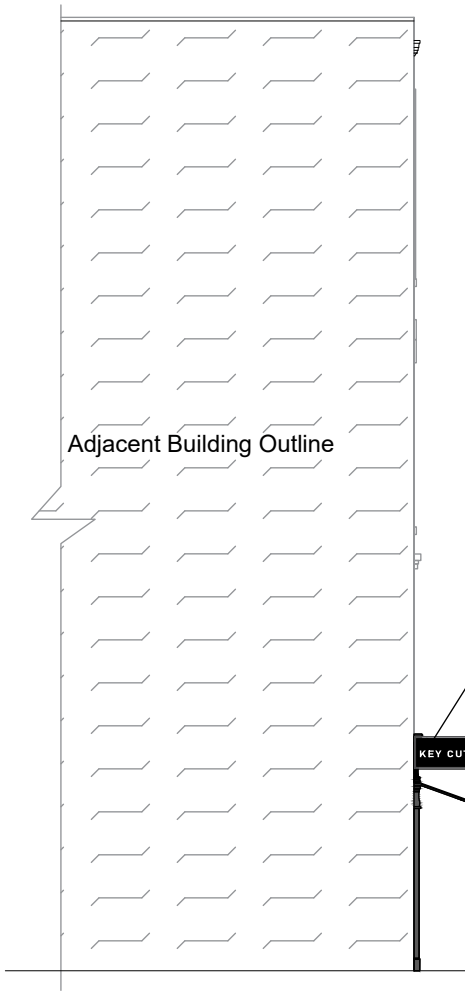

Proposed Right Side Elevation
(Awning Open).


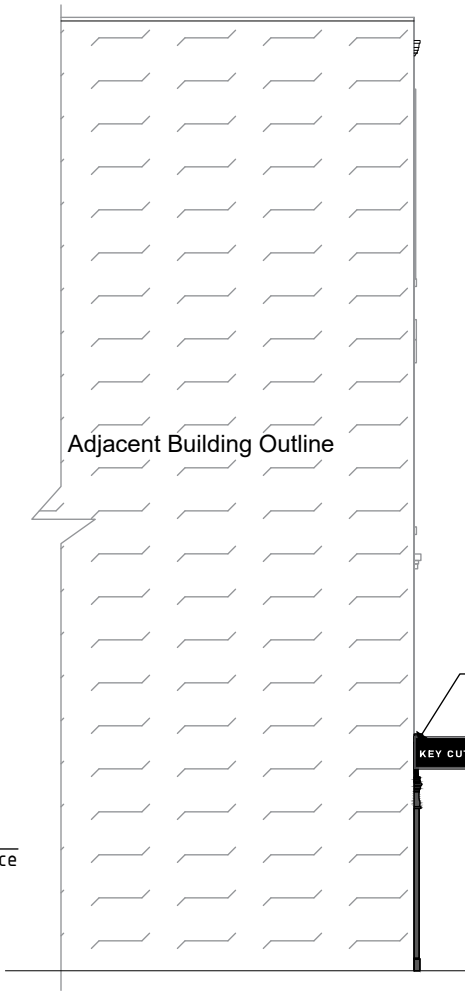


Proposed Right Side Elevation
(Awning Closed).




Address	164 Commercial Street, Newport, NP20 1JN.		Drawn By	Date	Rev	 Architecture - Town Planning Premises Licensing E: info@seandse.co.uk T: 020 4579 53 00 M: +44 (0) 7404765500 W: www.seandse.co.uk	
Sheet	5/8	Name Pre-existing, Existing As-built & Proposed Right Side Elevation.	MDF	17/11/2025	V4		
Reference	164CS-1711-PE/E/PRSE		Checked By				SS


Notes
1- All work is to be carried out the requirements, to the satisfaction of the Local Authorities. These drawings are for planing purposes only.
2- Responsibility is not accepted for errors made by others in scaling from this drawing. All construction information should be cross checked on the site.
3- All discrepancies and change of design requests by authorities should be reported to surveyor immediately.
4- All drawings to be read in conjunction with the project specification with all works carried out in accordance with the latest British Standards and codes of practice. Planning drawings are not to be used for the purpose of building & installation regulations.
5-It is assumed that all works will be carried out by a competent contractor working, where appropriate, to an approved method statement.
6-It is contractor's responsibility to notify the Building Control and get approval before any work commences.
7- It is contractors responsibility to determine if any wall is load-bearing.
8-Dimensions are based on information provided and existing records.
9-All dimensions are in millimeters.
10-The copyright of this drawing belongs to Se & Se Consultancy Ltd.

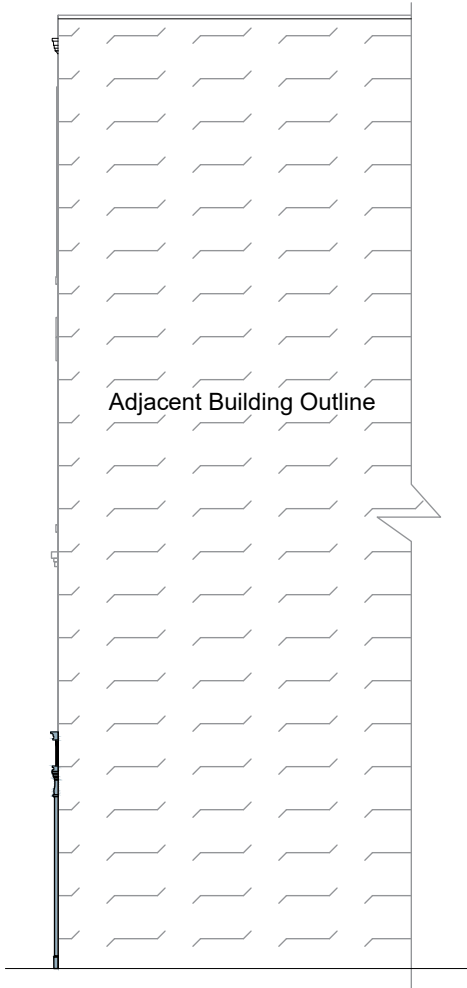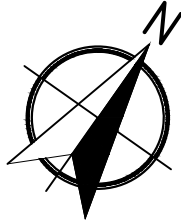


Pre-Existing Left Side Elevation

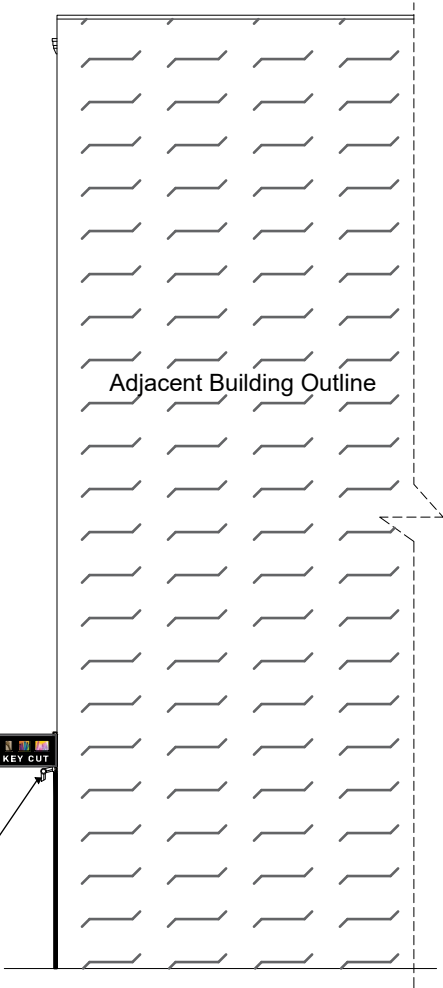

Existing As-built Left Side Elevation.

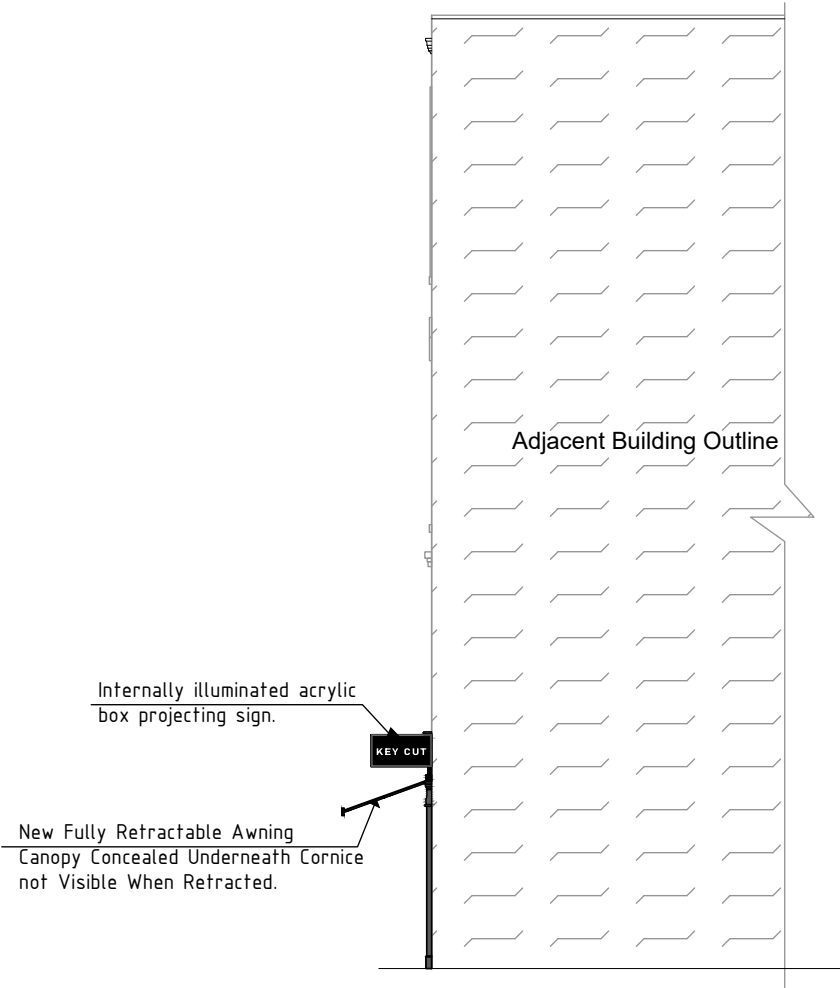

Proposed Left Side Elevation
(Awning Open).

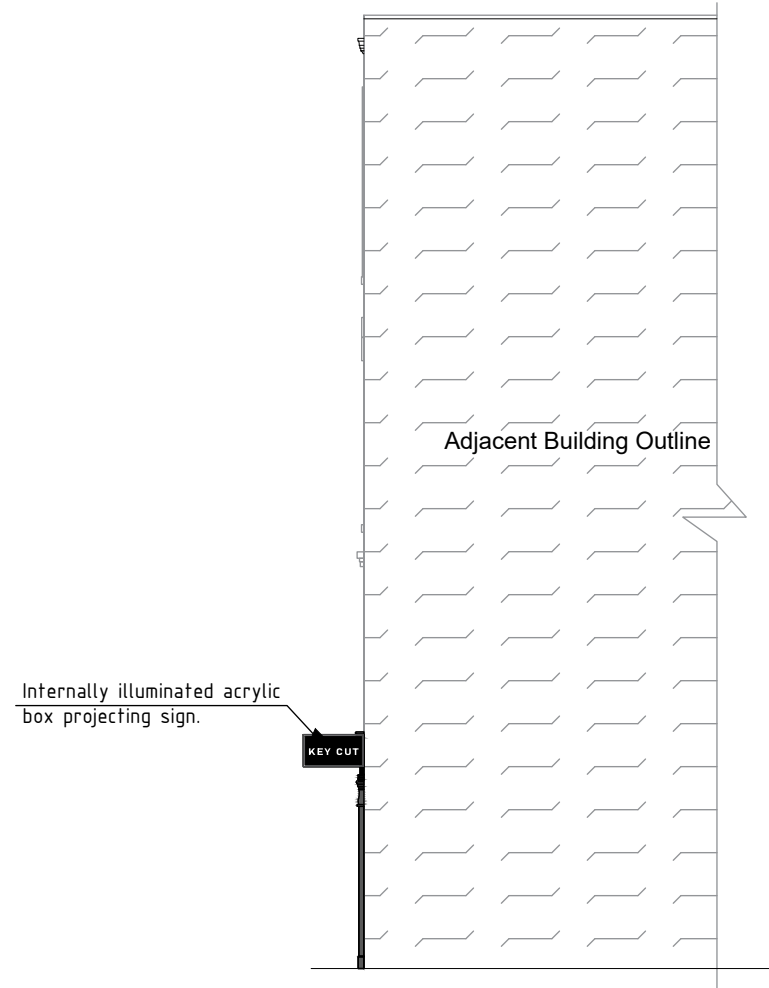

Proposed Left Side Elevation
(Awning Closed).



Address	164 Commercial Street, Newport, NP20 1JN.		Drawn By	Date	Rev	 Architecture - Town Planning Premises Licensing E: info@seandse.co.uk T: 020 4579 53 00 M: +44 (0) 7404765500 W: www.seandse.co.uk
Sheet	6/8	Name Pre-existing, Existing As-built & Proposed Left Side Elevation.	MDF	17/11/2025	V4	
Reference	164CS-1711-PE/E/PLSE.		SS			


- Notes
- 1- All work is to be carried out the requirements, to the satisfaction of the Local Authorities. These drawings are for planing purposes only.
 - 2- Responsibility is not accepted for errors made by others in scaling from this drawing. All construction information should be cross checked on the site.
 - 3- All discrepancies and change of design requests by authorities should be reported to surveyor immediately.
 - 4- All drawings to be read in conjunction with the project specification with all works carried out in accordance with the latest British Standards and codes of practice. Planning drawings are not to be used for the purpose of building & installation regulations.
 - 5-It is assumed that all works will be carried out by a competent contractor working, where appropriate, to an approved method statement.
 - 6-It is contractor's responsibility to notify the Building Control and get approval before any work commences.
 - 7- It is contractors responsibility to determine if any wall is load-bearing.
 - 8-Dimensions are based on information provided and existing records.
 - 9-All dimensions are in millimeters.
 - 10-The copyright of this drawing belongs to Se & Se Consultancy Ltd.

Internally Illuminated Individual Fret-cut Letters

Internally illuminated acrylic box projecting sign.


KEY CUT

- Signage to be Level on Designated Area of Building Faa as Shown in drawings
- Installation using screws and glass adhesive for secure fixing
- Fret-cut aluminium fascia with 10mm opal acrylic inlays and internal LED illumination.
- 75mm thick Internally illuminated acrylic box projecting sign.

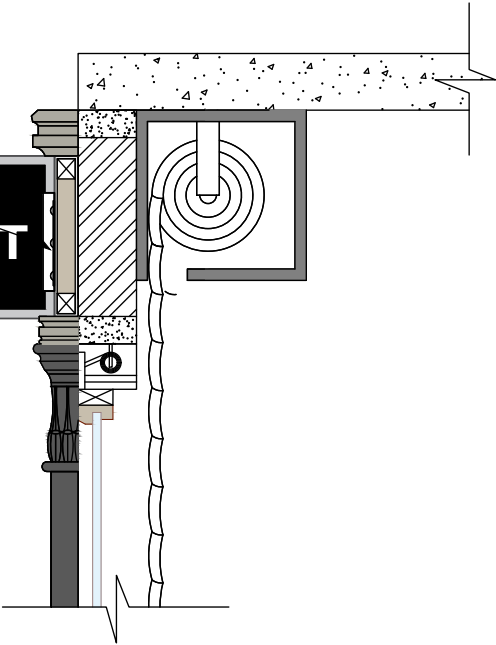

Proposed Fascia Section Through (X-X)

1:20 @A4

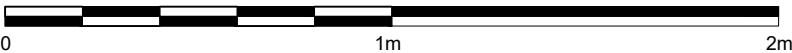

Address
164 Commercial Street, Newport, NP20 1JN.

Sheet
7/8

Reference
164CS-1711-PFST

Name
Proposed Fascia Section Through
(X-X).

Rev
V4

Date
17/11/2025

Drawn By
MDF

Checked By
SS

se se



Architecture - Town Planning
Premises Licensing
E: info@seandse.co.uk
T: 020 4579 53 00
M: +44 (0) 7404 765500
W: www.seandse.co.uk

- Notes
- 1- All work is to be carried out the requirements, to the satisfaction of the Local Authorities. These drawings are for planing purposes only.
 - 2- Responsibility is not accepted for errors made by others in scaling from this drawing. All construction information should be cross checked on the site.
 - 3- All discrepancies and change of design requests by authorities should be reported to surveyor immediately.
 - 4- All drawings to be read in conjunction with the project specification with all works carried out in accordance with the latest British Standards and codes of practice. Planning drawings are not to be used for the purpose of building & installation regulations.
 - 5-It is assumed that all works will be carried out by a competent contractor working, where appropriate, to an approved method statement.
 - 6-It is contractor's responsibility to notify the Building Control and get approval before any work commences.
 - 7- It is contractors responsibility to determine if any wall is load-bearing.
 - 8-Dimensions are based on information provided and existing records.
 - 9-All dimensions are in millimeters.
 - 10-The copyright of this drawing belongs to Se & Se Consultancy Ltd.



- Signage to be Level on Designated Area of Building Faa as Shown in drawings
- Installation using screws and glass adhesive for secure fixing
- Fret-cut aluminium fascia with 10mm opal acrylic inlays and internal LED illumination.

Facia Signage Elevation.

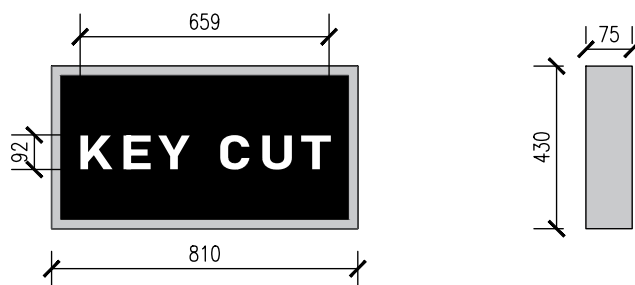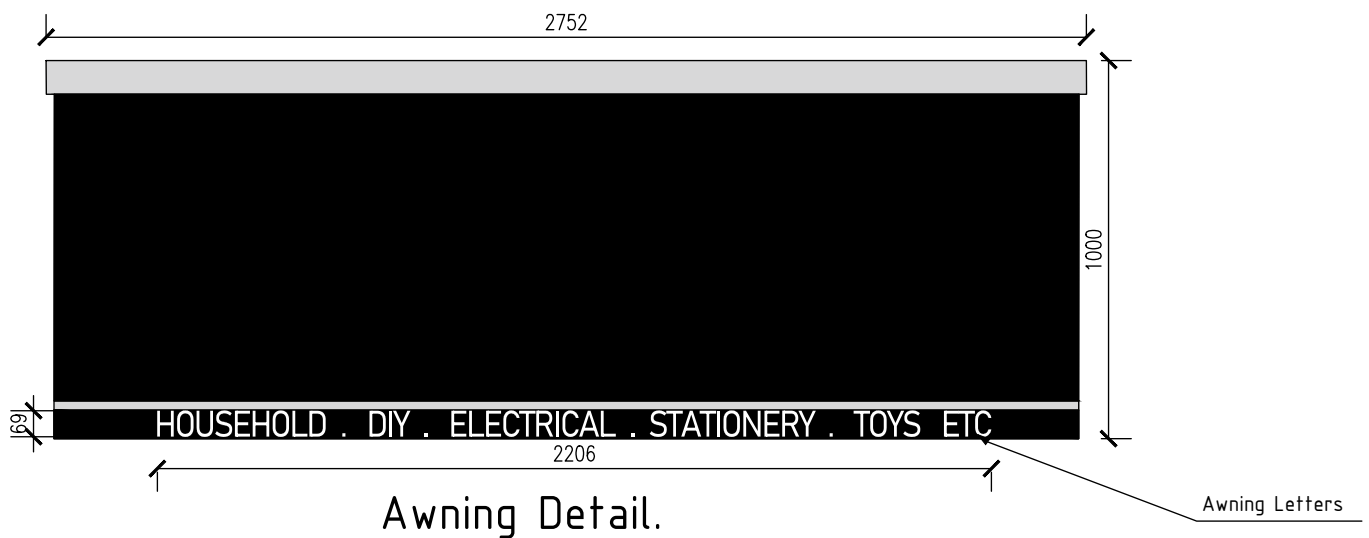

Projecting Signage

1:20 @A4



Address 164 Commercial Street, Newport, NP20 1JN.		Rev V4	 Architecture - Town Planning Premises Licensing E: info@seandse.co.uk T: 020 4579 53 00 M: +44 (0) 7404765500 W: www.seandse.co.uk
Sheet 8/8	Name Proposed signage Detail.	Date 17/11/2025	
Reference 164CS-1711-PSD		Drawn By MDF	Checked By SS