



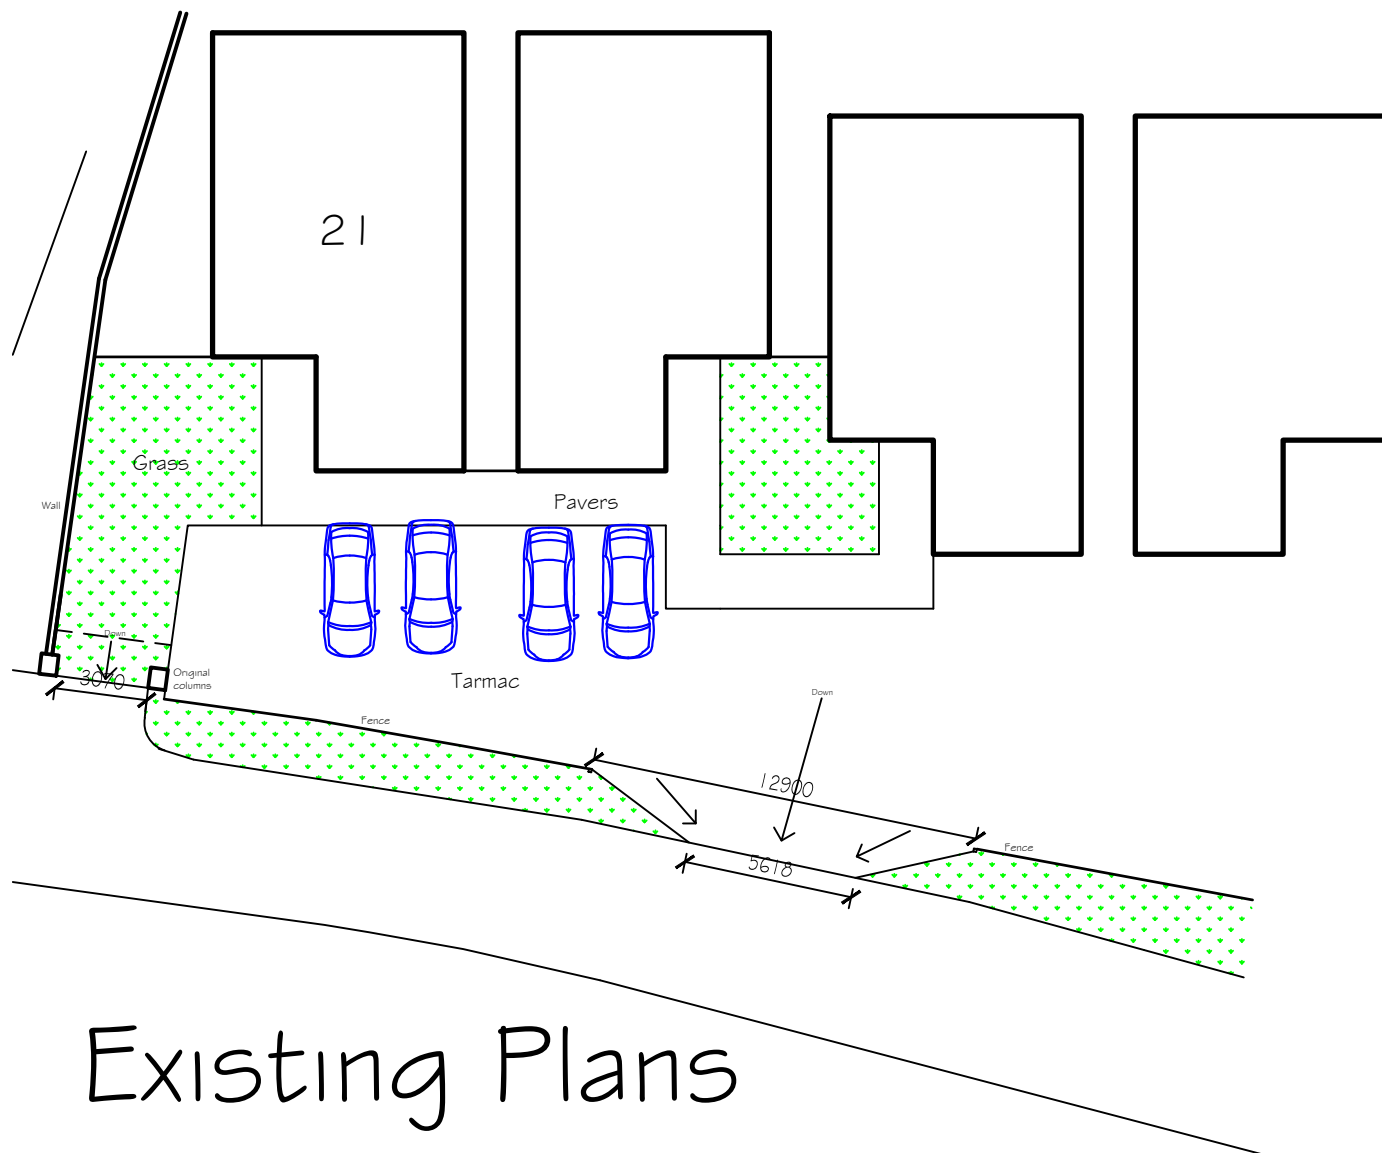

Existing Plans

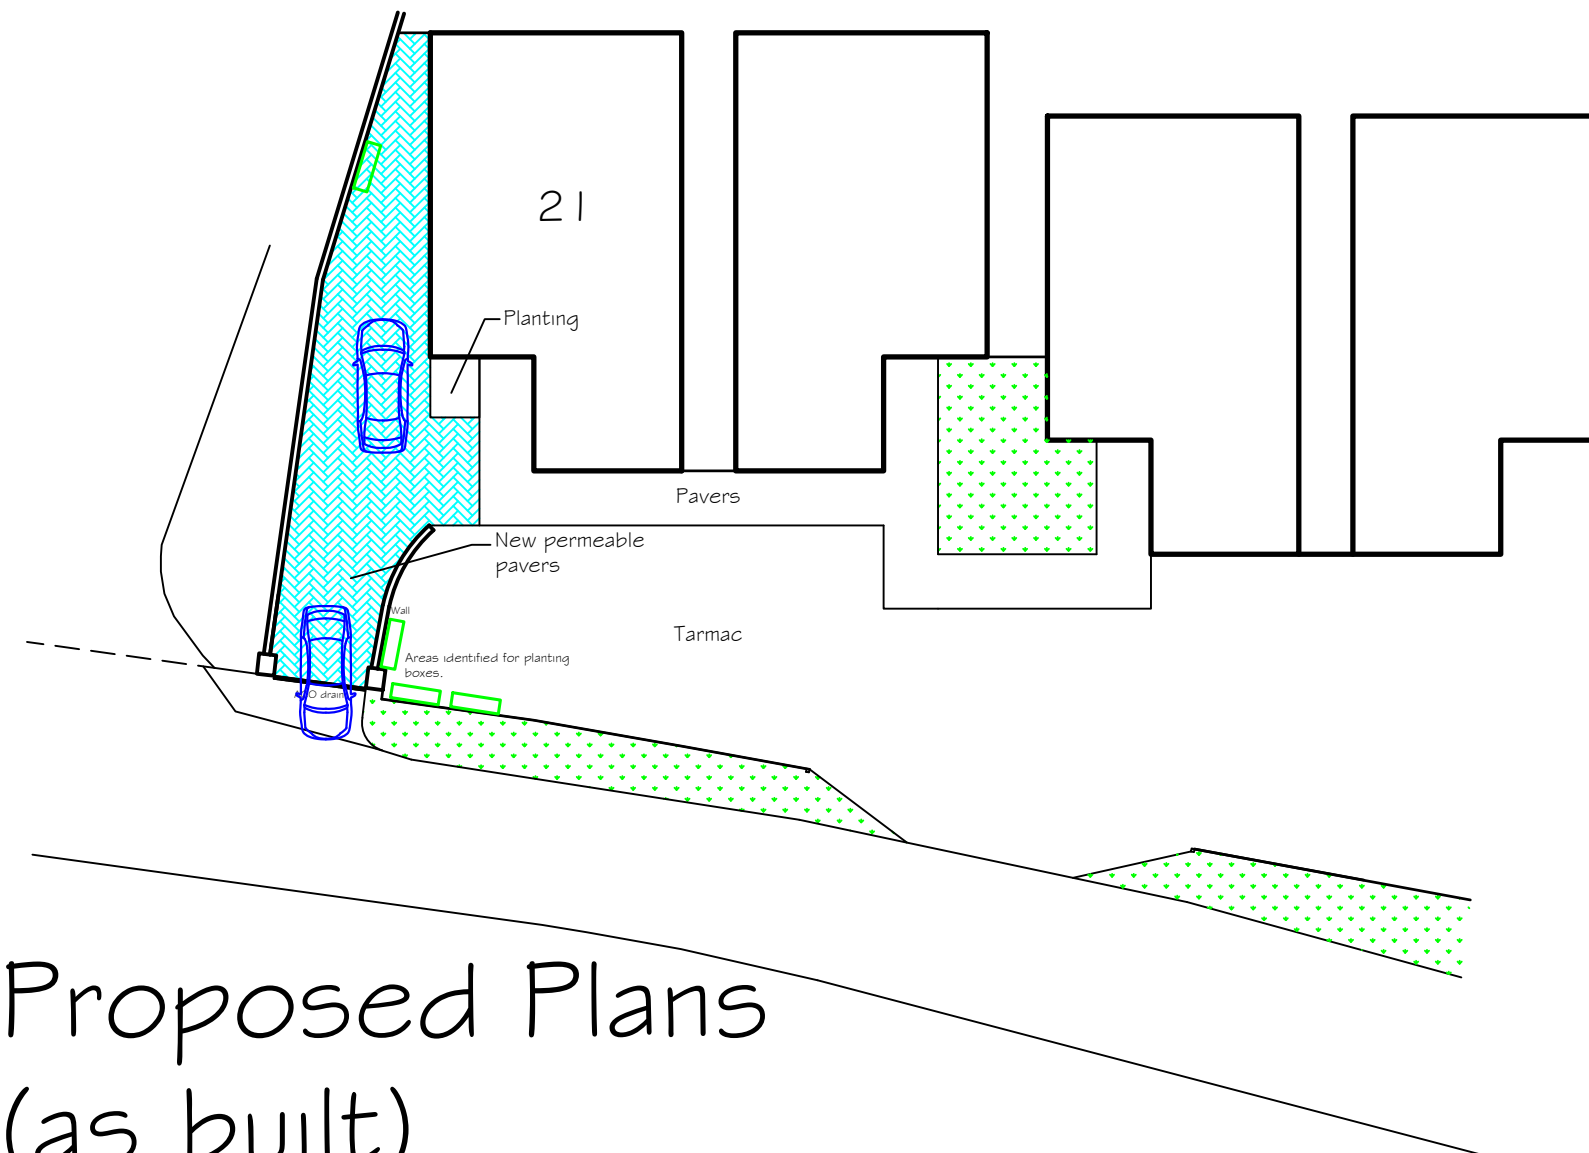

Proposed Plans
(as built)



© This drawing is copyright.
21 St Mellons Road
Marshfields

EXISTING & PROPOSED PLANS		
Scale:	1:250@A3	Drwg No. 21SMR/26/01
Date:	January 2026	
Revisions:		
Drawings not to be scaled, use figured dimensions and levels only. Any inaccuracies should be notified to the architect.		