


This 'As Built' drawing has been produced based on information provided by Norwest Holst Construction Ltd


DO NOT SCALE

ATKINS

River Usk (Afon Wysg)

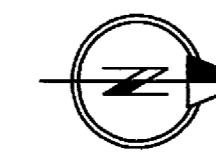

- Key**
- Detail Reference
 - Drawing Reference
 - Weld mesh secure boundary fence, 2400mm high, Coated black
 - Gated multi coloured / natural stain timber 'fun' screen, 1200mm high
 - Weld mesh fencing to ATP and MUGA to specialist contractor's specification
 - CD** Change in Direction Point to boundary fence, Contractor to ensure straight runs between CD points.

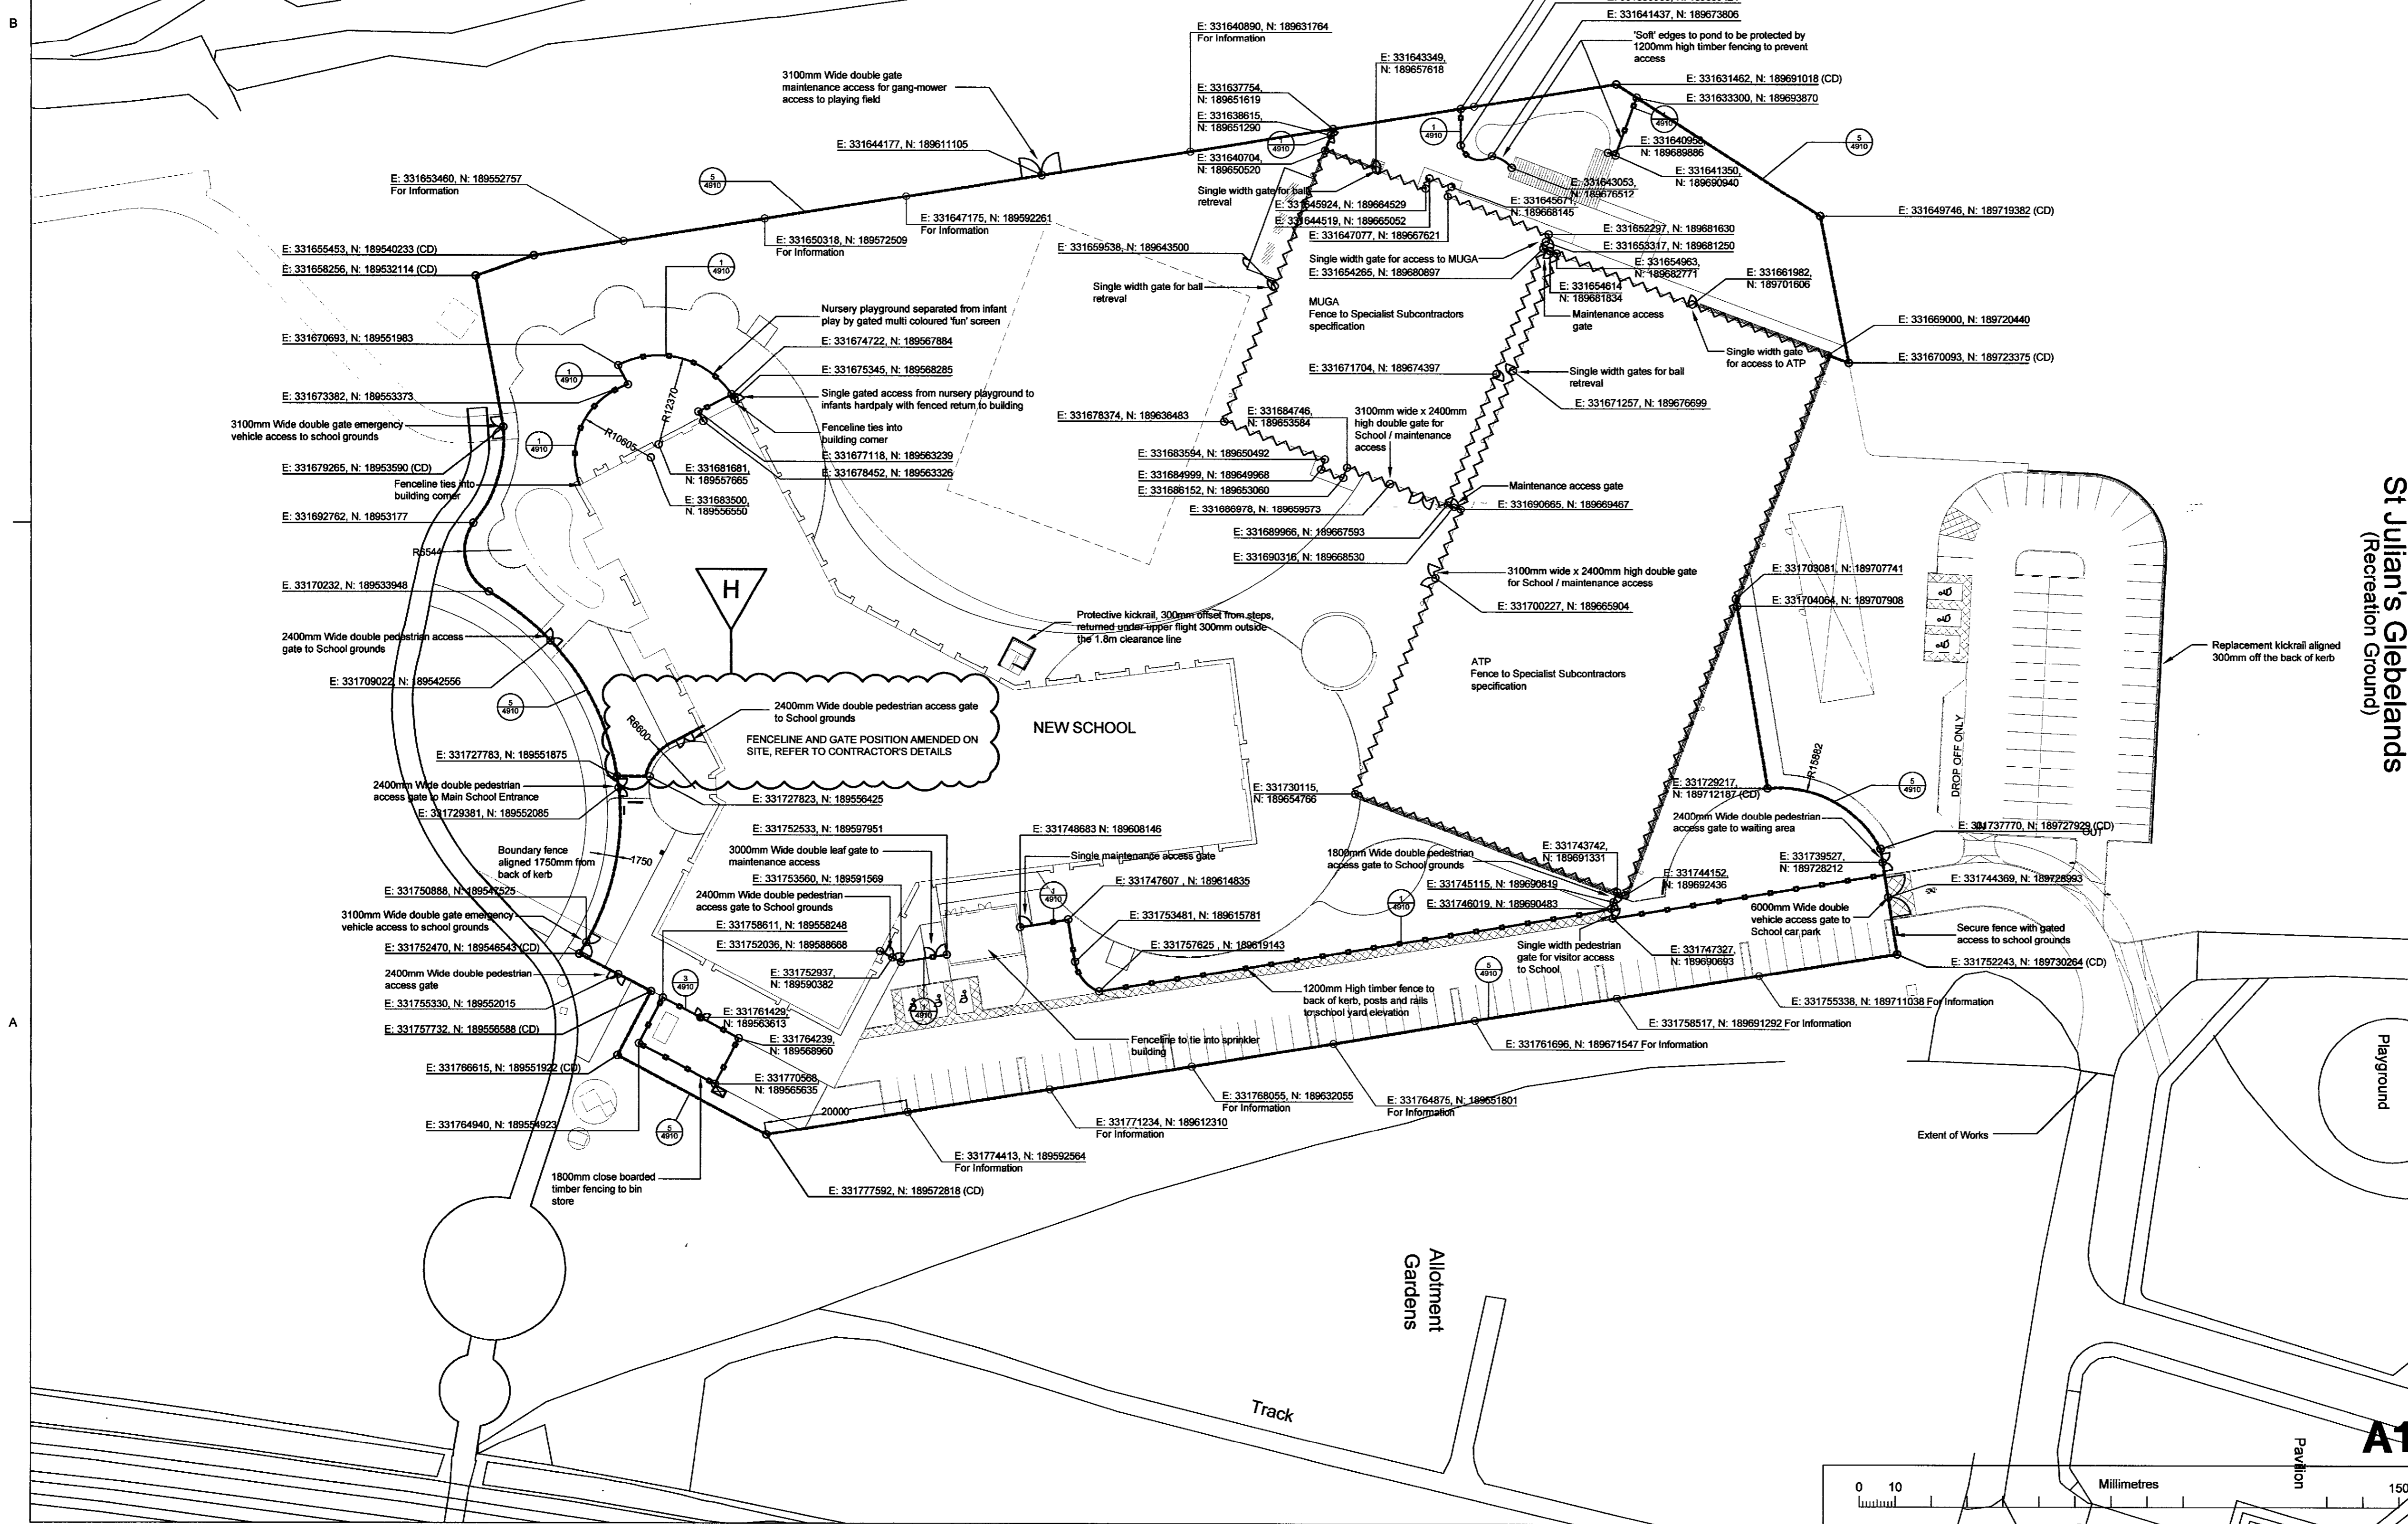

AS BUILT ISSUE

Rev.	Description	By	Date	CHK	Auth
H	AS BUILT		28/10/06		NR
G	CONSTRUCTION		28/06/06		MD
F	CONSTRUCTION		04/08/06		MD
E	PLANNING		28/05/06		NR
D	CONSTRUCTION		22/01/06		MD
C	CONSTRUCTION		12/01/06		NR
B	CONSTRUCTION		18/12/06		NR
A	CONSTRUCTION		08/09/06		WM

Additional notes on the right side of the plan include: 'Fence updated to MEWP access and revised turning head alignment. Site store enclosure amended to 1800mm high close boarded fence.', 'Additional coordinates provided at 20m intervals to the western boundary fence for information purposes only. Setting out on site to ensure straight lines achieved between Change in Direction points (CD). CD points added to drawing.', 'Fence updated to car park updated.', 'Fence to Wildlife area amended to revised MUGA edge detail. Public access gate to Wildlife area omitted. Fence to car park access updated.'

St Julians Glebelands
(Recreation Ground)

VINCI

NORWEST HOLST

WS Atkins Consultants Limited
Design, Environment & Engineering
160 Aztec West, Almondsbury, Bristol. BS32 4TU.
Tel. 01454 201400 / Fax. 01454 201568

Project
Glebelands Development
St Julians
Newport

Title
Glan Usk School
AS BUILT
Site Enclosure Plan

Original Scale	1:500	Drawn	AHL	Checked	NR	Authorised	NR
Drawing Number	5041855 / LA / 4909	Date	10/01/06	Date	07/02/06	Date	07/02/06
							Rev H

