

ADA06 LIMITED

info@ada06.co.uk

Old Forge Cottage, Hall Lane, Walton, LE17 5RP, UK



INTELLECTUAL PROPERTY

Copyright ADA06, unless agreed in writing. All rights to use this document are subject to payment in full of all ADA06 charges. This document may only be used for the express project and purpose for which it has been designed. This document must not be otherwise used or copied. Any unauthorised use releases and indemnifies ADA06 from and against all loss so arising.

DRAWING NOTICES

Do not scale other than for planning purposes. All dimensions to be confirmed on site, any discrepancies to be reported to ADA06 prior to proceeding. All drawings are to be read in conjunction with specifications and other consultant discipline information.

REVISIONS

P01 - 08.01.25 - APD - RED LINE ADJUSTED
Q01 - 06.05.25 - APD - AS BUILT



CLIENT

TSL LIMITED

CONSULTANTS

PROJECT NAME

CWL90

PROJECT ADDRESS

NEWPORT, NP19 4QZ

DRAWING TITLE

SITE LOCATION PLAN

SCALE	STATUS	ADA PROJECT No.
1:1250@A0	AS BUILT	24002



DRAWN	CHECKED	DATE	REVISION
APD	APD	06.05.25	Q01

DRAWING NUMBER

GB-CWL90-ADA-ST-00-DR-A-200101



SITE LOCATION PLAN
SCALE 1:1250

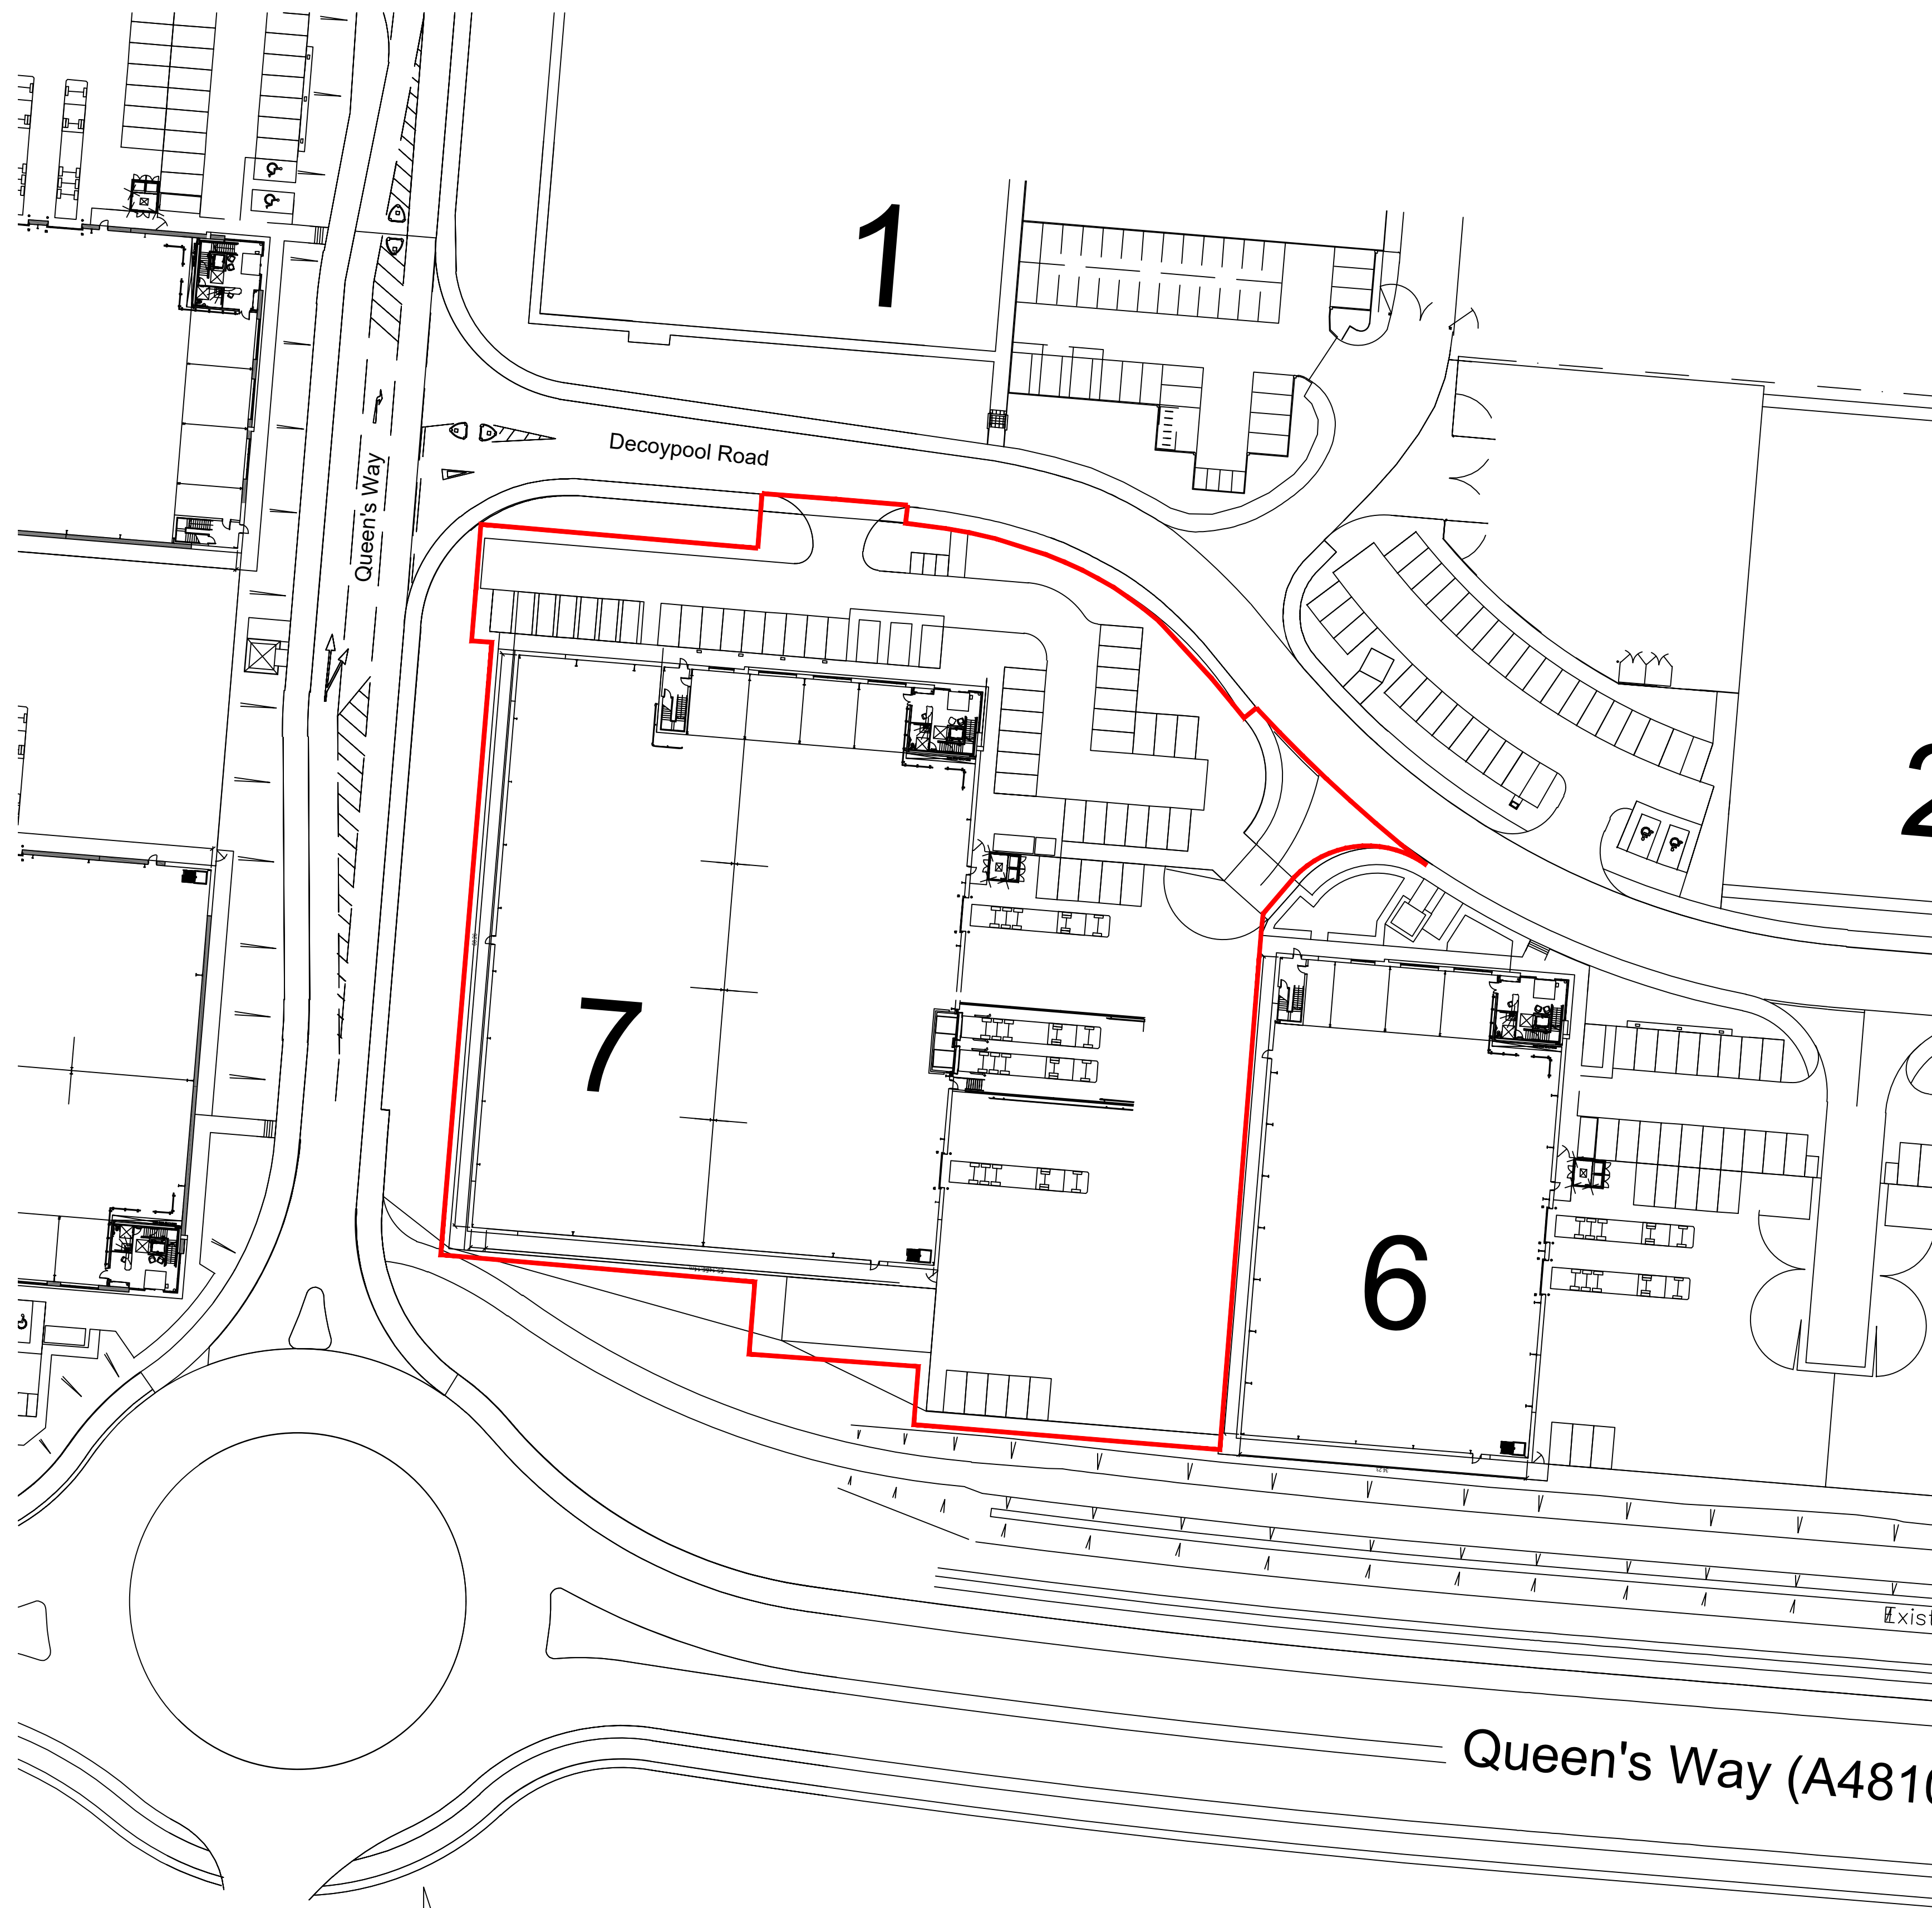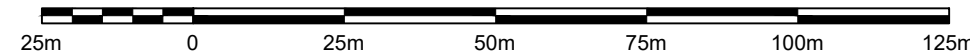

SITE LOCATION PLAN
SCALE 1:500

