


EXISTING
SITE PLAN

SCALE : 1 : 2 0 0

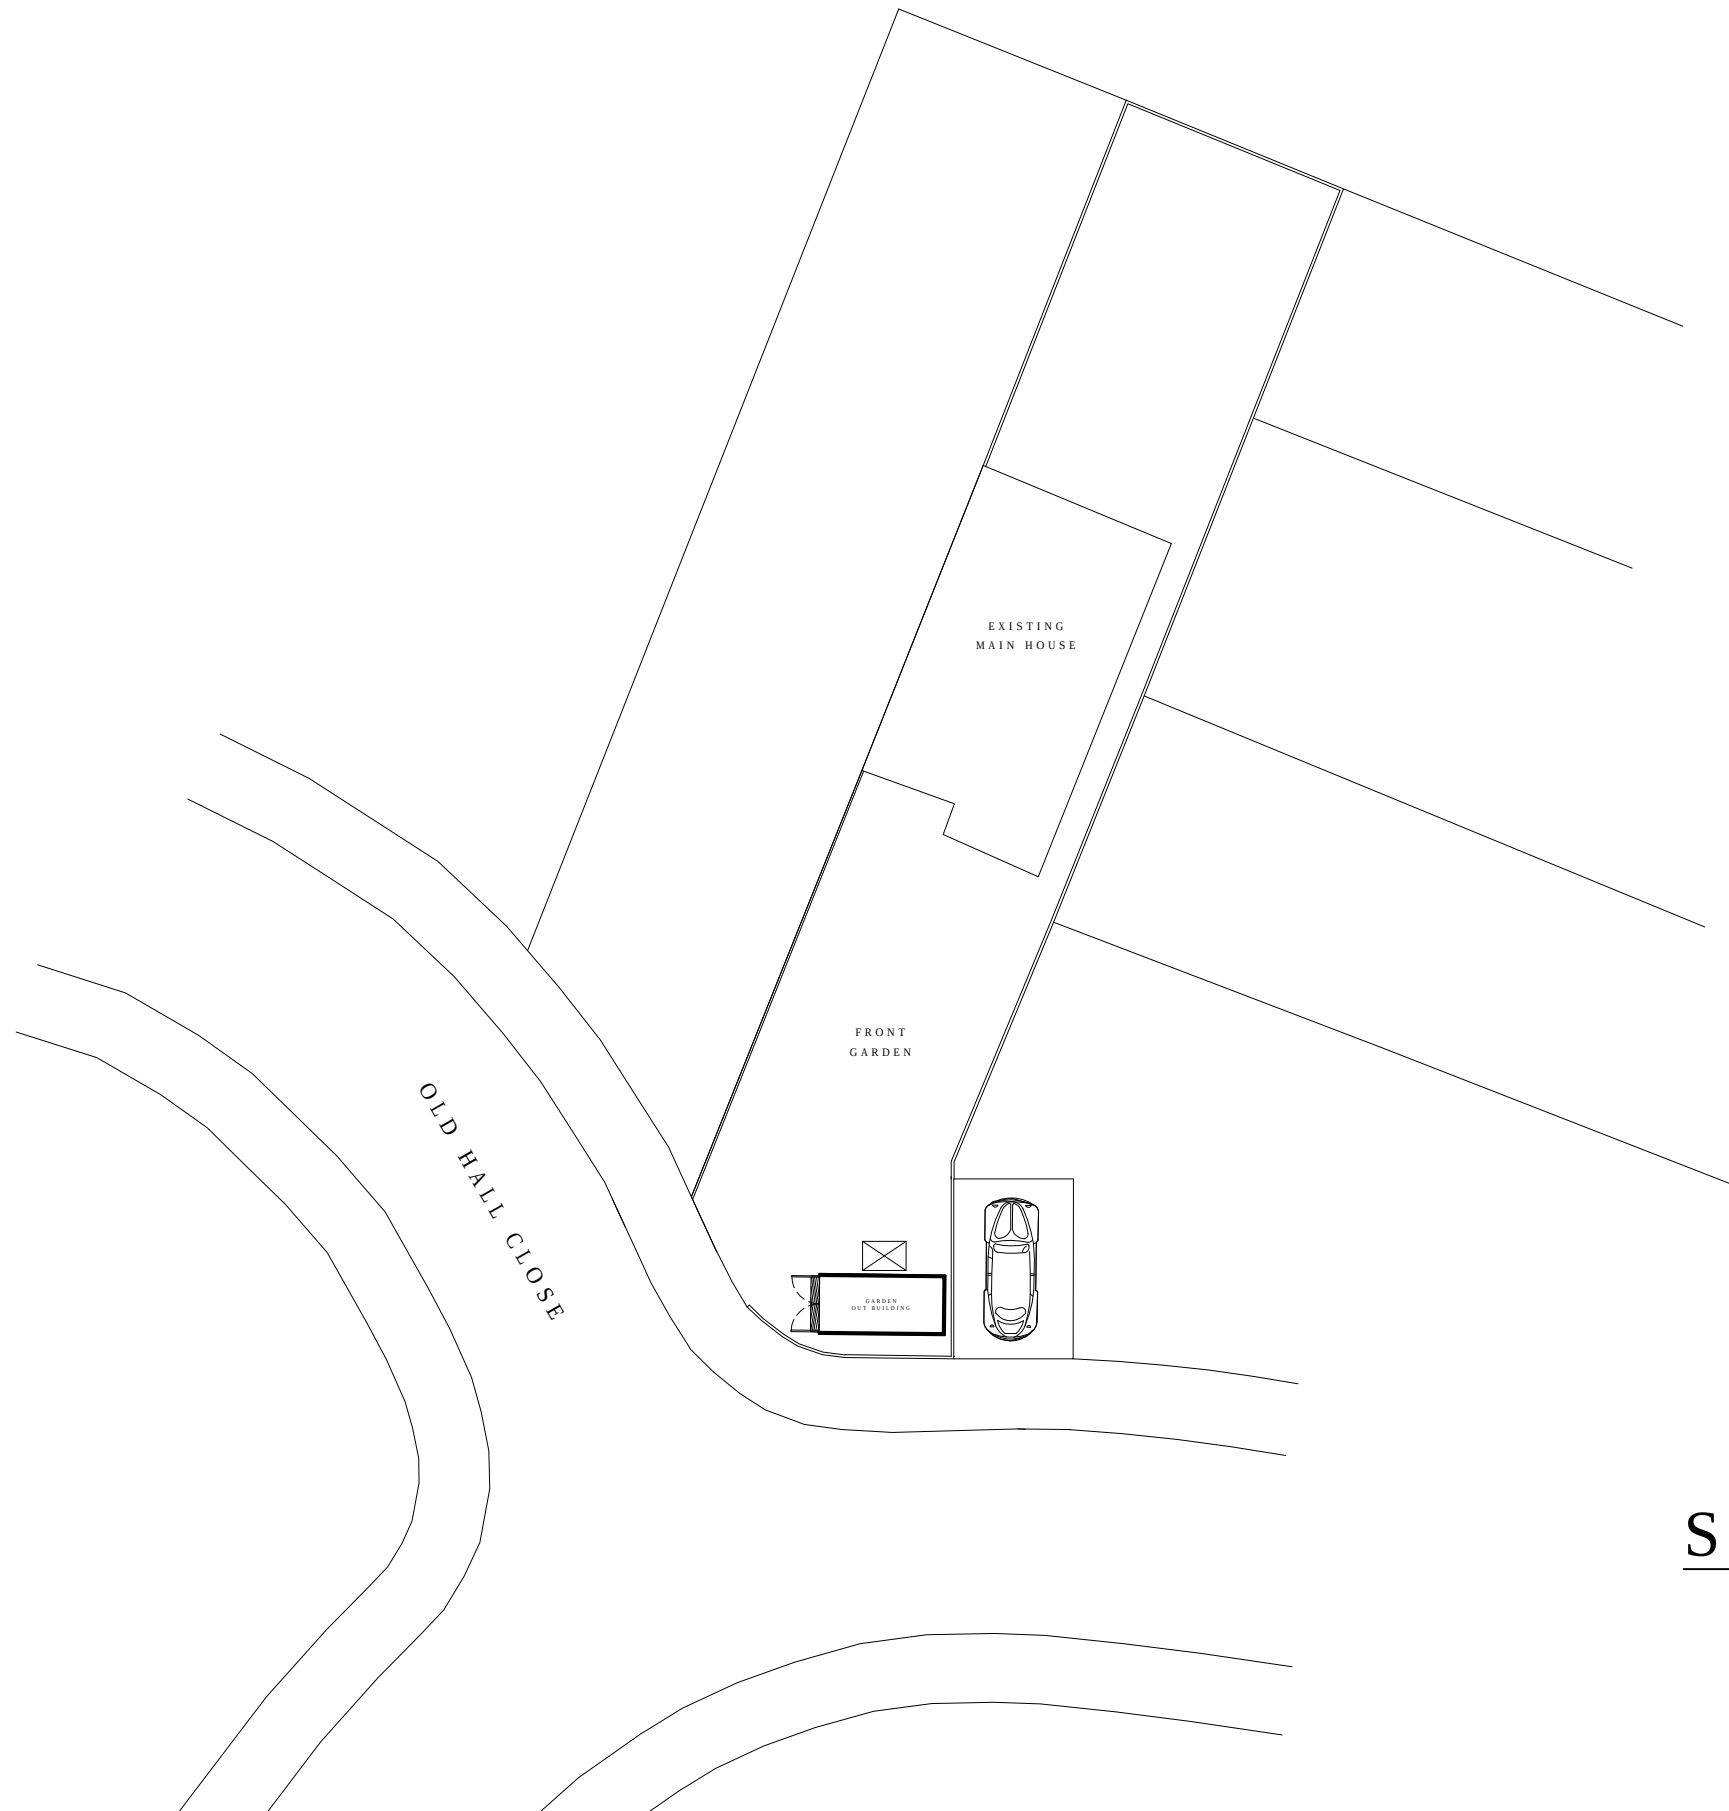

Project :
No.02, Old Hall Close,
Newport. NP10 8HQ

© This Drawing is Copy Right.
Contractor to check all dimensions on site and to report any
discrepancies directly to the SO

Scale :

1 : 200
ON A3

Drawn :
S W

Dwg No : 102

Date : 03.09.2025

Description :

AS-BUILT DRAWINGS OF
GARDEN OUT BUILDING
SITE PLAN



DESIGNS
S K DESIGNS

58B, Clearwater Way,
Lakeside, Cardiff.
CF23 6DJ

Tel : 029 20 761 950
Fax : 029 20 761 950
Email : info@skdesigns.org.uk