



FLOOR PLAN @ 1:100
Prior to works

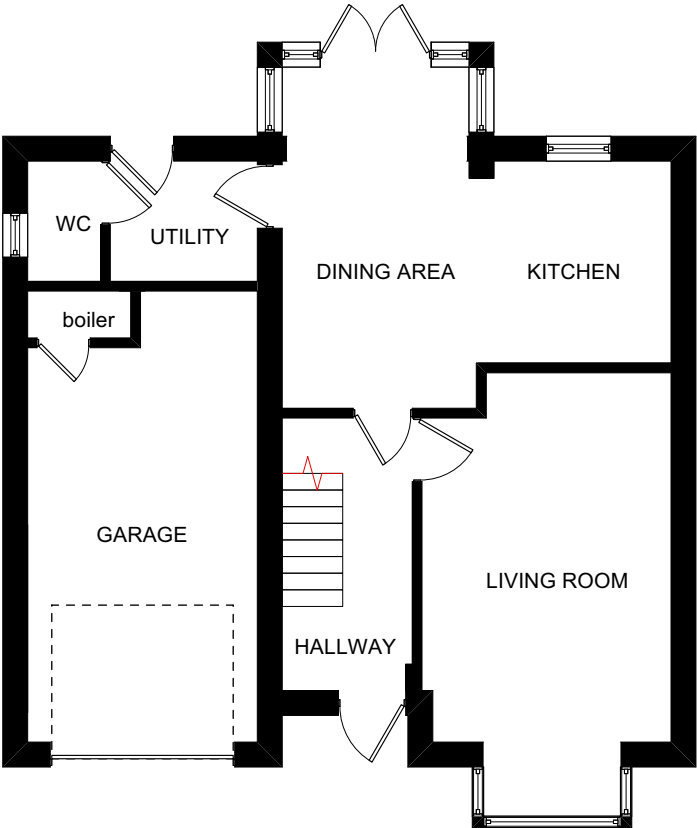

FLOOR PLAN @ 1:100
As built and inspected by Local Planning Authority
and work signed off by Newport Building Control

New window
sill height - 1109
window height - 1015

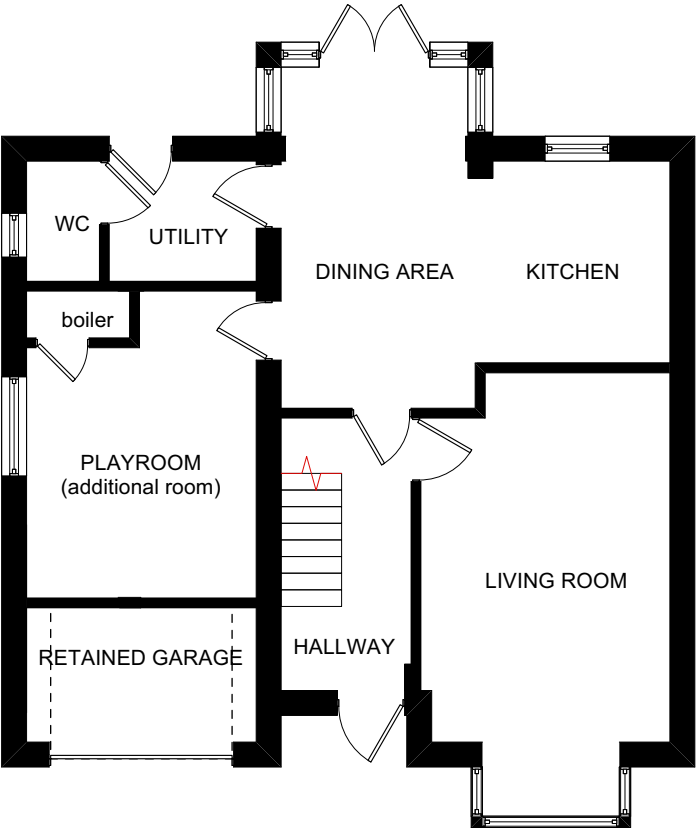

© Crown copyright and database rights 2026 OS AC0000847942





Skerryvore Designs Ltd
skerryvoredesigns.co.uk

Phone **01633 897922**
Mobile **07816 934352**
contact@skerryvoredesigns.co.uk

JOB

TITLE 17 Park Way
Rogerstone
NP10 9NQ

DRAWING

TITLE Floor plans &
Site location plan

DRAWING No. SD1235-01

SCALE 1:100 & 1:1250 @ A3

DATE June 2026