





Google earth screenshot of former entrance

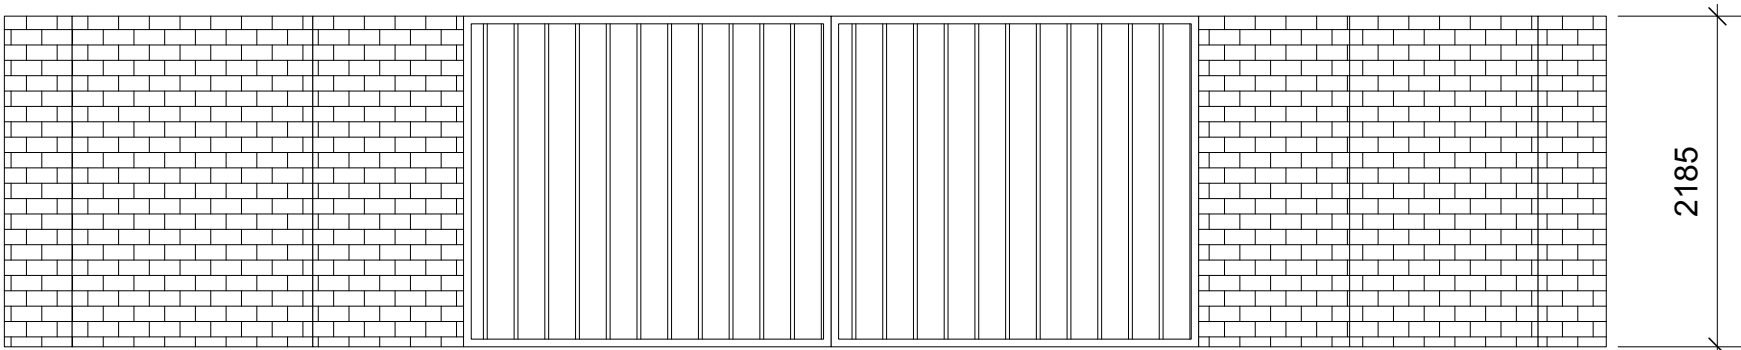

Entrance as built

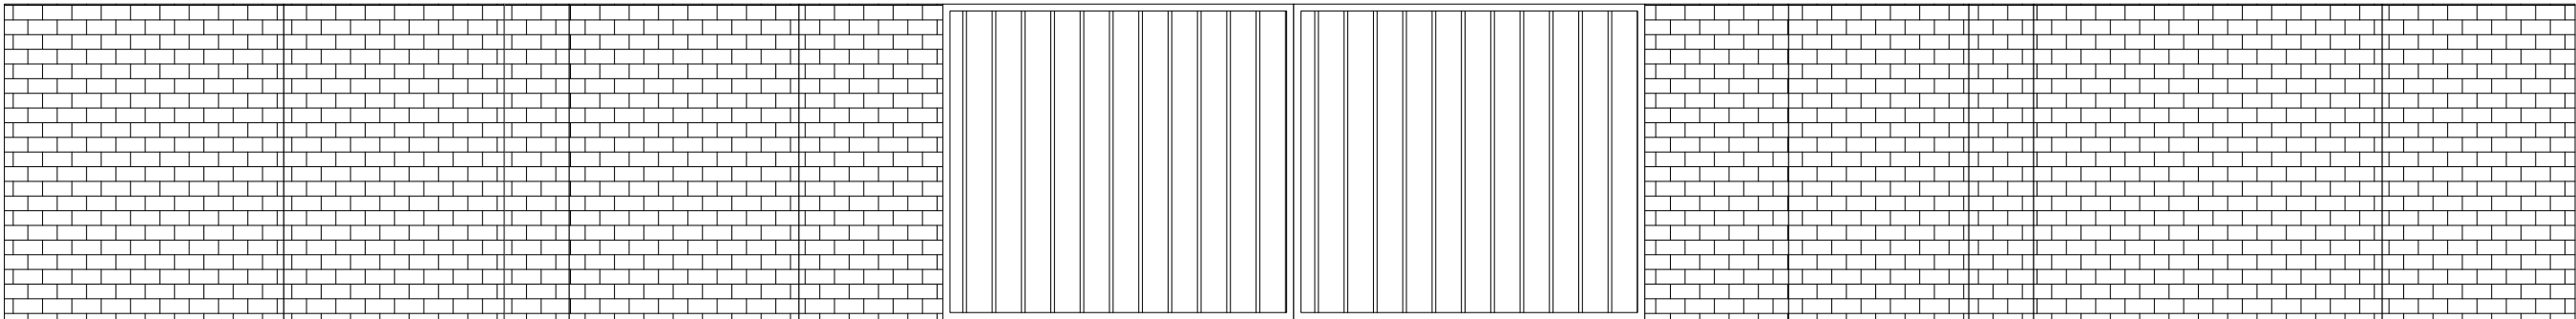

Proposed Entrance

 Skerryvore Designs Ltd skerryvoredesigns.co.uk Phone 01633 897922 Mobile 07816 934352 contact@skerryvoredesigns.co.uk	JOB TITLE Oakfields, St. Brides, Lighthouse Road, Newport NP10 8SF	DRAWING TITLE Elevations	DRAWING No. SD1065-01
			SCALE 1:50 @ A3
			DATE March 2025