


SCALED DIMENSIONS SHOULD NOT BE TAKEN FROM THIS DRAWING.

All dimensions must be checked on site before detailed design, construction or fabrication.

This drawing and these designs are the copyright both real and intellectual of Caroe and Partners Architects.


Base drawing from Davies Sutton Architects

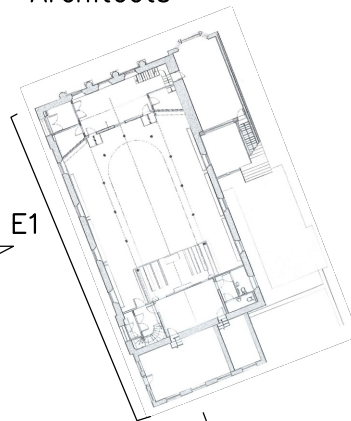

KEY

① External camera

② SOUTH ELEVATION (Partial)
Scale 1:100

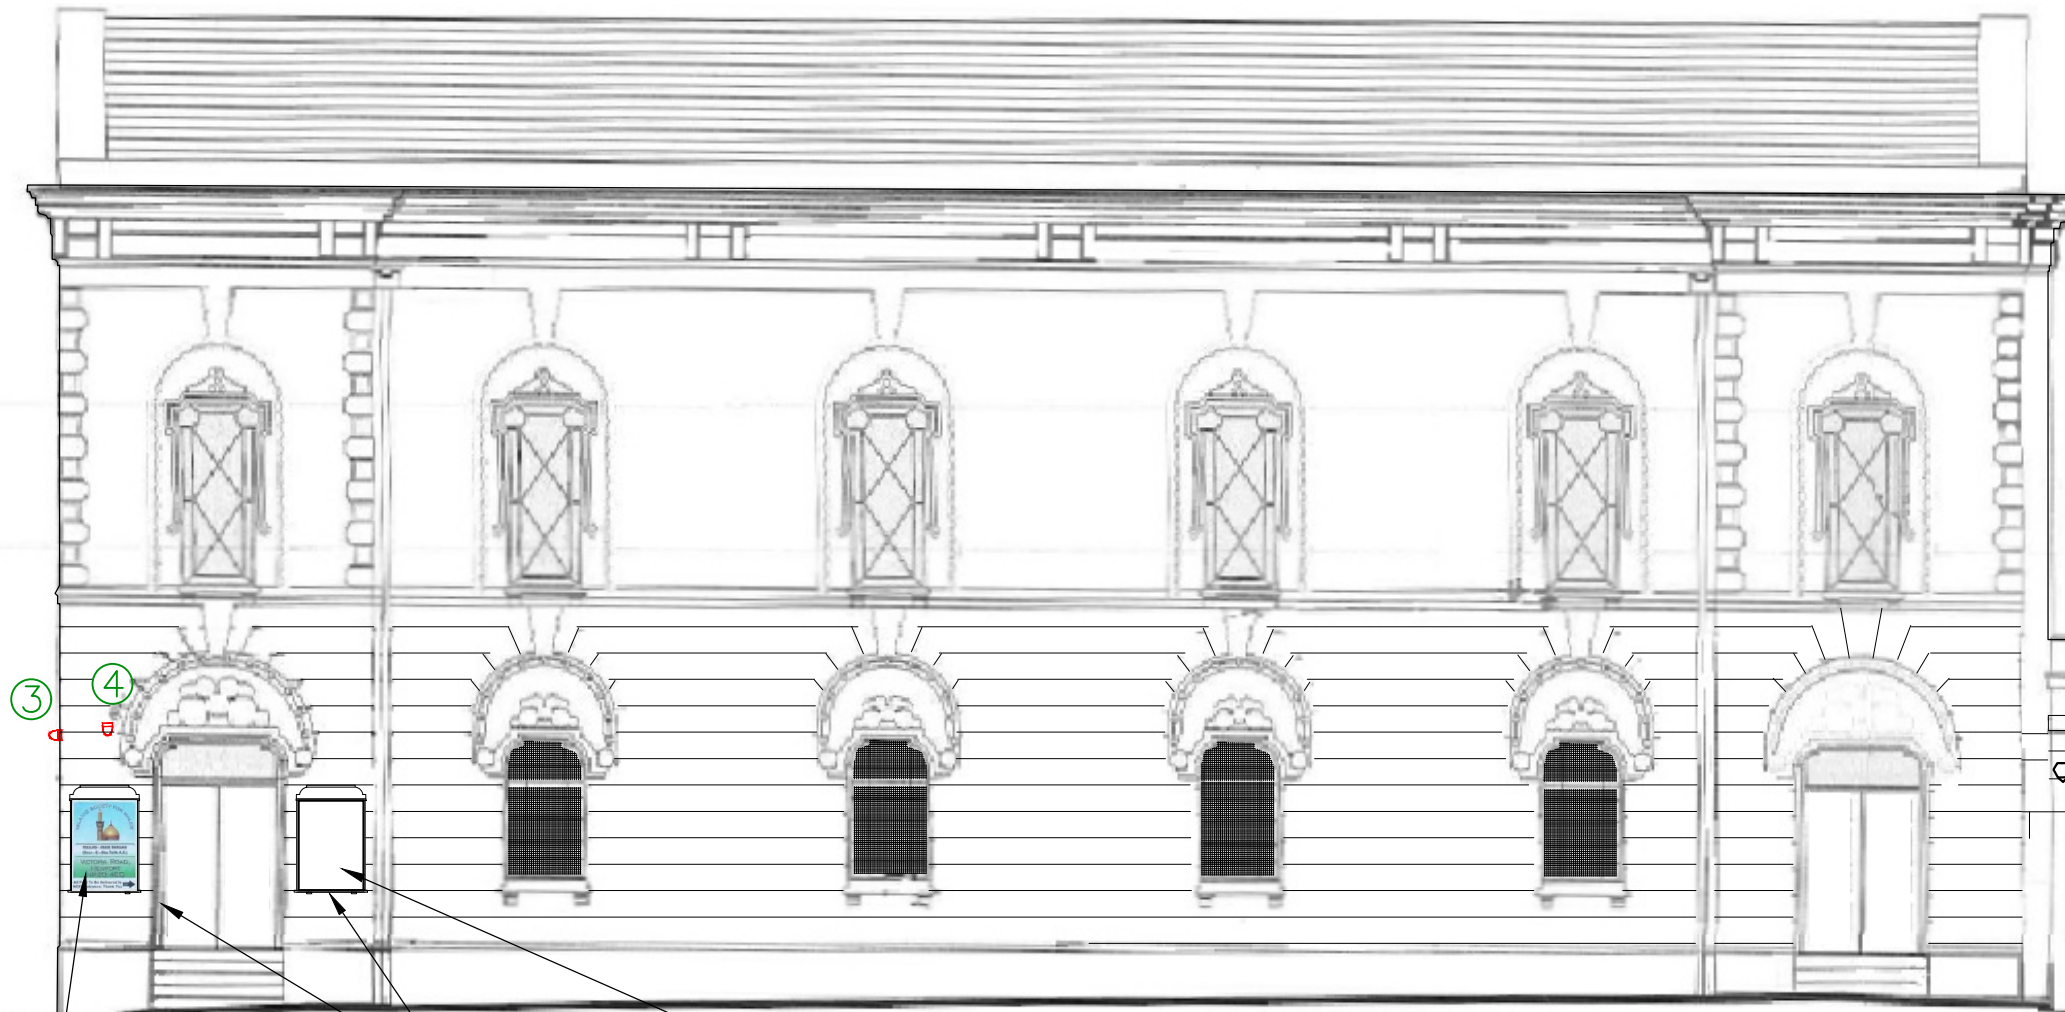


Existing signboard with removable acrylic laminated Islamic Society signage fixed over original signage, which is retained underneath

Original metal frames remain visible

Existing United Reformed Church noticeboard with removeable metal sheet covering used by Islamic Society for Wales, Gwent Police and Newport City Council for notices

① WEST ELEVATION AS BUILT (Victoria Road)
Scale 1:100

Revisions			
Rev	Date	Description	By
A	29/01/25	Proposal notes added	MR
B	24/07/26	Proposed cctv cameras amended	RC

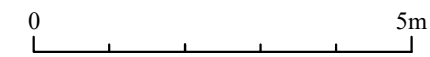

Caroe & Partners Architects

34 – 36 Church Street
Tewkesbury
Gloucestershire
GL20 5SN
Tel: 01531 634848
www.caroe.co.uk
Tewkesbury@caroe.co.uk

Project
ISLAMIC SOCIETY FOR WALES
CCTV AND SIGNAGE

Drawing
West and South Elevations as Built

Drawing No.	Scale	
L1593/005B	1:100 @ A3	
Date	Drawn By	Purpose
Jan 2024	HG	Planning