



ELEVATION LINK BLOCK CASHIER / PUBLIC ENTRANCE

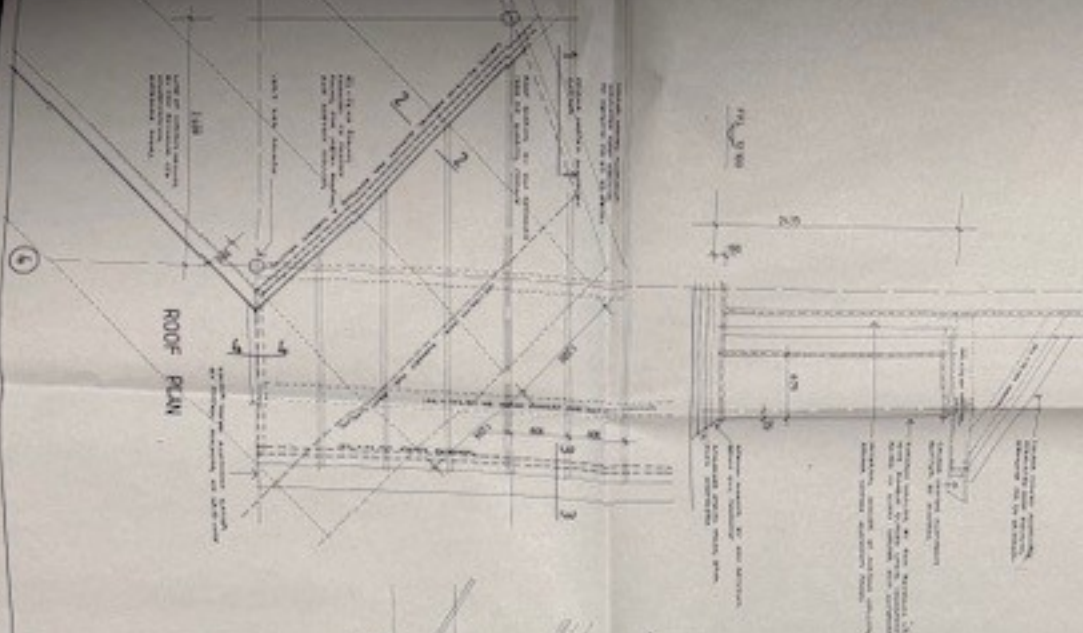

ROOF PLAN


1 GUTTER DETAIL ALUMINUM ROOF TO ROOF GLAZING

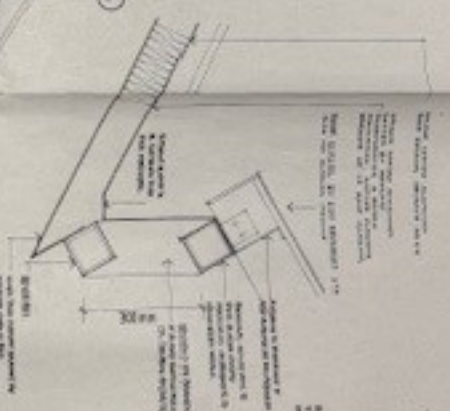


3 LINK BLOCK EAVES DETAIL



2 RACING ABUTMENT CURTAIN WALLING TO ROOF

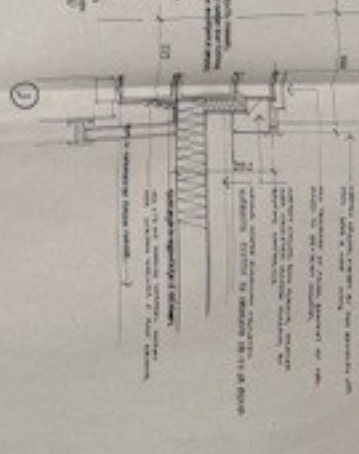

4 LINK BLOCK GABLE END

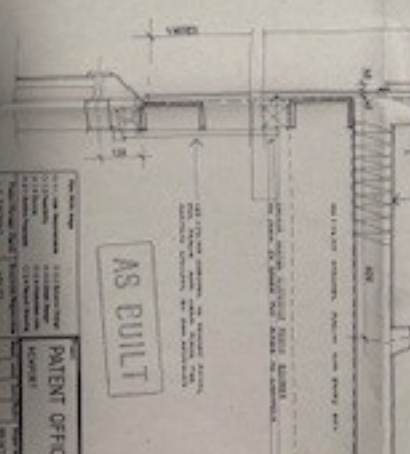

AS BUILT

NOT TO SCALE, UNLESS OTHERWISE NOTED.
ALL DIMENSIONS IN MILLIMETERS.
UNLESS OTHERWISE NOTED, ALL DIMENSIONS ARE TO FACE.
UNLESS OTHERWISE NOTED, ALL DIMENSIONS ARE TO FACE.

PROJECT NAME PROJECT NO. PROJECT LOCATION PROJECT DATE		PATENT OFFICE PROJECT NO. PROJECT DATE	
DRAWING NO. DRAWING DATE DRAWING SCALE		ROOF DETAILS LINK BLOCK	
PROPERTY SERVICE AGENCY - DOR		AD21LB/36	















