



- Notes
- 1- All work is to be carried out the requirements, to the satisfaction of the Local Authorities. These drawings are for planing purposes only.
 - 2- Responsibility is not accepted for errors made by others in scaling from this drawing. All construction information should be cross checked on the site.
 - 3- All discrepancies and change of design requests by authorities should be reported to surveyor immediately.
 - 4- All drawings to be read in conjunction with the project specification with all works carried out in accordance with the latest British Standards and codes of practice. Planning drawings are not to be used for the purpose of building & installation regulations.
 - 5-It is assumed that all works will be carried out by a competent contractor working, where appropriate, to an approved method statement.
 - 6-It is contractor's responsibility to notify the Building Control and get approval before any work commences.
 - 7- It is contractors responsibility to determine if any wall is load-bearing.
 - 8-Dimensions are based on information provided and existing records.
 - 9-All dimensions are in millimeters.
 - 10-The copyright of this drawing belongs to Se & Se Consultancy Ltd.

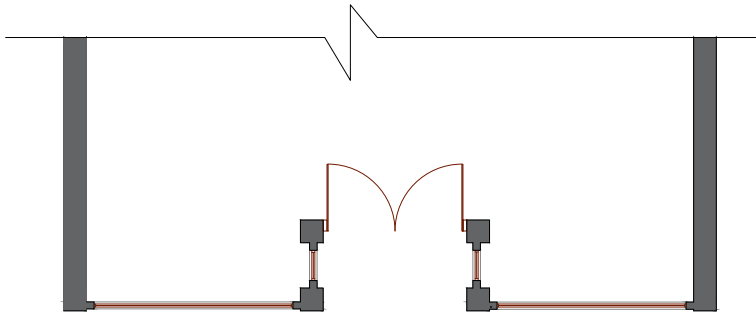


Upper Floors Estimated
Not/Unable To Survey

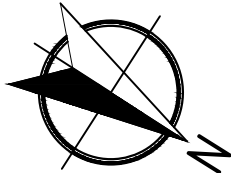

Pre-Existing Front Elevation

1:100 @A4


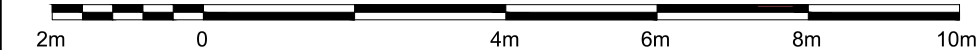


Address 164 Commercial Street, Newport, NP20 1JN.		Rev V2	
Sheet 1/7	Name Pre-Existing Front Elevation.	Date 18/07/2025	
Reference 164CS-1807-PEFE		Drawn By MDF	Checked By SS



Architecture - Town Planning
 Premises Licensing
 E: info@seandse.co.uk
 T: 020 4579 53 00
 M: +44 (0) 7404 765500
 W: www.seandse.co.uk

- Notes
- 1- All work is to be carried out the requirements, to the satisfaction of the Local Authorities. These drawings are for planing purposes only.
 - 2- Responsibility is not accepted for errors made by others in scaling from this drawing. All construction information should be cross checked on the site.
 - 3- All discrepancies and change of design requests by authorities should be reported to surveyor immediately.
 - 4- All drawings to be read in conjunction with the project specification with all works carried out in accordance with the latest British Standards and codes of practice. Planning drawings are not to be used for the purpose of building & installation regulations.
 - 5-It is assumed that all works will be carried out by a competent contractor working, where appropriate, to an approved method statement.
 - 6-It is contractor's responsibility to notify the Building Control and get approval before any work commences.
 - 7- It is contractors responsibility to determine if any wall is load-bearing.
 - 8-Dimensions are based on information provided and existing records.
 - 9-All dimensions are in millimeters.
 - 10-The copyright of this drawing belongs to Se & Se Consultancy Ltd.

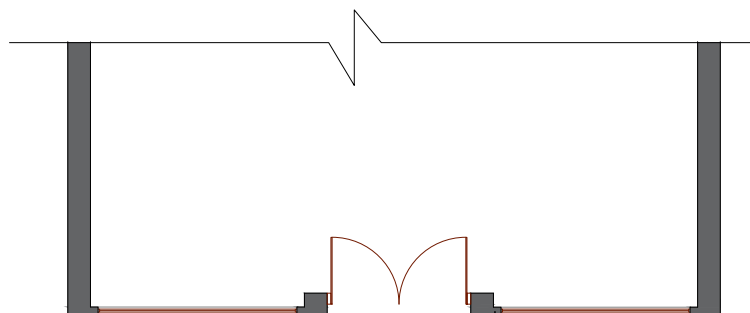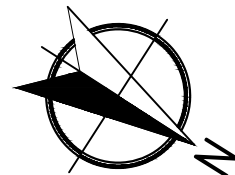


Upper Floors Estimated
Not/Unable To Survey

Advertisement Consent
Application in Progress.

Awning canopy.


Double-Glazed Doors

Aluminum Panel with Flush Glazing.

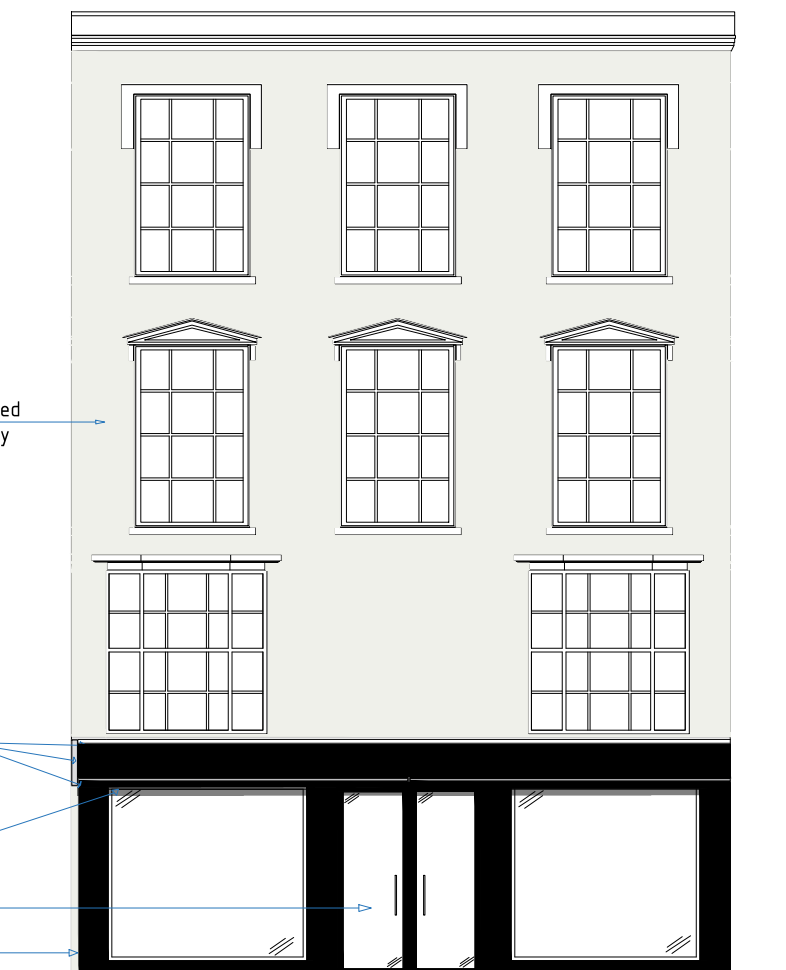



Existing As-built Front Elevation

1:100 @A4

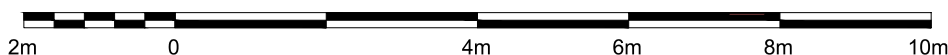

Address 164 Commercial Street, Newport, NP20 1JN.		Rev V2	 Architecture - Town Planning Premises Licensing E: info@seandse.co.uk T: 020 4579 53 00 M: +44 (0) 7404 765500 W: www.seandse.co.uk
Sheet 2/7	Name Existing As-built Front Elevation.	Date 18/07/2025	
Reference 164CS-1807-EFE		Drawn By MDF	
		Checked By SS	

- Notes
- 1- All work is to be carried out the requirements, to the satisfaction of the Local Authorities. These drawings are for planing purposes only.
 - 2- Responsibility is not accepted for errors made by others in scaling from this drawing. All construction information should be cross checked on the site.
 - 3- All discrepancies and change of design requests by authorities should be reported to surveyor immediately.
 - 4- All drawings to be read in conjunction with the project specification with all works carried out in accordance with the latest British Standards and codes of practice. Planning drawings are not to be used for the purpose of building & installation regulations.
 - 5-It is assumed that all works will be carried out by a competent contractor working, where appropriate, to an approved method statement.
 - 6-It is contractor's responsibility to notify the Building Control and get approval before any work commences.
 - 7- It is contractors responsibility to determine if any wall is load-bearing.
 - 8-Dimensions are based on information provided and existing records.
 - 9-All dimensions are in millimeters.
 - 10-The copyright of this drawing belongs to Se & Se Consultancy Ltd.

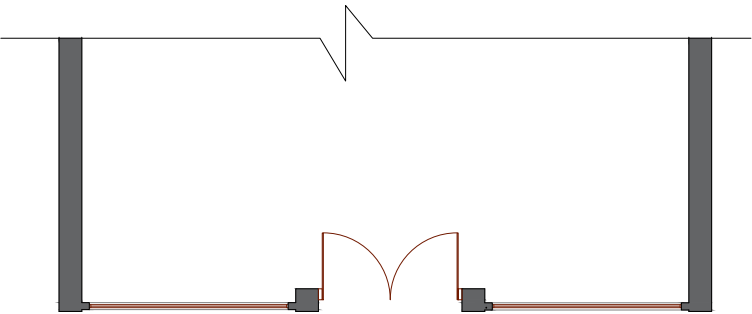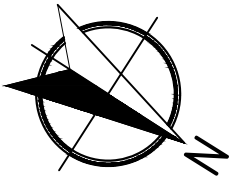

Upper Floors Estimated
Not/Unable To Survey

Advertisement Consent
Application in Progress.


Corbel.

Awning canopy.

Double-Glazed Doors


New Pilasters.

New Wooden Stallriser

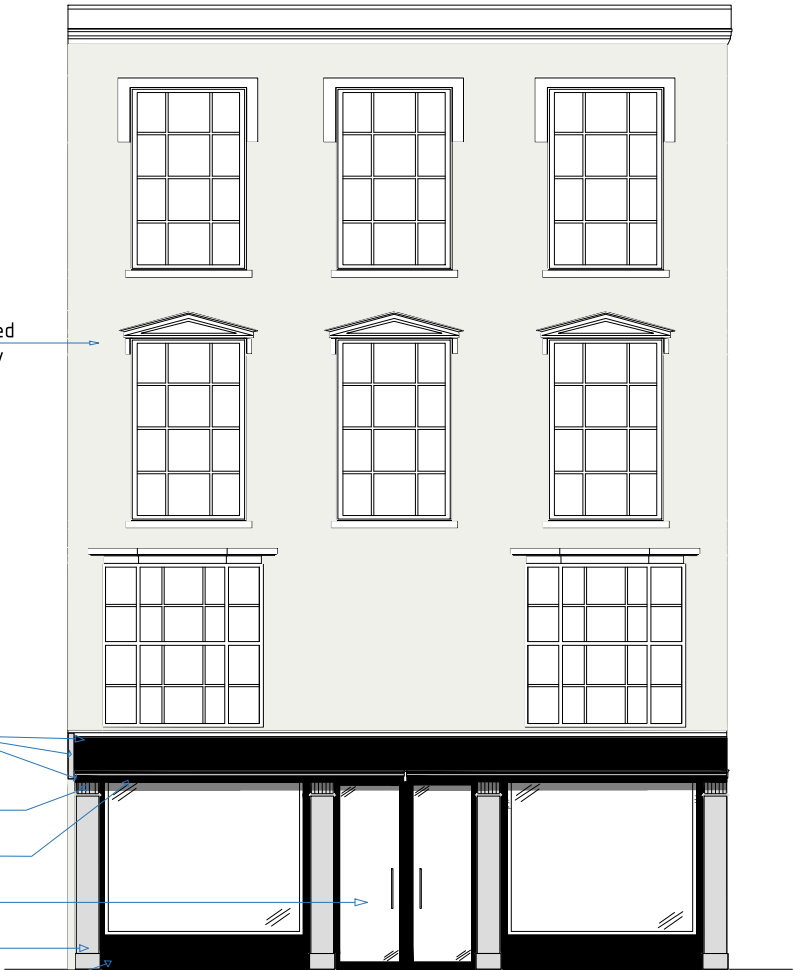

Proposed Front Elevation
(Shutters Open).

1:100 @A4

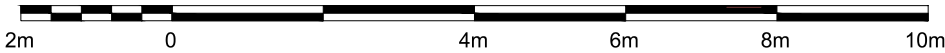

Address
164 Commercial Street, Newport, NP20 1JN.

Sheet
3/7

Reference
164CS-1807-PFE1

Name
Proposed Front Elevation
(Shutter Open).

Rev
V2



Date
18/07/2025

Drawn By
MDF

Checked By
SS

se&se
Architecture - Town Planning
Premises Licensing
E: info@seandse.co.uk
T: 020 4579 53 00
M: +44 (0) 7404 765500
W: www.seandse.co.uk

- Notes
- 1- All work is to be carried out the requirements, to the satisfaction of the Local Authorities. These drawings are for planing purposes only.
 - 2- Responsibility is not accepted for errors made by others in scaling from this drawing. All construction information should be cross checked on the site.
 - 3- All discrepancies and change of design requests by authorities should be reported to surveyor immediately.
 - 4- All drawings to be read in conjunction with the project specification with all works carried out in accordance with the latest British Standards and codes of practice. Planning drawings are not to be used for the purpose of building & installation regulations.
 - 5-It is assumed that all works will be carried out by a competent contractor working, where appropriate, to an approved method statement.
 - 6-It is contractor's responsibility to notify the Building Control and get approval before any work commences.
 - 7- It is contractors responsibility to determine if any wall is load-bearing.
 - 8-Dimensions are based on information provided and existing records.
 - 9-All dimensions are in millimeters.
 - 10-The copyright of this drawing belongs to Se & Se Consultancy Ltd.

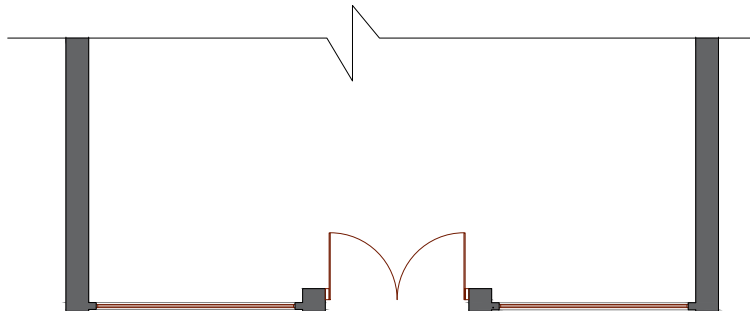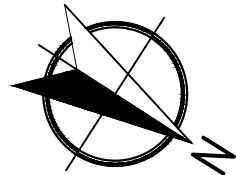

Upper Floors Estimated
Not/Unable To Survey

Advertisement Consent
Application in Progress.

Awning canopy.


Double-Glazed Doors

New Pilasters.

New Wooden Stallriser



Proposed Front Elevation
(Awning Open).

1:100 @A4

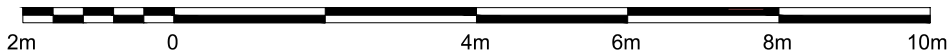

Address 164 Commercial Street, Newport, NP20 1JN.		Rev V2	 Architecture - Town Planning Premises Licensing E: info@seandse.co.uk T: 020 4579 53 00 M: +44 (0) 7404765500 W: www.seandse.co.uk	
Sheet 4/7	Name Proposed Front Elevation (Awning Open).	Date 18/07/2025		
Reference 164CS-1807-PFE2		Drawn By MDF		Checked By SS

- Notes
- 1- All work is to be carried out the requirements, to the satisfaction of the Local Authorities. These drawings are for planing purposes only.
 - 2- Responsibility is not accepted for errors made by others in scaling from this drawing. All construction information should be cross checked on the site.
 - 3- All discrepancies and change of design requests by authorities should be reported to surveyor immediately.
 - 4- All drawings to be read in conjunction with the project specification with all works carried out in accordance with the latest British Standards and codes of practice. Planning drawings are not to be used for the purpose of building & installation regulations.
 - 5-It is assumed that all works will be carried out by a competent contractor working, where appropriate, to an approved method statement.
 - 6-It is contractor's responsibility to notify the Building Control and get approval before any work commences.
 - 7- It is contractors responsibility to determine if any wall is load-bearing.
 - 8-Dimensions are based on information provided and existing records.
 - 9-All dimensions are in millimeters.
 - 10-The copyright of this drawing belongs to Se & Se Consultancy Ltd.

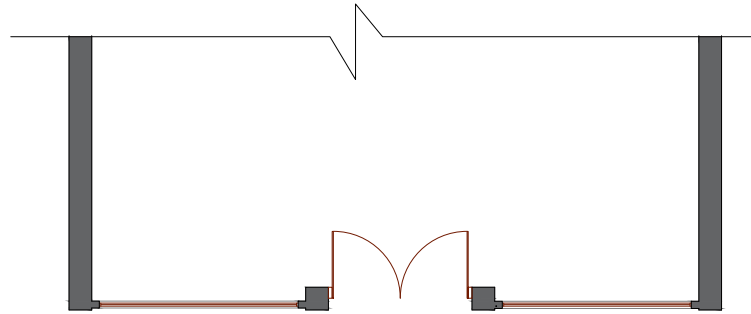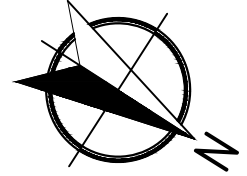

Upper Floors Estimated
Not/Unable To Survey

Advertisement Consent
Application in Progress.

Awning canopy.

Internal Rolling Grid Shutters

Double-Glazed Doors


New Pilasters.

New Wooden Stallriser





Proposed Front Elevation
(Shutters Closed).

1:100 @A4

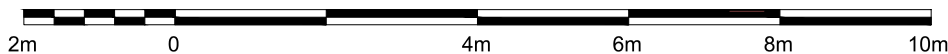


Address 164 Commercial Street, Newport, NP20 1JN.		Rev V2	 Architecture - Town Planning Premises Licensing E: info@seandse.co.uk T: 020 4579 53 00 M: +44 (0) 7404 765500 W: www.seandse.co.uk
Sheet 5/7	Name Proposed Front Elevation (Shutter Closed).	Date 18/07/2025	
Reference 164CS-1807-PFE3		Drawn By MDF	
		Checked By SS	


Notes
1- All work is to be carried out the requirements, to the satisfaction of the Local Authorities. These drawings are for planing purposes only.
2- Responsibility is not accepted for errors made by others in scaling from this drawing. All construction information should be cross checked on the site.
3- All discrepancies and change of design requests by authorities should be reported to surveyor immediately.
4- All drawings to be read in conjunction with the project specification with all works carried out in accordance with the latest British Standards and codes of practice. Planning drawings are not to be used for the purpose of building & installation regulations.
5-It is assumed that all works will be carried out by a competent contractor working, where appropriate, to an approved method statement.
6-It is contractor's responsibility to notify the Building Control and get approval before any work commences.
7- It is contractors responsibility to determine if any wall is load-bearing.
8-Dimensions are based on information provided and existing records.
9-All dimensions are in millimeters.
10-The copyright of this drawing belongs to Se & Se Consultancy Ltd.

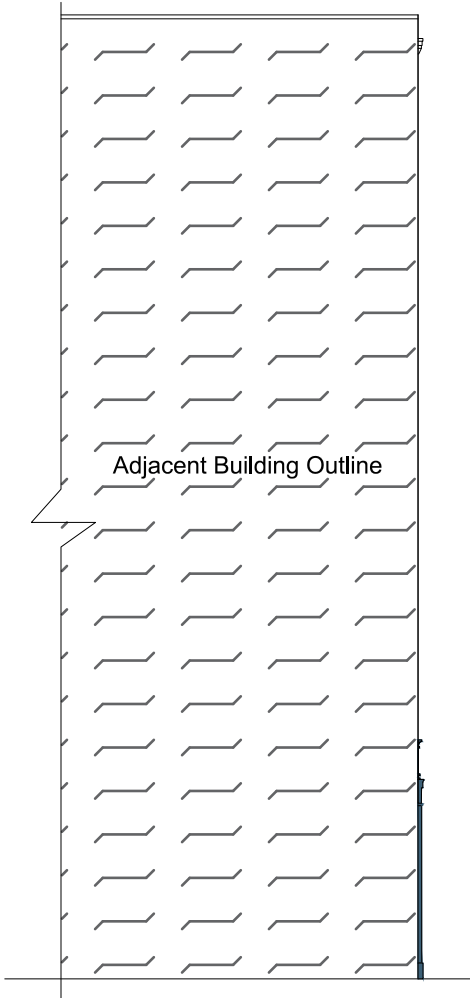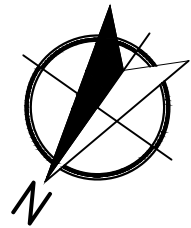

Pre-Existing Right Side Elevation

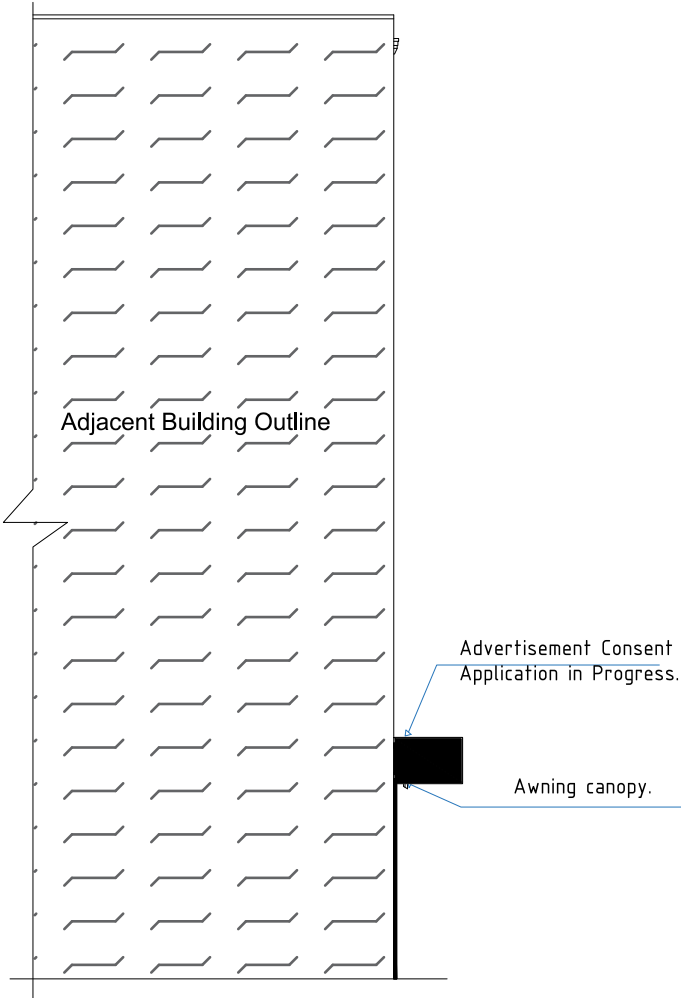

Existing As-built Right Side Elevation


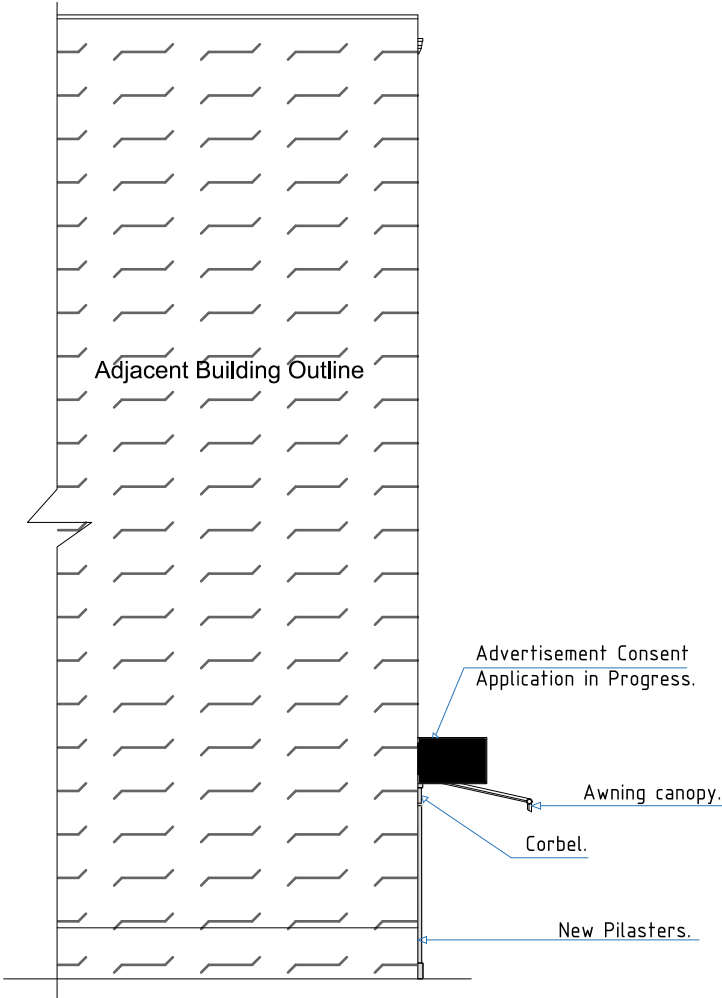


Proposed Right Side Elevation




Address	164 Commercial Street, Newport, NP20 1JN.	Rev	V2	Date	18/07/2025	 Architecture – Town Planning Premises Licensing E: info@seandse.co.uk T: 020 4579 53 00 M: +44 (0) 7404765500 W: www.seandse.co.uk
Sheet	6/7	Pre-existing, Existing As-built & Proposed Right Side Elevation.		Drawn By	MDF	
Reference	164CS-1807-PE/E/PRSE			Checked By	SS	


Notes
1- All work is to be carried out the requirements, to the satisfaction of the Local Authorities. These drawings are for planing purposes only.
2- Responsibility is not accepted for errors made by others in scaling from this drawing. All construction information should be cross checked on the site.
3- All discrepancies and change of design requests by authorities should be reported to surveyor immediately.
4- All drawings to be read in conjunction with the project specification with all works carried out in accordance with the latest British Standards and codes of practice. Planning drawings are not to be used for the purpose of building & installation regulations.
5-It is assumed that all works will be carried out by a competent contractor working, where appropriate, to an approved method statement.
6-It is contractor's responsibility to notify the Building Control and get approval before any work commences.
7- It is contractors responsibility to determine if any wall is load-bearing.
8-Dimensions are based on information provided and existing records.
9-All dimensions are in millimeters.
10-The copyright of this drawing belongs to Se & Se Consultancy Ltd.

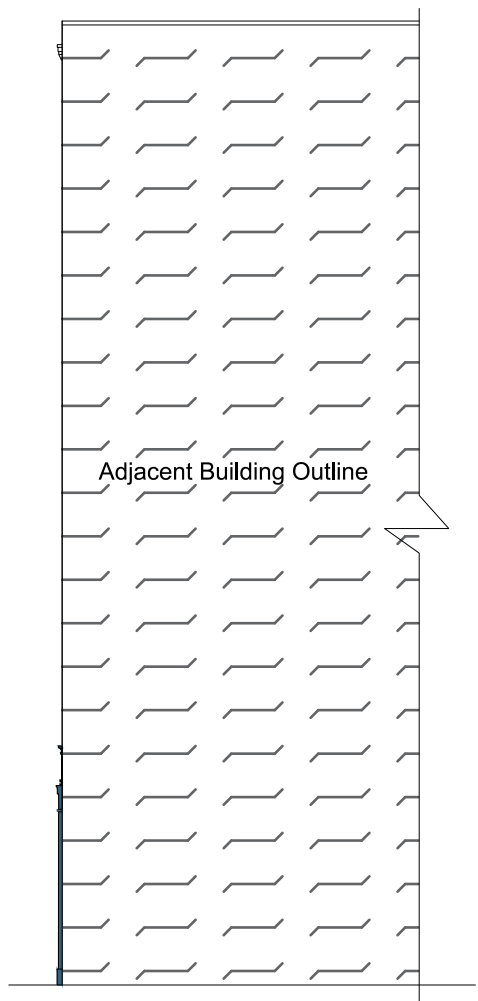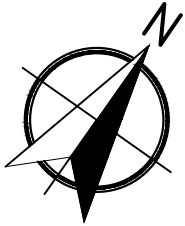

Pre-Existing Left Side Elevation

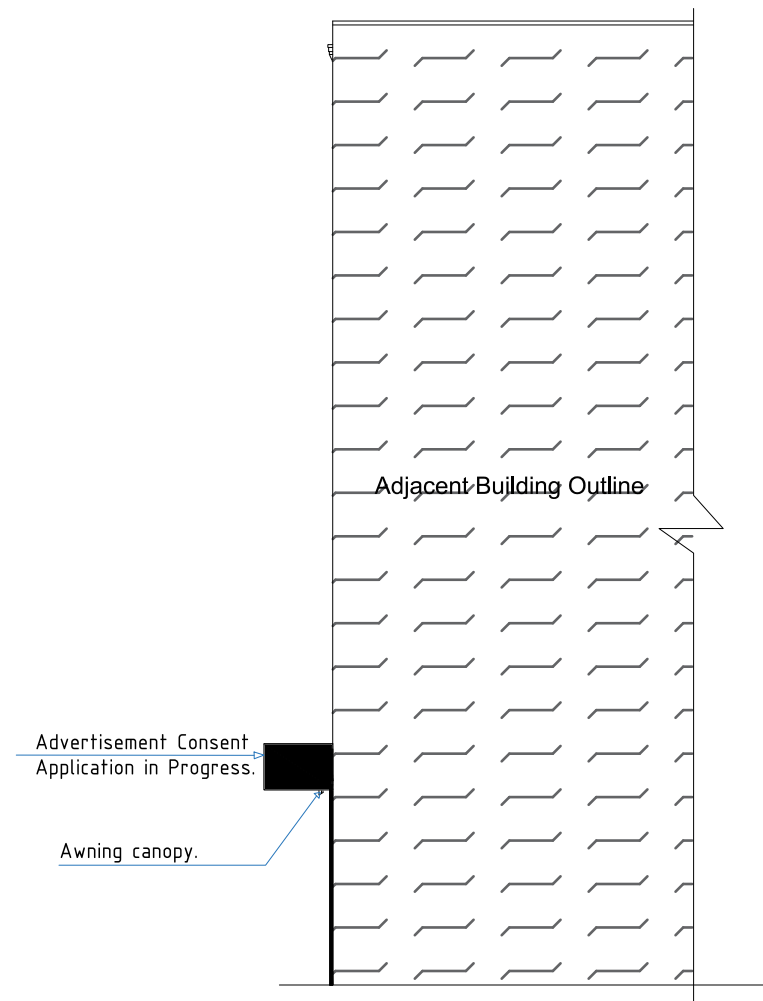

Existing As-built Left Side Elevation.

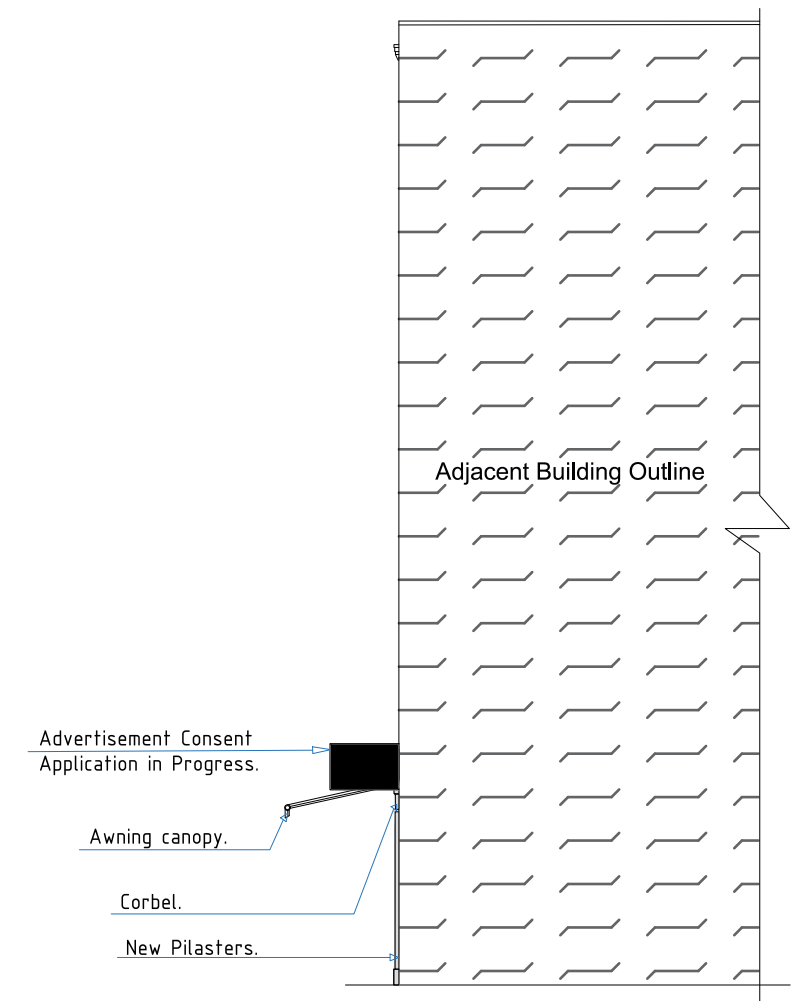

Proposed Left Side Elevation



Address	164 Commercial Street, Newport, NP20 1JN.	Rev	V2	Date	18/07/2025	 Architecture – Town Planning Premises Licensing E: info@seandse.co.uk T: 020 4579 53 00 M: +44 (0) 7404765500 W: www.seandse.co.uk
Sheet	7/7	Pre-existing, Existing As-built & Proposed Left Side Elevation.	Drawn By	MDF		
Reference	164CS-1807-PE/E/PLSE.		Checked By	SS		