



- Notes
- 1- All work is to be carried out the requirements, to the satisfaction of the Local Authorities. These drawings are for planing purposes only.
 - 2- Responsibility is not accepted for errors made by others in scaling from this drawing. All construction information should be cross checked on the site.
 - 3- All discrepancies and change of design requests by authorities should be reported to surveyor immediately.
 - 4- All drawings to be read in conjunction with the project specification with all works carried out in accordance with the latest British Standards and codes of practice. Planning drawings are not to be used for the purpose of building & installation regulations.
 - 5-It is assumed that all works will be carried out by a competent contractor working, where appropriate, to an approved method statement.
 - 6-It is contractor's responsibility to notify the Building Control and get approval before any work commences.
 - 7- It is contractors responsibility to determine if any wall is load-bearing.
 - 8-All dimensions are in millimeters.
 - 9-The copyright of this drawing belongs to Se & Se Consultancy Ltd.

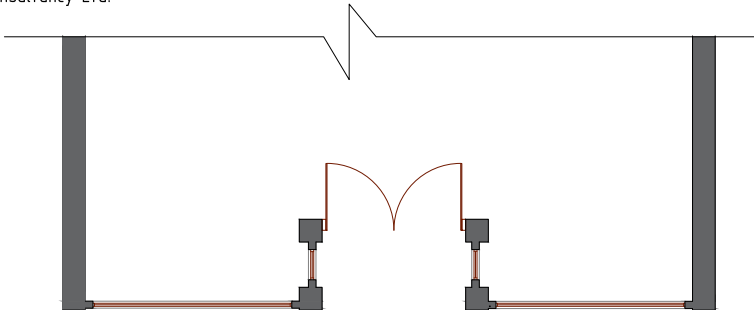


Upper Floors Estimated
Not/Unable To Survey

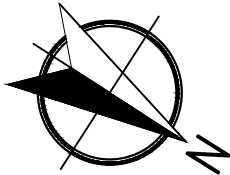

Pre-Existing Front Elevation



1:100 @A4

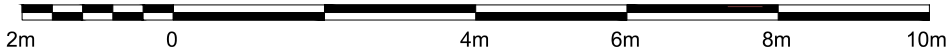

Address 164 Commercial Street, Newport, NP20 1JN.		Rev V1		 Architecture - Town Planning Premises Licensing E: info@seandse.co.uk T: 020 4579 53 00 M: +44 (0) 7404765500 W: www.seandse.co.uk
Sheet 1/7	Name	Date 10/07/2025		
Reference 164CS-1007-PEFE	Pre-Existing Front Elevation.	Drawn By MDF	Checked By SS	

Notes

- 1- All work is to be carried out the requirements, to the satisfaction of the Local Authorities. These drawings are for planing purposes only.
- 2- Responsibility is not accepted for errors made by others in scaling from this drawing. All construction information should be cross checked on the site.
- 3- All discrepancies and change of design requests by authorities should be reported to surveyor immediately.
- 4- All drawings to be read in conjunction with the project specification with all works carried out in accordance with the latest British Standards and codes of practice. Planning drawings are not to be used for the purpose of building & installation regulations.
- 5-It is assumed that all works will be carried out by a competent contractor working, where appropriate, to an approved method statement.
- 6-It is contractor's responsibility to notify the Building Control and get approval before any work commences.
- 7- It is contractors responsibility to determine if any wall is load-bearing.
- 8-All dimensions are in millimeters.
- 9-The copyright of this drawing belongs to Se & Se Consultancy Ltd.

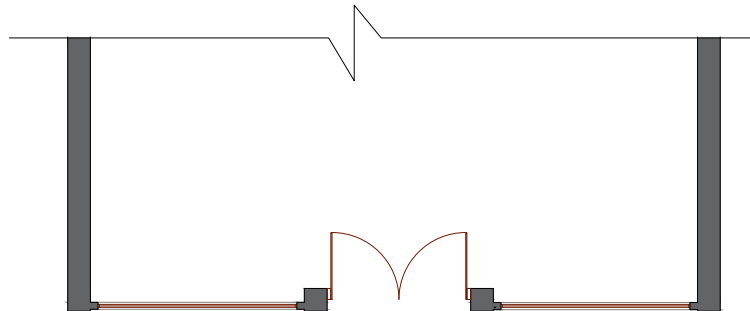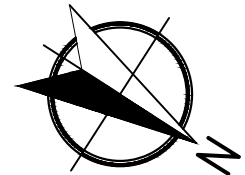

Upper Floors Estimated
Not/Unable To Survey

Advertisement Consent
Application in Progress.

Awning canopy.


Double-Glazed Doors

Aluminum Panel with Flush Glazing.



Existing As-built Front Elevation



1:100 @A4

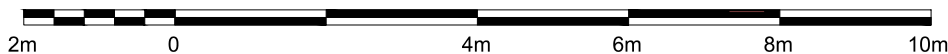

Address 164 Commercial Street, Newport, NP20 1JN.		Rev V1	 Architecture - Town Planning Premises Licensing E: info@seandse.co.uk T: 020 4579 53 00 M: +44 (0) 7404 765500 W: www.seandse.co.uk
Sheet 2/7	Name Existing As-built Front Elevation.	Date 10/07/2025	
Reference 164CS-1007-PFE		Drawn By MDF	
		Checked By SS	

Notes

- 1- All work is to be carried out the requirements, to the satisfaction of the Local Authorities. These drawings are for planing purposes only.
- 2- Responsibility is not accepted for errors made by others in scaling from this drawing. All construction information should be cross checked on the site.
- 3- All discrepancies and change of design requests by authorities should be reported to surveyor immediately.
- 4- All drawings to be read in conjunction with the project specification with all works carried out in accordance with the latest British Standards and codes of practice. Planning drawings are not to be used for the purpose of building & installation regulations.
- 5-It is assumed that all works will be carried out by a competent contractor working, where appropriate, to an approved method statement.
- 6-It is contractor's responsibility to notify the Building Control and get approval before any work commences.
- 7- It is contractors responsibility to determine if any wall is load-bearing.
- 8-All dimensions are in millimeters.
- 9-The copyright of this drawing belongs to Se & Se Consultancy Ltd.

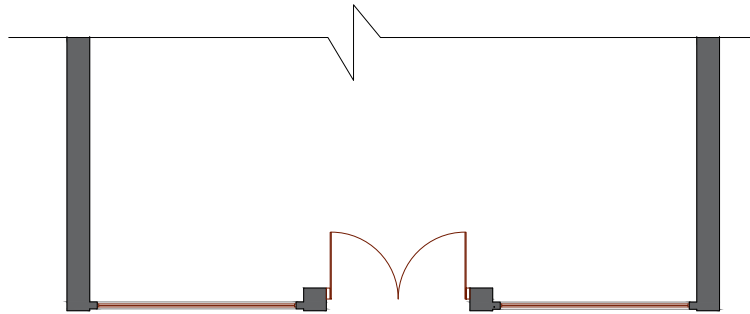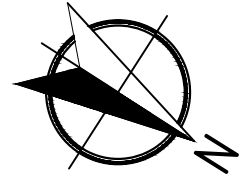

Upper Floors Estimated
Not/Unable To Survey

Advertisement Consent
Application in Progress.


Corbel.

Awning canopy.

Double-Glazed Doors


New Pilasters.

New Wooden Stallriser

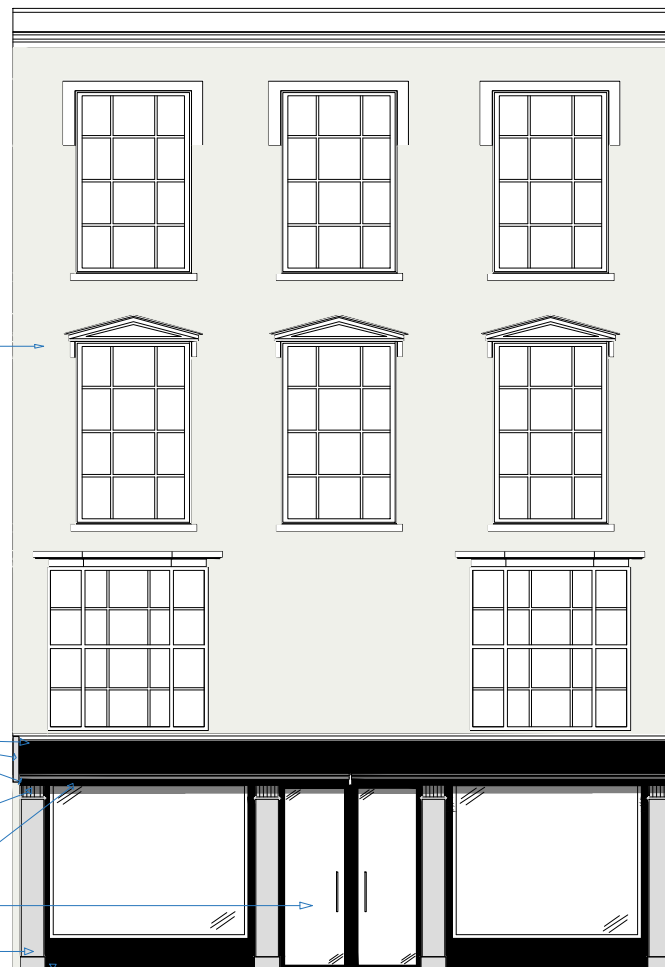

Proposed Front Elevation
(Shutters Open).



1:100 @A4

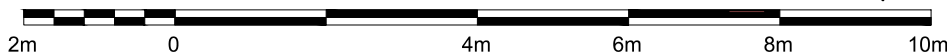

Address 164 Commercial Street, Newport, NP20 1JN.		Rev V1	 Architecture - Town Planning Premises Licensing E: info@seandse.co.uk T: 020 4579 53 00 M: +44 (0) 7404 765500 W: www.seandse.co.uk
Sheet 3/7	Name Proposed Front Elevation (Shutter Open).	Date	
Reference 164CS-1007-PFE1		Drawn By MDF Checked By SS	

Notes

- 1- All work is to be carried out the requirements, to the satisfaction of the Local Authorities. These drawings are for planing purposes only.
- 2- Responsibility is not accepted for errors made by others in scaling from this drawing. All construction information should be cross checked on the site.
- 3- All discrepancies and change of design requests by authorities should be reported to surveyor immediately.
- 4- All drawings to be read in conjunction with the project specification with all works carried out in accordance with the latest British Standards and codes of practice. Planning drawings are not to be used for the purpose of building & installation regulations.
- 5-It is assumed that all works will be carried out by a competent contractor working, where appropriate, to an approved method statement.
- 6-It is contractor's responsibility to notify the Building Control and get approval before any work commences.
- 7- It is contractors responsibility to determine if any wall is load-bearing.
- 8-All dimensions are in millimeters.
- 9-The copyright of this drawing belongs to Se & Se Consultancy Ltd.

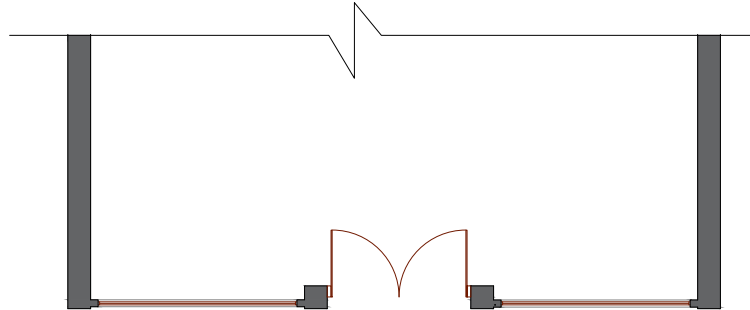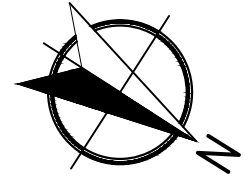

Upper Floors Estimated
Not/Unable To Survey

Advertisement Consent
Application in Progress.

Awning canopy.

Double-Glazed Doors


New Pilasters.

New Wooden Stallriser





Proposed Front Elevation
(Awning Open).

1:100 @A4

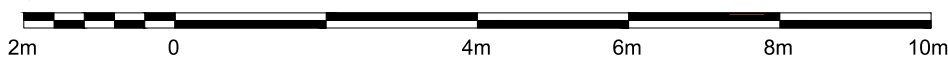

Address 164 Commercial Street, Newport, NP20 1JN.		Rev V1	 Architecture - Town Planning Premises Licensing E: info@seandse.co.uk T: 020 4579 53 00 M: +44 (0) 7404 765500 W: www.seandse.co.uk
Sheet 4/7	Name Proposed Front Elevation (Awning Open).	Date 10/07/2025	
Reference 164CS-1007-PFE2		Drawn By MDF Checked By SS	

- Notes
- 1- All work is to be carried out the requirements, to the satisfaction of the Local Authorities. These drawings are for planing purposes only.
 - 2- Responsibility is not accepted for errors made by others in scaling from this drawing. All construction information should be cross checked on the site.
 - 3- All discrepancies and change of design requests by authorities should be reported to surveyor immediately.
 - 4- All drawings to be read in conjunction with the project specification with all works carried out in accordance with the latest British Standards and codes of practice. Planning drawings are not to be used for the purpose of building & installation regulations.
 - 5-It is assumed that all works will be carried out by a competent contractor working, where appropriate, to an approved method statement.
 - 6-It is contractor's responsibility to notify the Building Control and get approval before any work commences.
 - 7- It is contractors responsibility to determine if any wall is load-bearing.
 - 8-All dimensions are in millimeters.
 - 9-The copyright of this drawing belongs to Se & Se Consultancy Ltd.

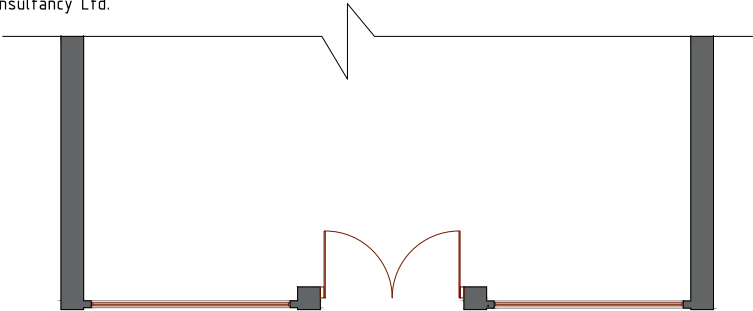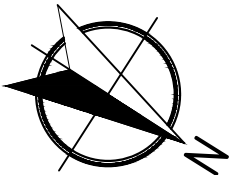

Upper Floors Estimated
Not/Unable To Survey

Advertisement Consent
Application in Progress.

Awning canopy.

Internal Rolling Grid Shutters

Double-Glazed Doors


New Pilasters.

New Wooden Stallriser





Proposed Front Elevation
(Shutters Closed).

1:100 @A4

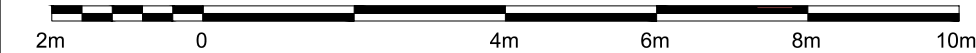


Address 164 Commercial Street, Newport, NP20 1JN.		Rev V1		 Architecture - Town Planning Premises Licensing E: info@seandse.co.uk T: 020 4579 53 00 M: +44 (0) 7404765500 W: www.seandse.co.uk	
Sheet 5/7	Name Proposed Front Elevation (Shutter Closed).		Date 10/07/2025		
Reference 164CS-1007-PFE3			Drawn By MDF		Checked By SS


- Notes
- 1- All work is to be carried out the requirements, to the satisfaction of the Local Authorities. These drawings are for planing purposes only.
 - 2- Responsibility is not accepted for errors made by others in scaling from this drawing. All construction information should be cross checked on the site.
 - 3- All discrepancies and change of design requests by authorities should be reported to surveyor immediately.
 - 4- All drawings to be read in conjunction with the project specification with all works carried out in accordance with the latest British Standards and codes of practice. Planning drawings are not to be used for the purpose of building & installation regulations.
 - 5-It is assumed that all works will be carried out by a competent contractor working, where appropriate, to an approved method statement.
 - 6-It is contractor's responsibility to notify the Building Control and get approval before any work commences.
 - 7- It is contractors responsibility to determine if any wall is load-bearing.
 - 8-All dimensions are in millimeters.
 - 9-The copyright of this drawing belongs to Se & Se Consultancy Ltd.

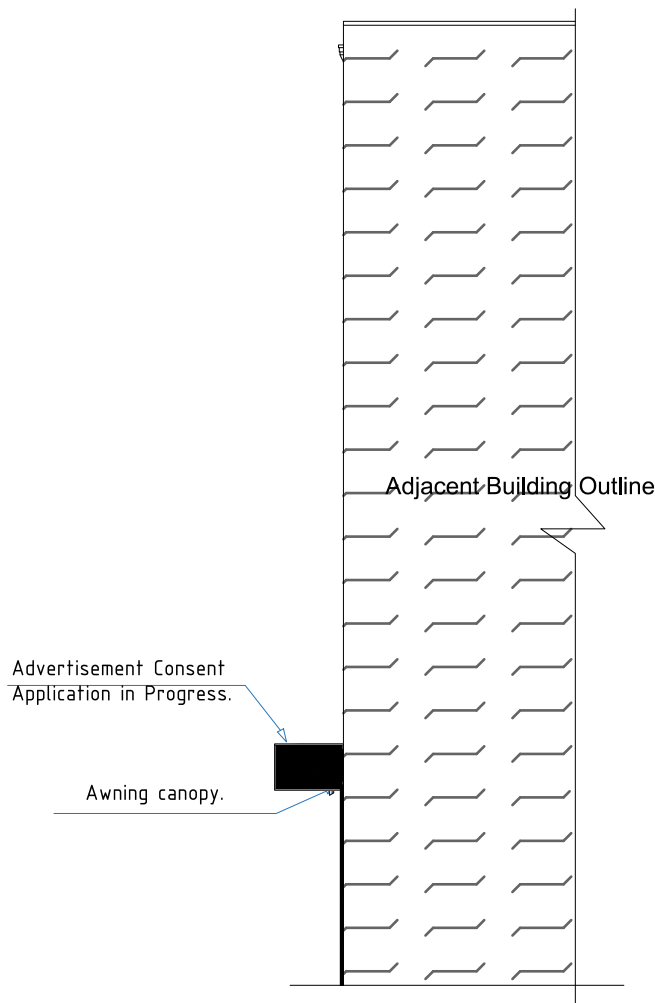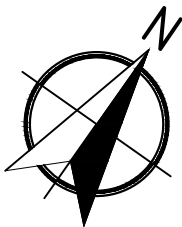

Existing As-built Left Side Elevation.


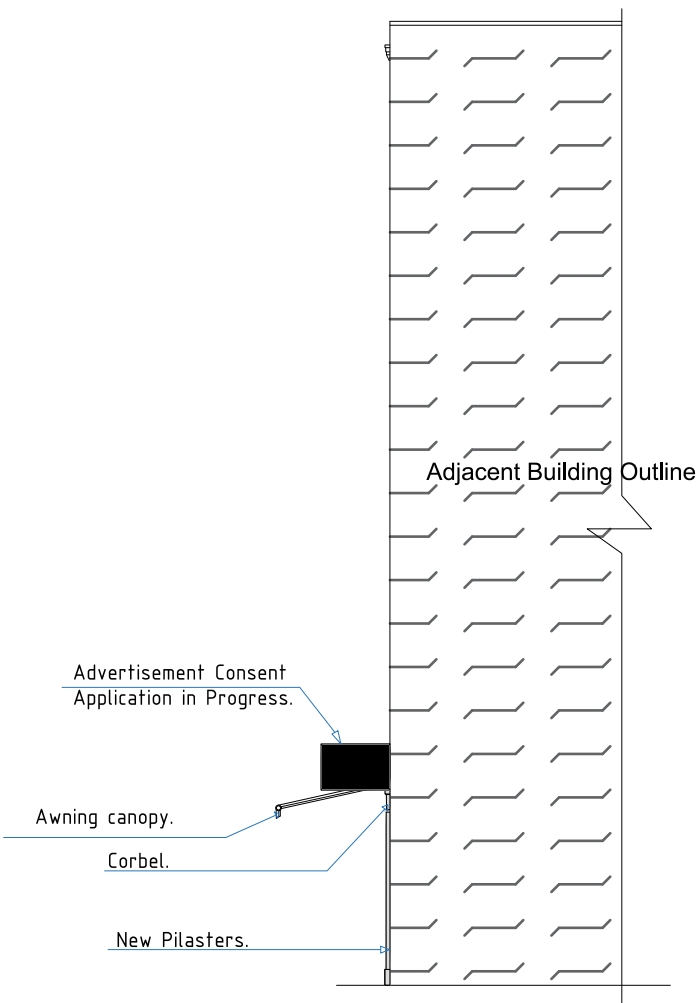


Proposed Left Side Elevation

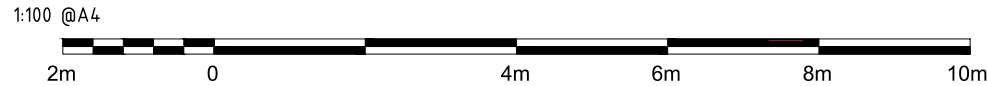


Address 164 Commercial Street, Newport, NP20 1JN.		Rev V1		 Architecture – Town Planning Premises Licensing E: info@seandse.co.uk T: 020 4579 53 00 M: +44 (0) 7404765500 W: www.seandse.co.uk
Sheet 6/7		Date 10/07/2025		
Reference 164CS-1007-EPLSE.		Drawn By MDF	Checked By SS	
		Name Existing As-built & Proposed Left Side Elevation.		


- Notes
- 1- All work is to be carried out the requirements, to the satisfaction of the Local Authorities. These drawings are for planing purposes only.
 - 2- Responsibility is not accepted for errors made by others in scaling from this drawing. All construction information should be cross checked on the site.
 - 3- All discrepancies and change of design requests by authorities should be reported to surveyor immediately.
 - 4- All drawings to be read in conjunction with the project specification with all works carried out in accordance with the latest British Standards and codes of practice. Planning drawings are not to be used for the purpose of building & installation regulations.
 - 5-It is assumed that all works will be carried out by a competent contractor working, where appropriate, to an approved method statement.
 - 6-It is contractor's responsibility to notify the Building Control and get approval before any work commences.
 - 7- It is contractors responsibility to determine if any wall is load-bearing.
 - 8-All dimensions are in millimeters.
 - 9-The copyright of this drawing belongs to Se & Se Consultancy Ltd.

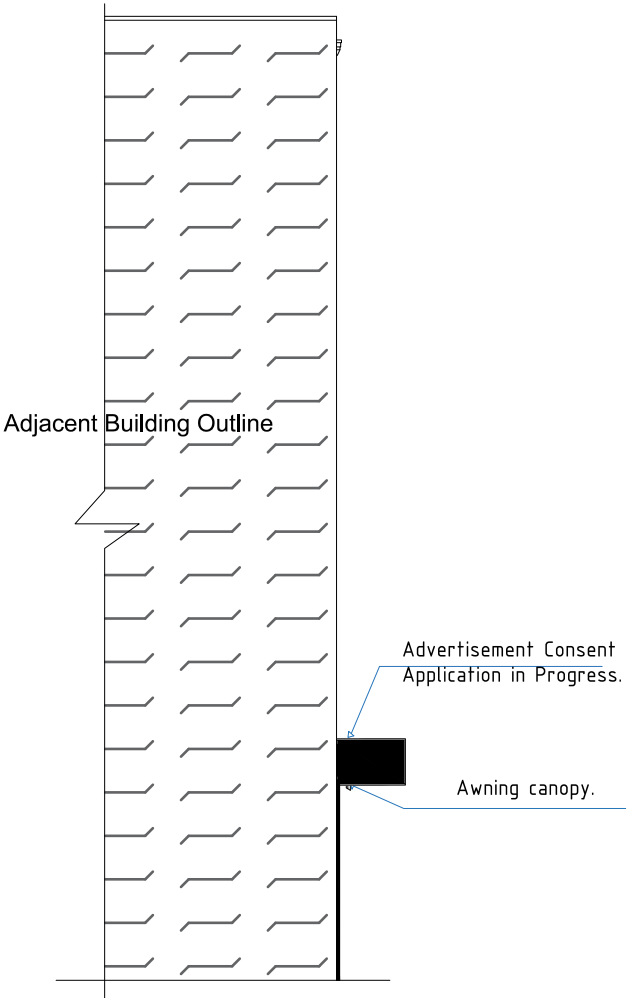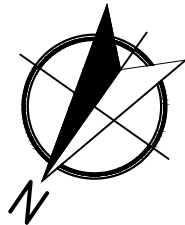

Existing As-built Right Side Elevation

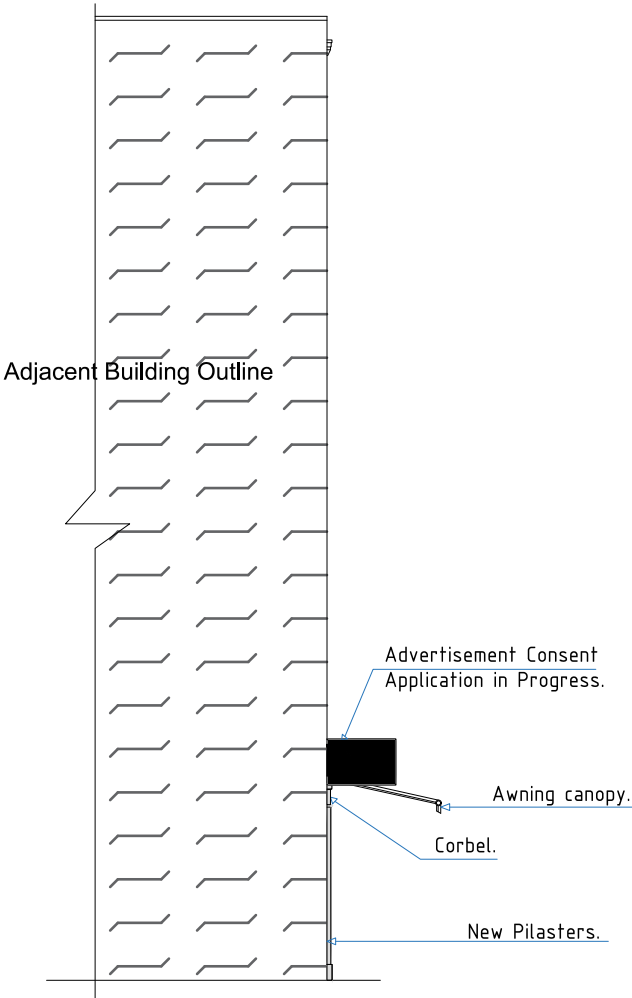

Proposed Right Side Elevation

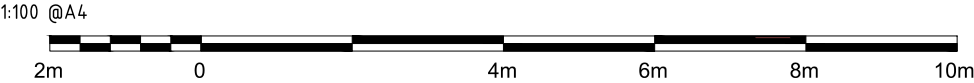

Address 164 Commercial Street, Newport, NP20 1JN.		Rev V1	 Architecture - Town Planning Premises Licensing E: info@seandse.co.uk T: 020 4579 53 00 M: +44 (0) 7404 765500 W: www.seandse.co.uk
Sheet 7/7	Name Existing As-built & Proposed Right Side Elevation.	Date 10/07/2025	
Reference 164CS-1007-EPRSE		Drawn By MDF	Checked By SS