



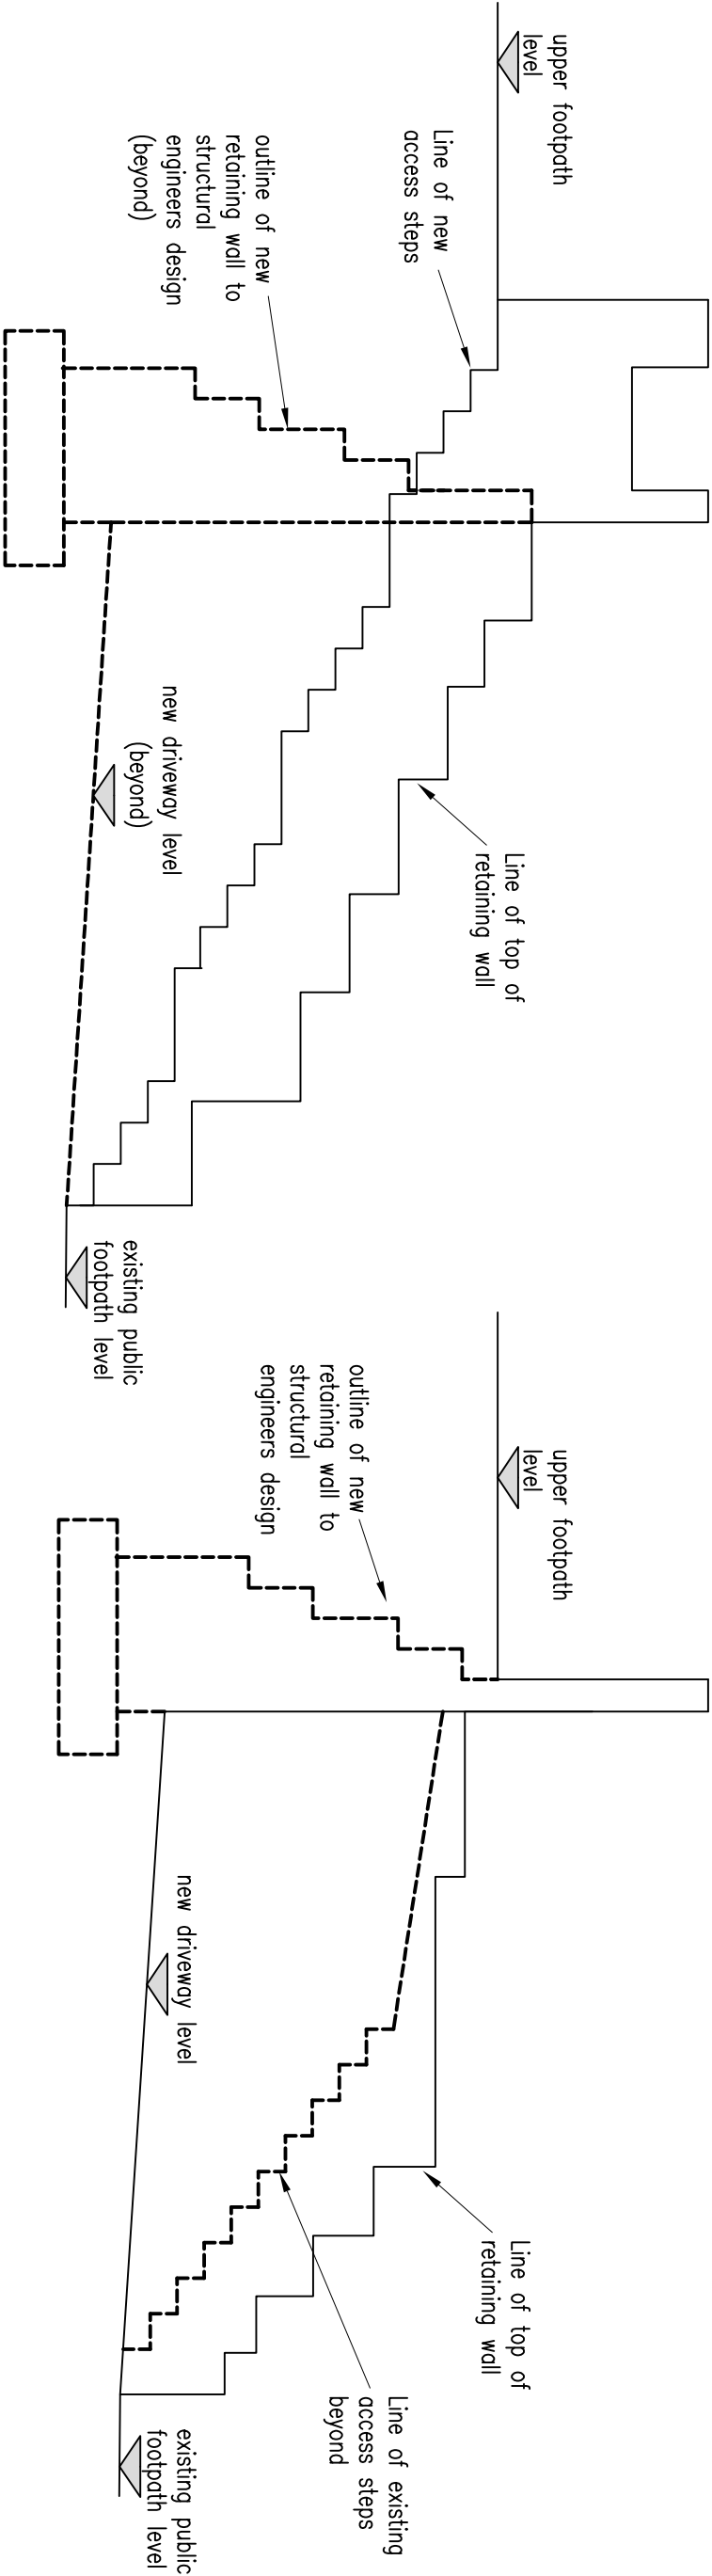

ELEVATION 1-1 AS BUILT

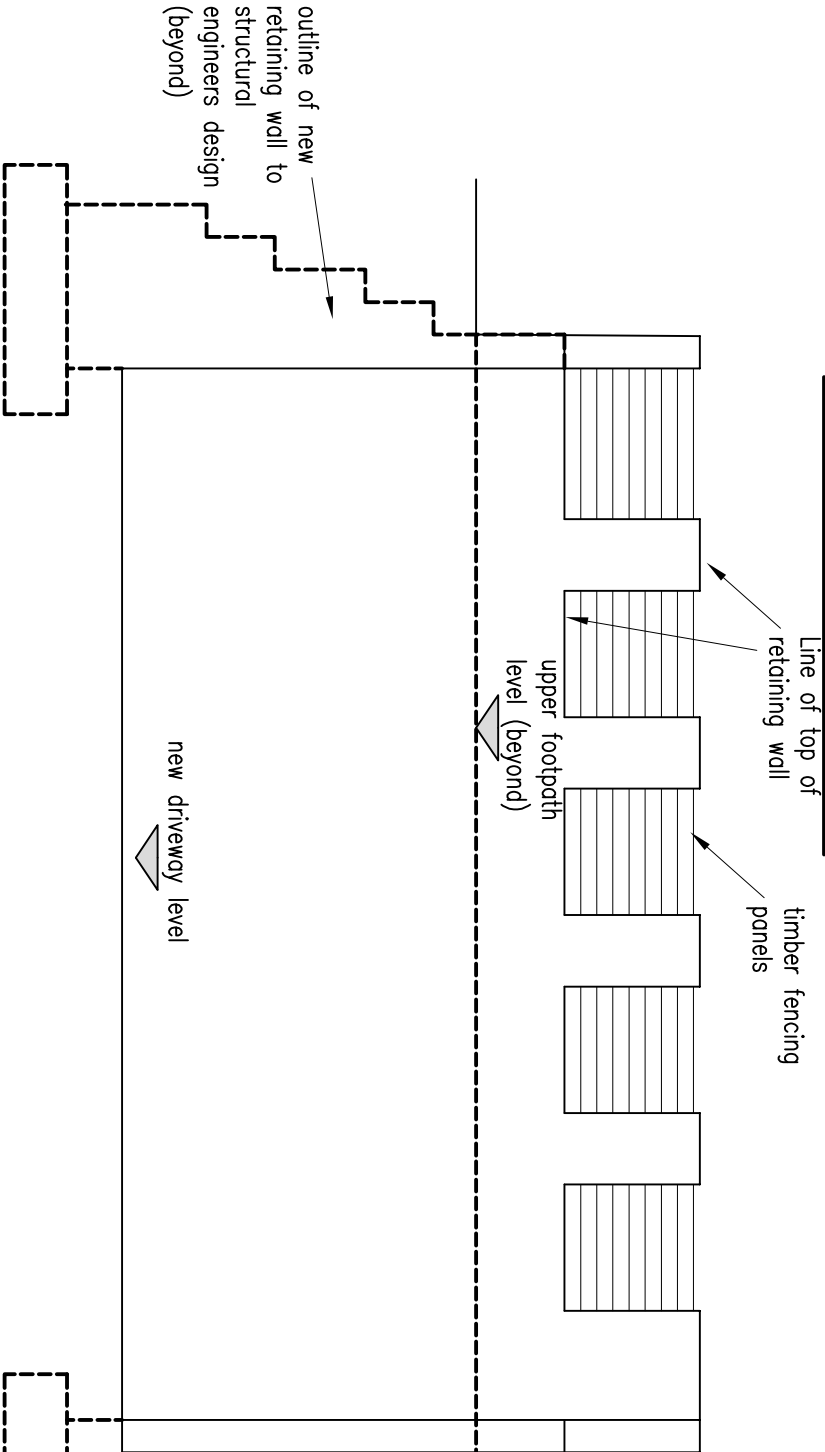

ELEVATION 2-2 AS BUILT

NOTE
NEW RETAINING WALLS TO BE BUILT ON DENSE
CONCRETE BLOCKWORK AND FACED WITH SMOOTHCAST
RENDER AND PAINTED FINISHES. COLOUR OF PAINT TO
MATCH THE FRONT ELEVATION OF MAIN HOUSE

ELEVATION 3-3 AS BUILT

STRUCTURAL ENGINEERS & BUILDING CONSULTANTS		18 Rosslyn Road, Newport, South Wales NP19 8PD Office: (01633) 668308 Mobile: 07845 416086 Email: carreg@virginmedia.com		Project Client Mrs J Ascott		Drawing Title ELEVATIONS AS BUILT		Revision		Description		Date		Scale @ A3 1:50 @ A3		Drawn By WJS	
CARRÉG DESIGN		18 Rosslyn Road, Newport, South Wales NP19 8PD Office: (01633) 668308 Mobile: 07845 416086 Email: carreg@virginmedia.com		Project Title 36 RONALD ROAD NEWPORT GWENT		ELEVATIONS AS BUILT		REV/A		NOTE ADDED		19/02/2025				Date DEC 2024	
								REV/B								Checked	
								REV/C								Job No. 24-085	
																Drawing No. 03	
																Rev.No. A	