


10 cm - Caution as distortion can occur.
ALL CIVIL DIMENSIONS ARE IN METRES - ALL STRUCTURAL DIMENSIONS ARE IN MILLIMETRES - ALL LEVELS ARE IN METRES.

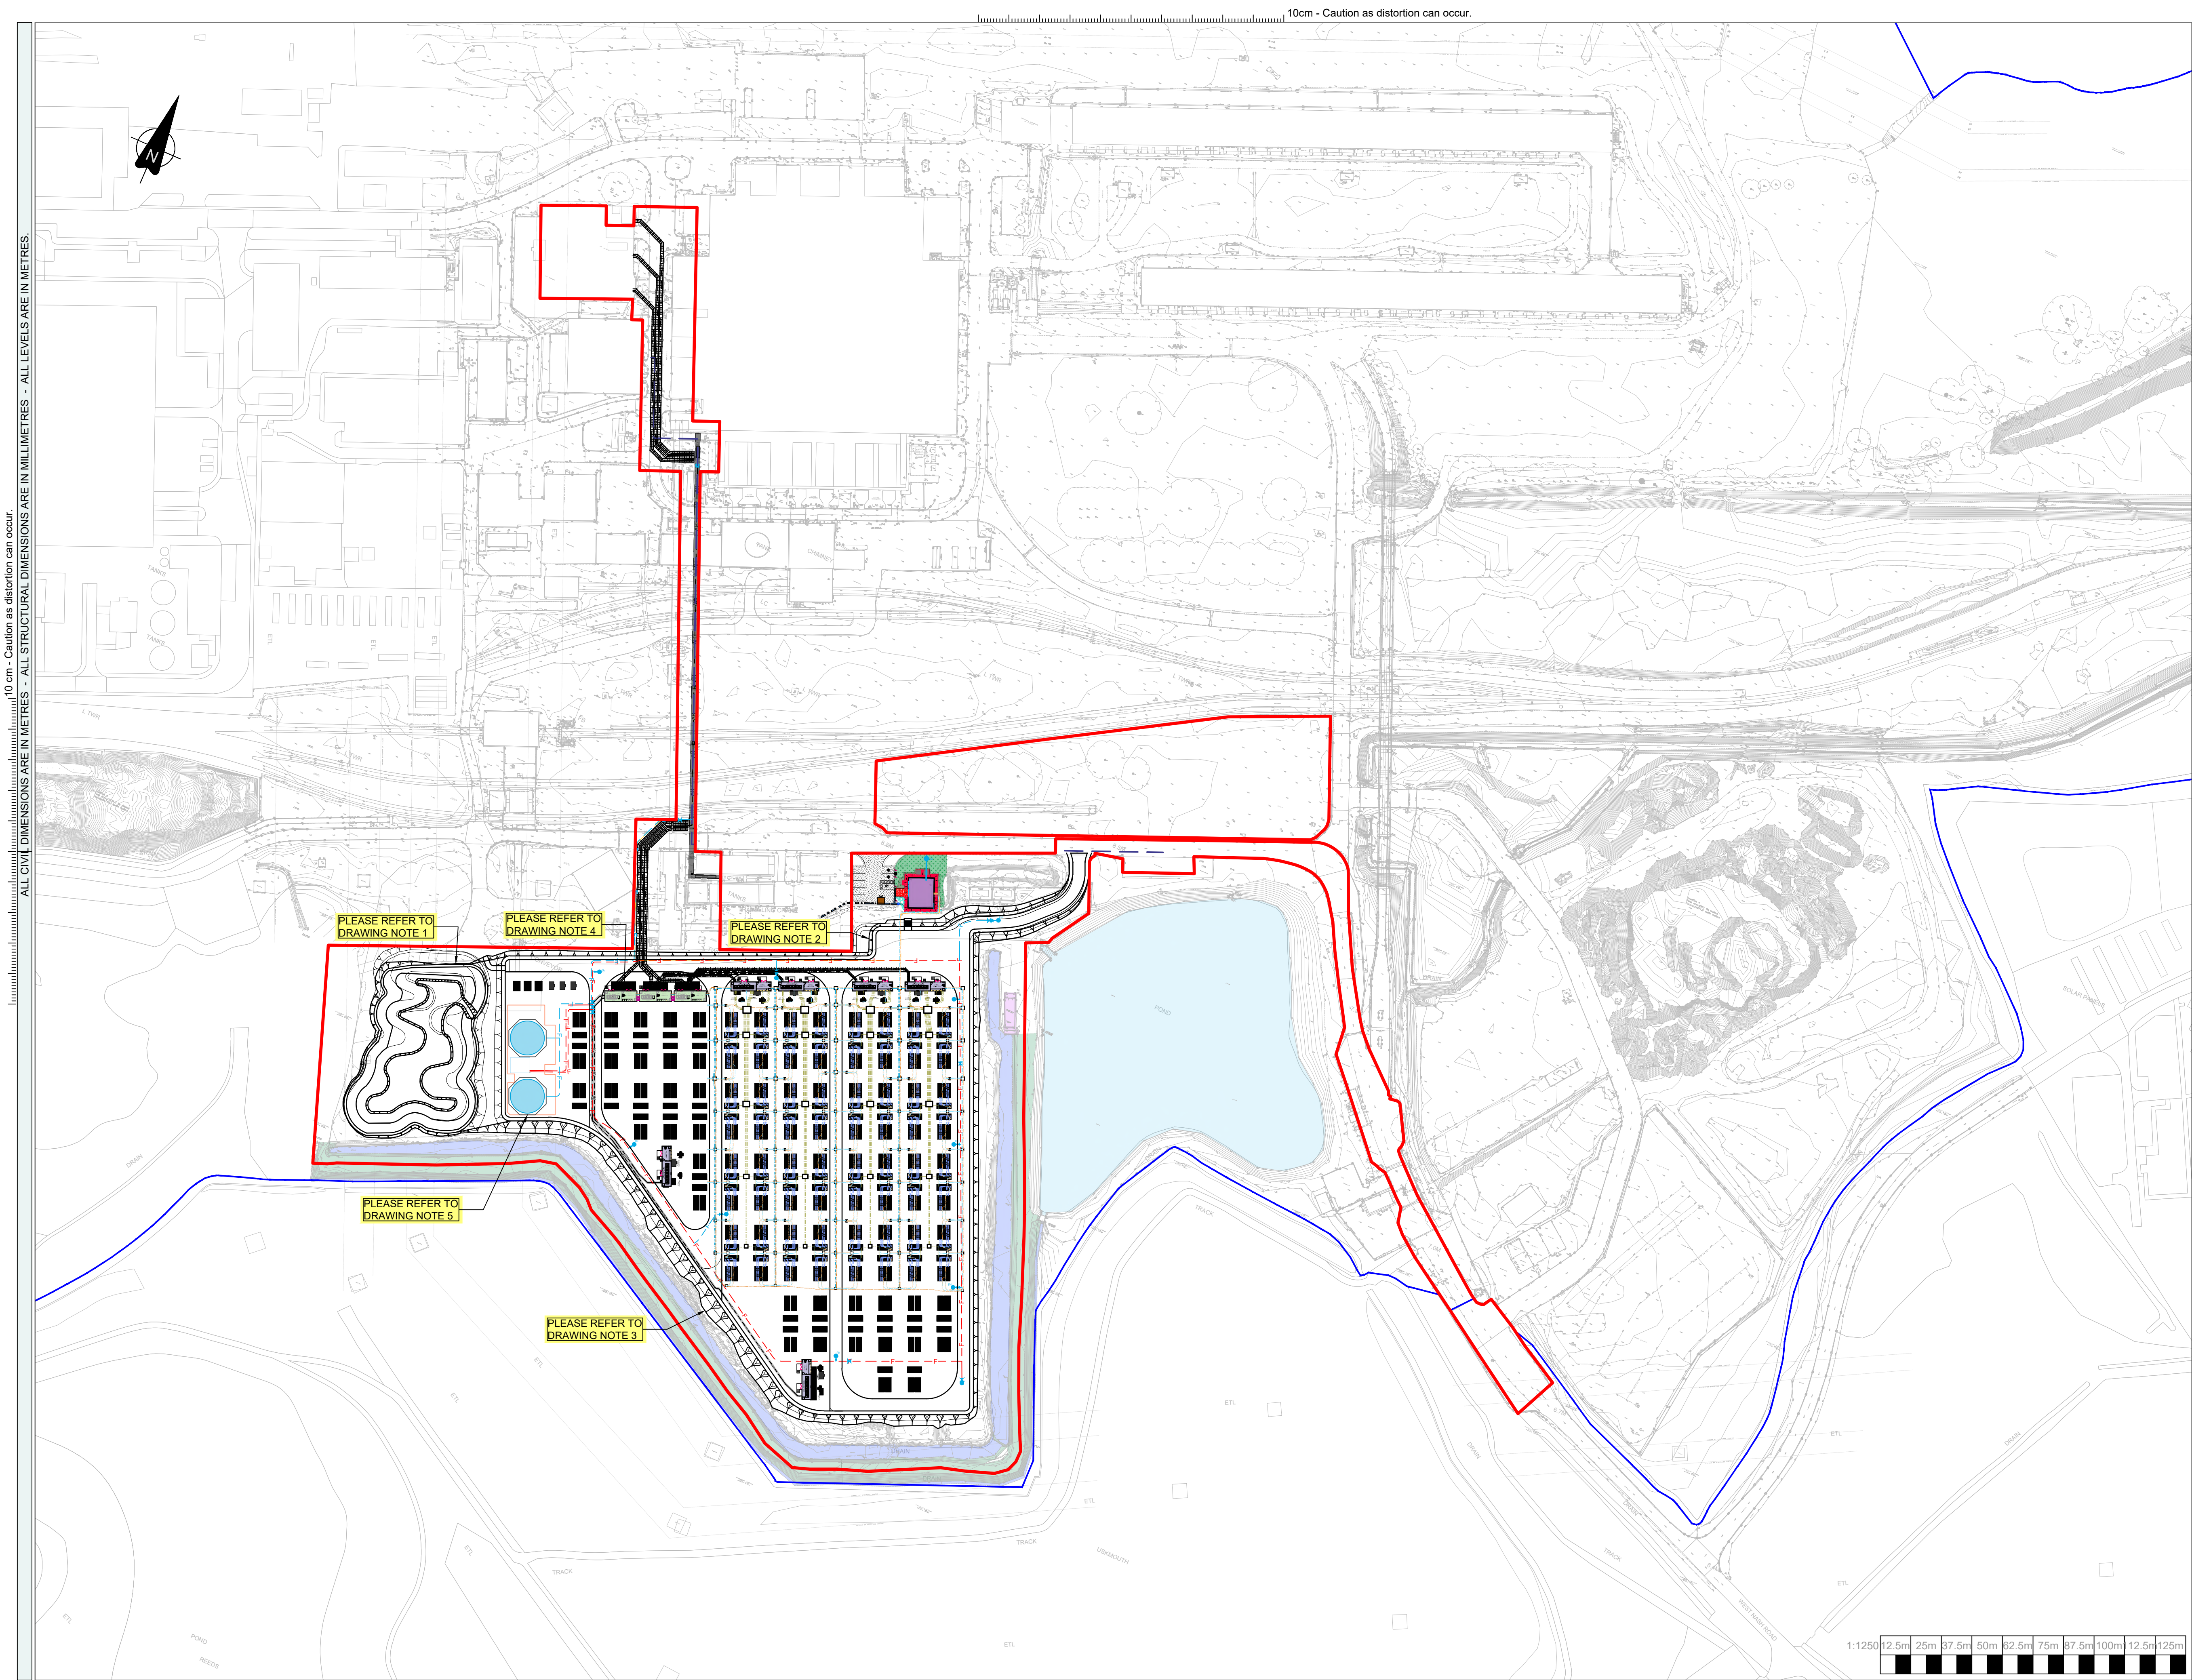

- DRAWING NOTES:**
1. POND DESIGN HAS BEEN AMENDED TO BE LOCATED OUTSIDE OF ELECTRICAL PYLON EXCLUSION ZONE, WHILST MAINTAINING REQUIRED ATTENUATION VOLUMES.
 2. PROPOSED BESS PLATEAU EARTHWORKS ADJUSTED TO BE LOCATED AWAY FROM EXISTING COAL HOPPER CHUTE, AND THEREFORE LIMIT ANY IMPACT ON STRUCTURE.
 3. PROPOSED BESS PLATEAU EARTHWORKS ADJUSTED TO REMOVE REQUIREMENTS FOR GEOTEXTILE REINFORCEMENT. EARTHWORK SLOPES SLACKENED TO REDUCE THE REINFORCEMENT REQUIRED.
 4. SUBSTATION BUILDING POSITIONS ADJUSTED TO AVOID CLASHING WITH OTHER PROPOSED INFRASTRUCTURE, AND ENSURE DESIGNS ARE COORDINATED.
 5. PROPOSED FIRE WATER TANKS HAVE BEEN ADDED TO THE DESIGNS. FIRE WATER TANKS ARE REQUIRED, AS TANKS WITHIN THE EXISTING FIRE BUILDING ARE NO LONGER BEING UTILISED FOR THE PROJECT.

S2-P2.0	REVERTED TO APPROVED RED LINE BOUNDARY	12/07/25	WN	1	SL	DDH
S2-P1.0	ORIGINAL ISSUE	06/06/25	WN	1	SL	DDH
REV	DESCRIPTION	DATE	DRW	CHK	APP	

Drawing Title:

**SERIES 100 - PRELIMINARY
COMPARISON TO ORIGINAL DESIGN
GENERAL ARRANGEMENT**

Burroughs Project No.: 50679-00 Scale: 1:500 Original Paper Size: A1

Drawing Number: **50679-BUR-XX-XX-DR-Z-0001**

Status: S2 - FOR INFORMATION

Revision: P2.0 - REVERTED TO APPROVED RLB

This document is copyright of Burroughs Ltd. Use figured measurements only! DO NOT SCALE FROM DRAWING. Verify all dimensions prior to construction. Immediately report any discrepancies to Burroughs and if in doubt ASK. This drawing should be read in conjunction with all other associated project information