




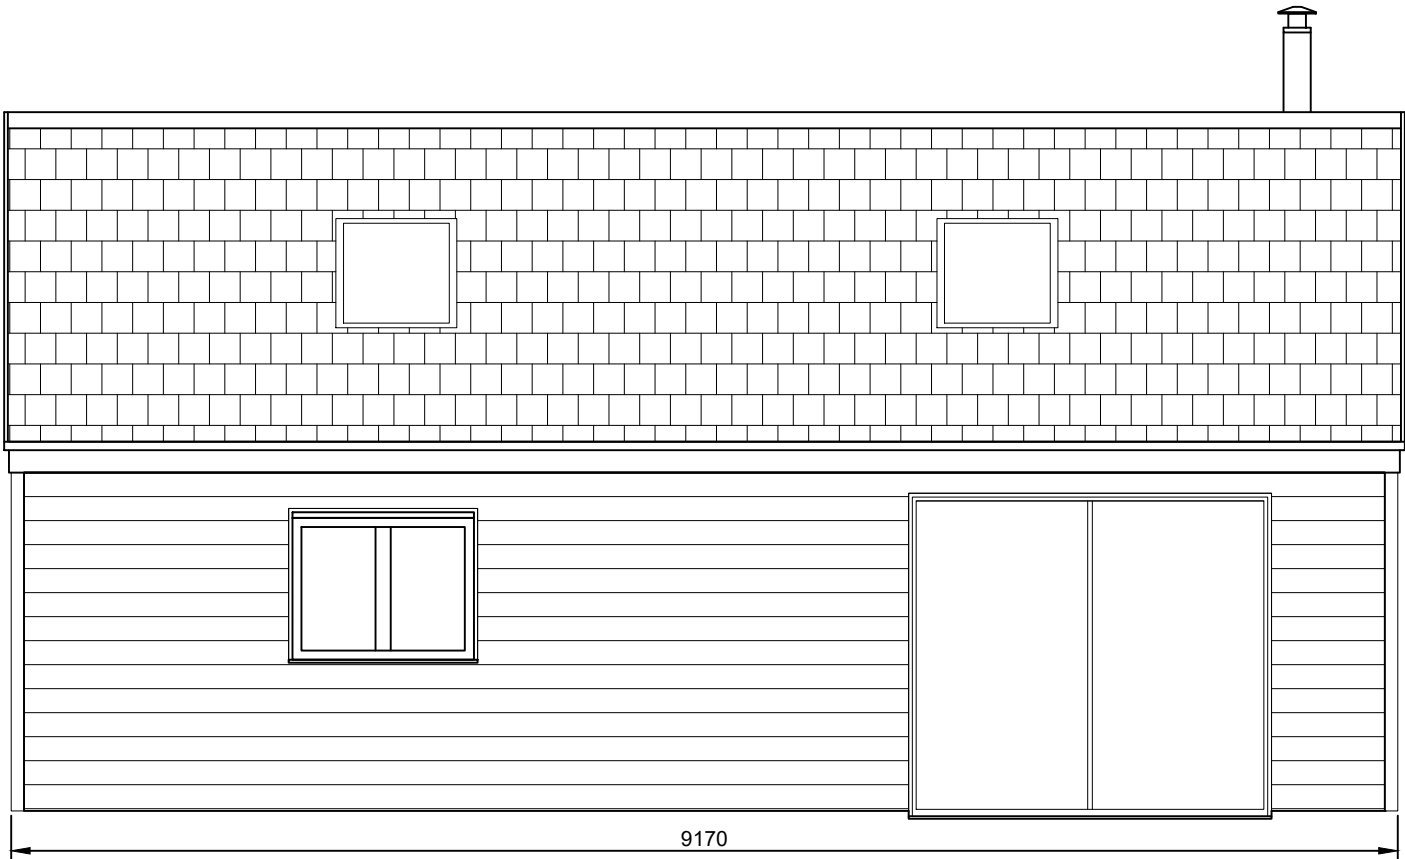


EAST ELEVATION

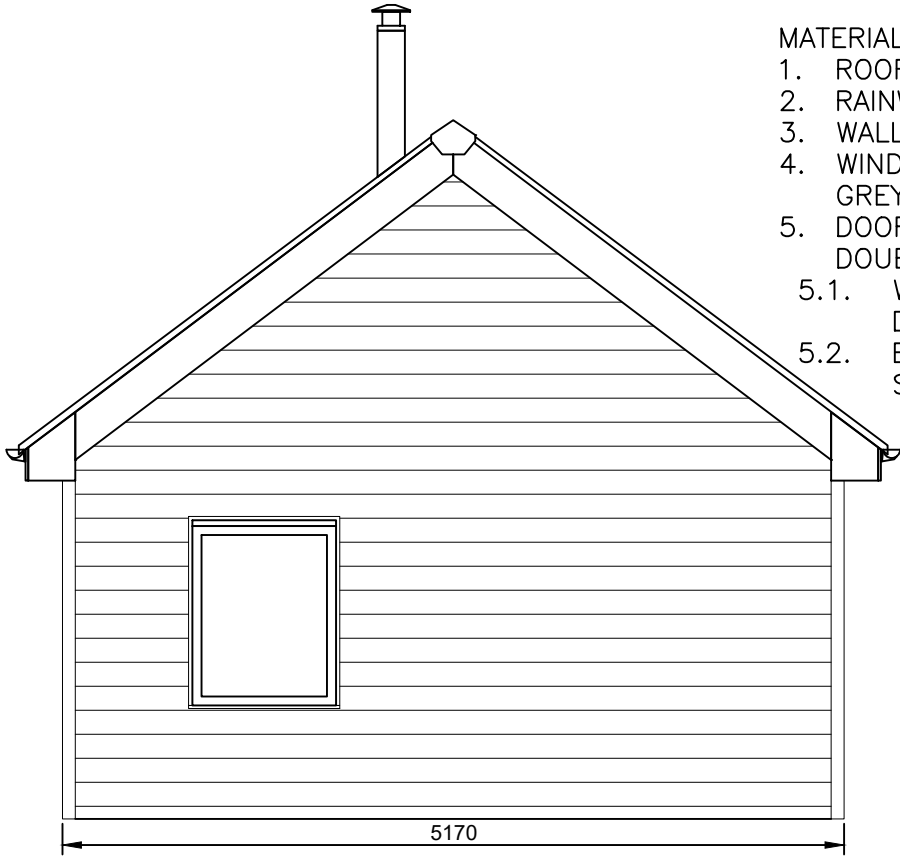

NORTH ELEVATION

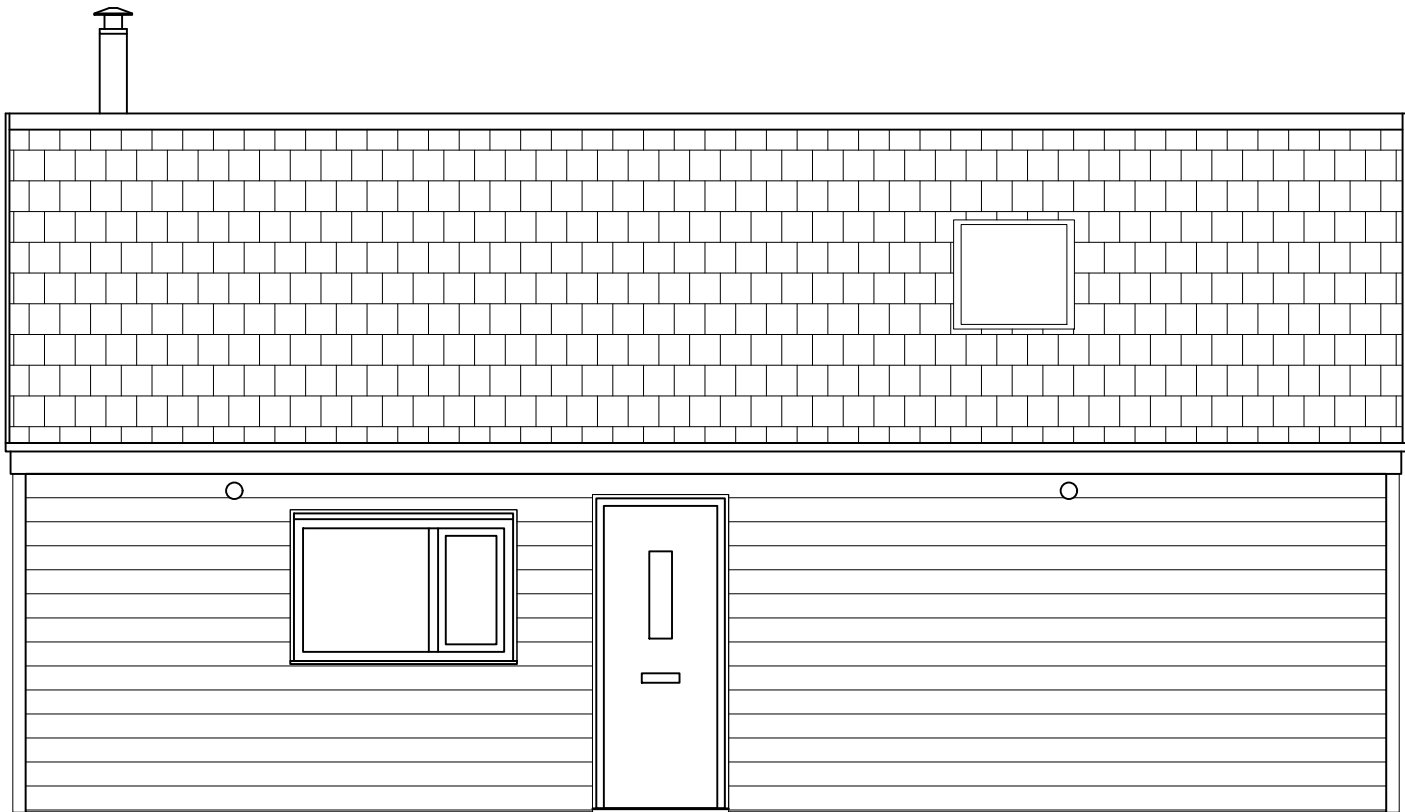




WEST ELEVATION

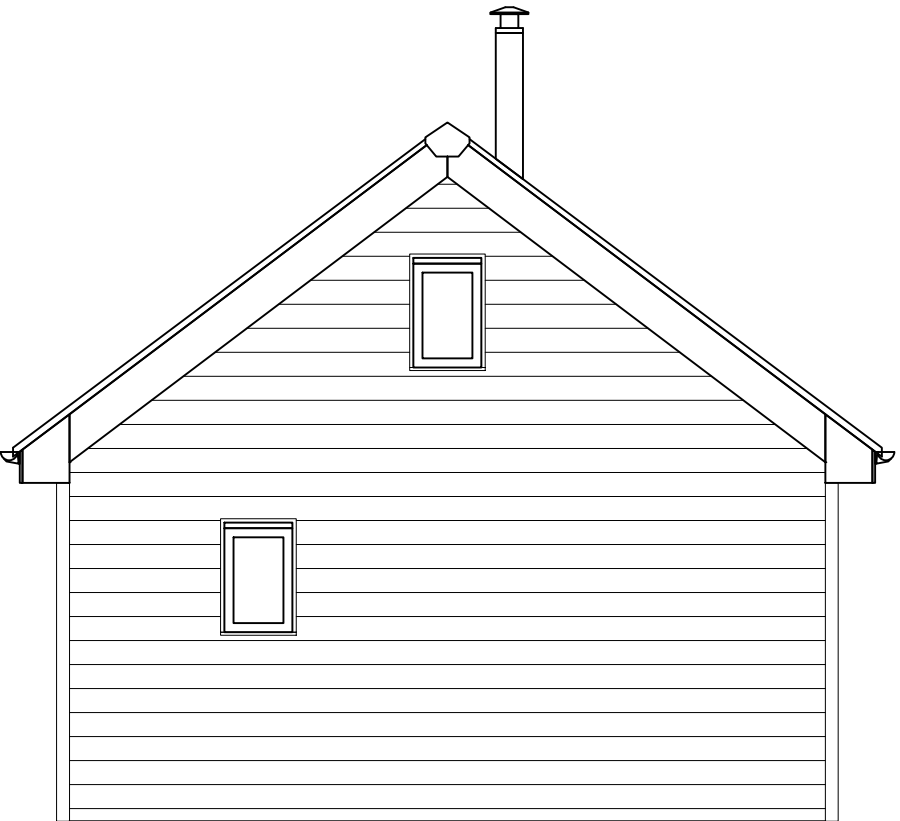

SOUTH ELEVATION

- MATERIALS:
- 1. ROOF – TRADITIONAL GREY SLATE
  - 2. RAINWATER GOODS – BLACK UPVC
  - 3. WALLS – CEDAR CLADDING
  - 4. WINDOWS AND SKYLIGHTS – DARK GREY EDGED TRIPLE GLAZING
  - 5. DOORS – DARK GREY EDGED DOUBLE GLAZING
  - 5.1. WESTERN ELEVATION – SINGLE DOOR WITH WINDOW
  - 5.2. EASTERN ELEVATION – DOUBLE SLIDING GLASS DOORS

| REVISION HISTORY                                                                                                                                                                                                               |                   |              |                 |
|--------------------------------------------------------------------------------------------------------------------------------------------------------------------------------------------------------------------------------|-------------------|--------------|-----------------|
| REV:                                                                                                                                                                                                                           | DESCRIPTION:      |              | DATE:           |
| 01                                                                                                                                                                                                                             | As built drawings |              | 04/05/26        |
| <div>William Laws      OS Grid Ref:</div> <div>The Grove      ST 41183 90696</div> <div>Bowden's Lane</div> <div>Penhow      Latitude: 51° 36' 43" N</div> <div>Caldicot      Longitude: 2° 51' 2" W</div> <div>NP26 3AA</div> |                   |              |                 |
| PROJECT TITLE:                                                                                                                                                                                                                 |                   |              |                 |
| THE GROVE, NP26 3AA                                                                                                                                                                                                            |                   |              |                 |
| DRAWING TITLE:                                                                                                                                                                                                                 |                   |              |                 |
| LODGE FLOOR PLANS & ELEVATIONS AS BUILT                                                                                                                                                                                        |                   |              |                 |
| SCALE AT A3:<br>1:50                                                                                                                                                                                                           | DATE:<br>04/05/26 | DRAWN:<br>WL | SHEET:<br>1/1   |
| DRAWING NO:<br>GRO_004                                                                                                                                                                                                         |                   |              | REVISION:<br>01 |

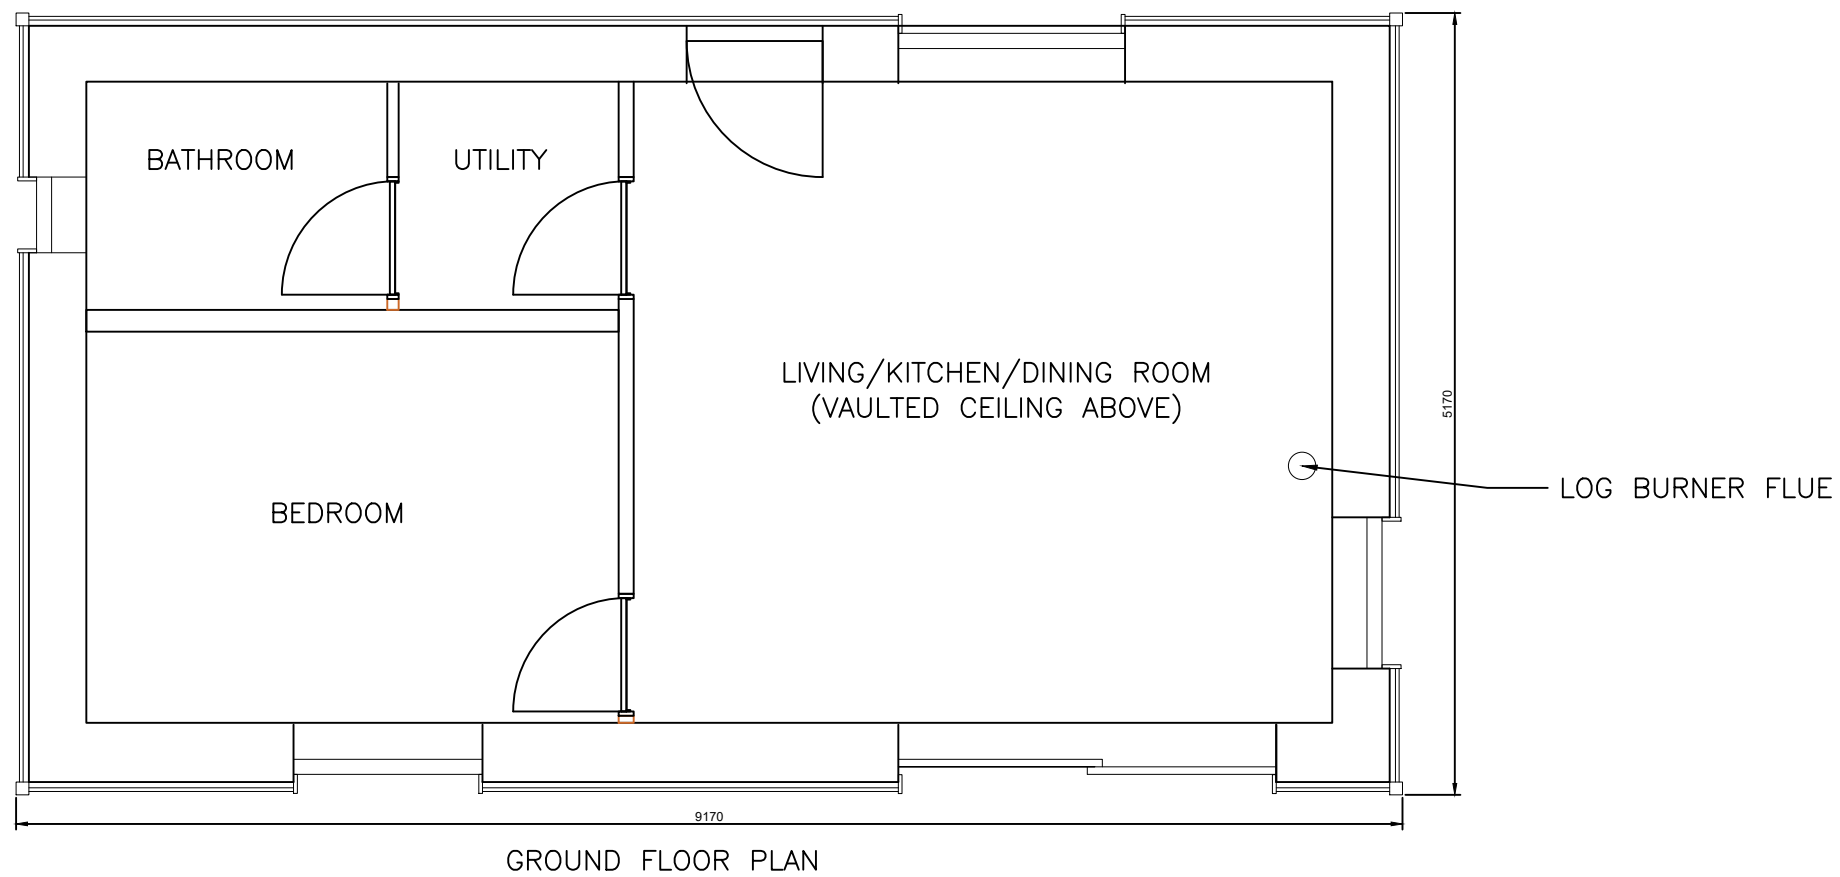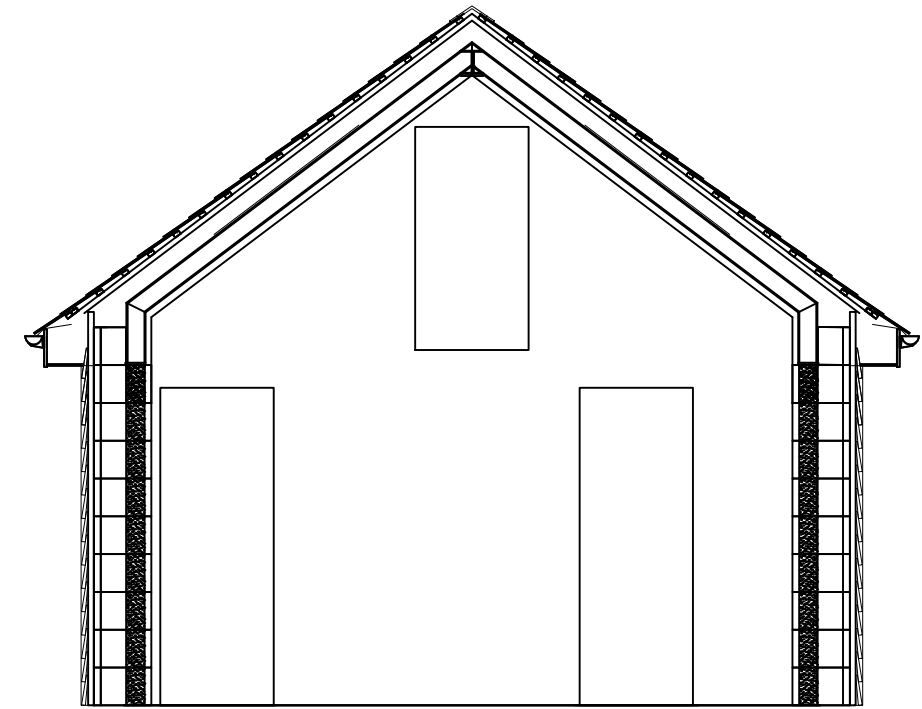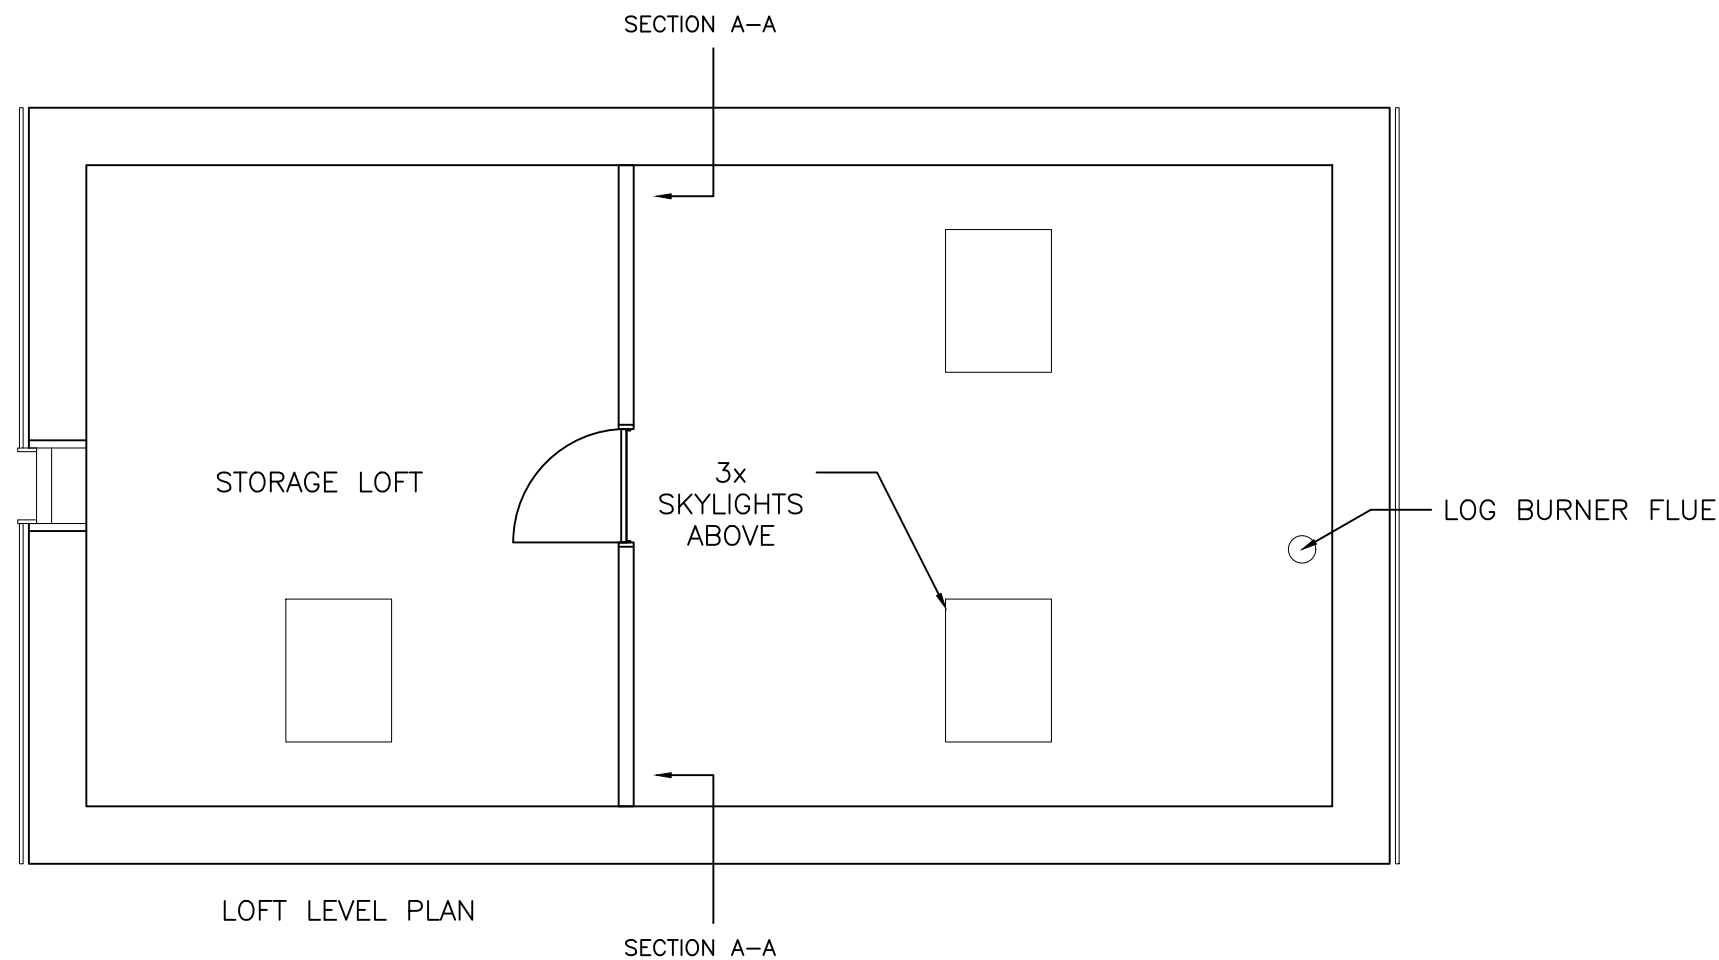

| REVISION HISTORY                                                                                                                                                    |                   |          |           |
|---------------------------------------------------------------------------------------------------------------------------------------------------------------------|-------------------|----------|-----------|
| REV:                                                                                                                                                                | DESCRIPTION:      | DATE:    |           |
| 01                                                                                                                                                                  | As built drawings | 04/05/26 |           |
| <div>William LawsOS Grid Ref:<br/>The GroveST 41183 90696<br/>Bowden's Lane<br/>PenhowLatitude: 51° 36' 43" N<br/>CaldicotLongitude: 2° 51' 2" W<br/>NP26 3AA</div> |                   |          |           |
| PROJECT TITLE:                                                                                                                                                      |                   |          |           |
| THE GROVE, NP26 3AA                                                                                                                                                 |                   |          |           |
| DRAWING TITLE:                                                                                                                                                      |                   |          |           |
| LODGE FLOOR PLANS & ELEVATIONS AS BUILT                                                                                                                             |                   |          |           |
| SCALE AT A3:                                                                                                                                                        | DATE:             | DRAWN:   | SHEET:    |
| 1:50                                                                                                                                                                | 04/05/26          | WL       | 1/1       |
| DRAWING NO:                                                                                                                                                         |                   |          | REVISION: |
| GRO_004                                                                                                                                                             |                   |          | 01        |