



MATERIALS
ROOF – BOX PROFILE SHEET, ANTHRACITE
SOUTH DOOR – ANTHRACITE
EAST DOORS – SECTIONAL, ANTHRACITE
WALLS (ALL) – NATURAL STONE FACED



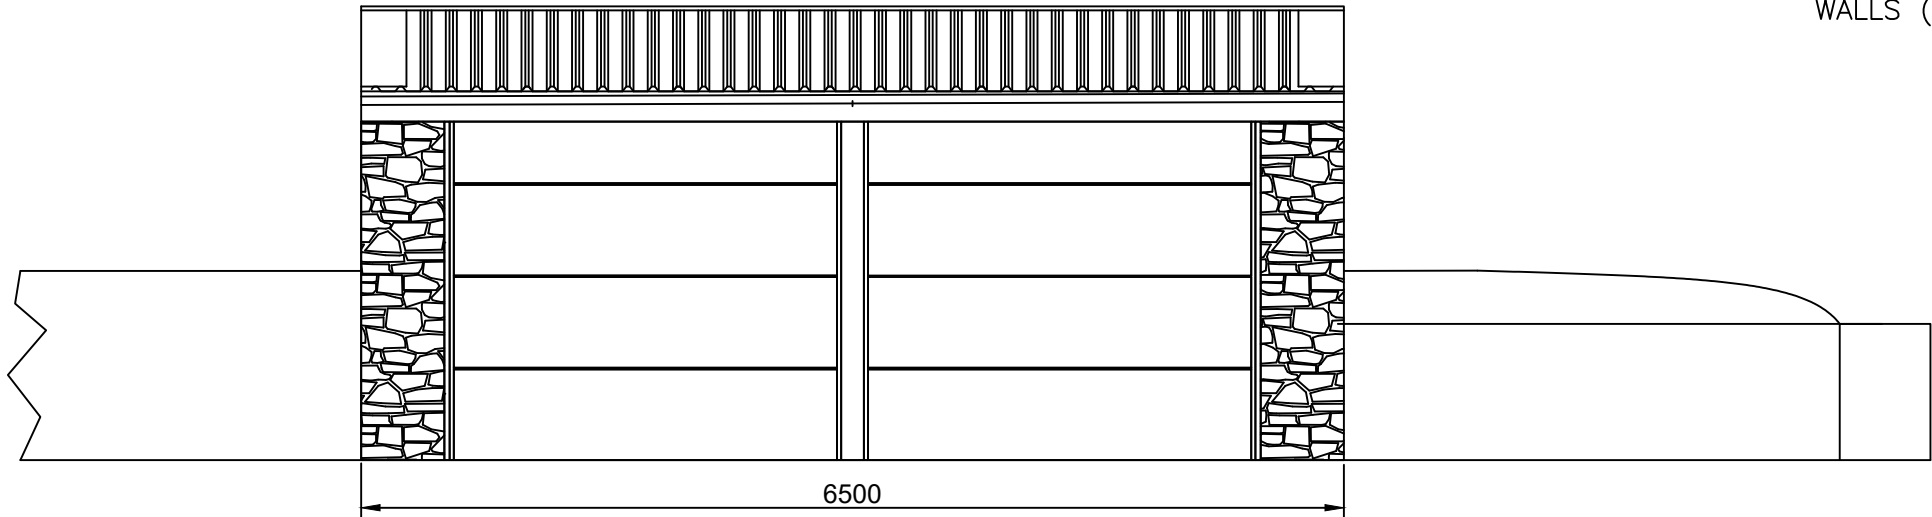


EAST ELEVATION

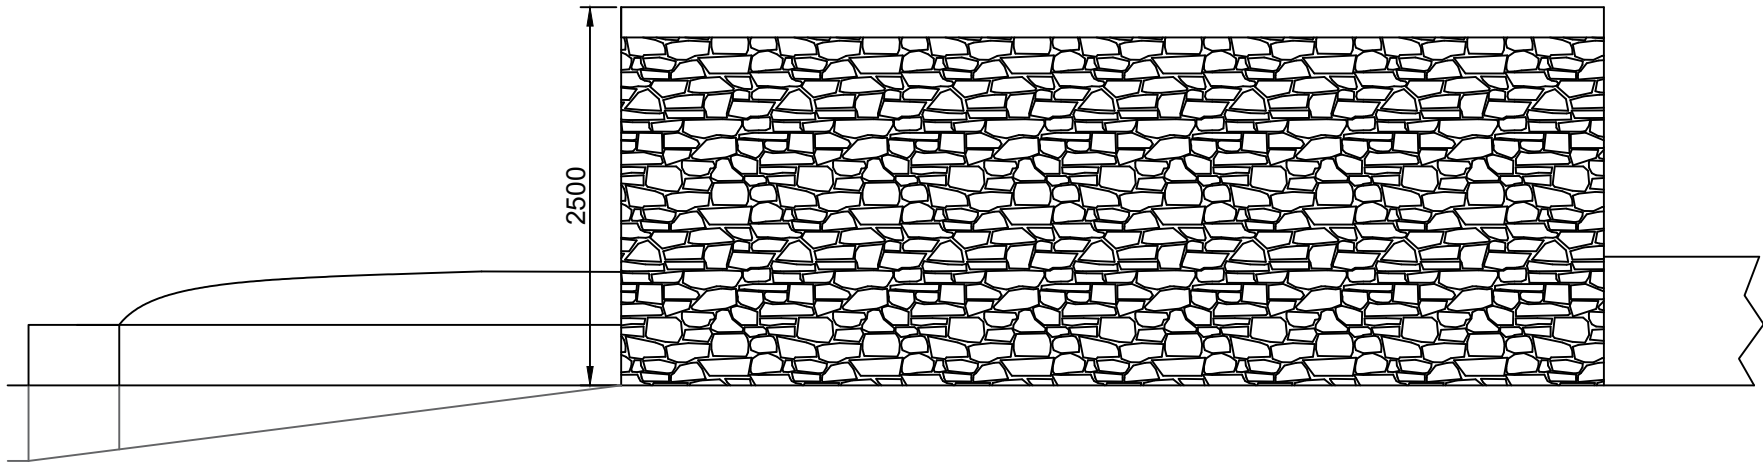

WEST ELEVATION

REVISION HISTORY			
REV:	DESCRIPTION:		DATE:
01	As built		May 26
William Laws OS Grid Ref: The Grove ST 41183 90696 Bowden's Lane Penhow Latitude: 51° 36' 43" N Caldicot Longitude: 2° 51' 2" W NP26 3AA			
PROJECT TITLE: THE GROVE, NP26 3AA			
DRAWING TITLE: GARAGE – AS BUILT			
SCALE AT A3: 1:50	DATE: 03/05/26	DRAWN: WL	SHEET: 1/2
DRAWING NO: GRO_010			REVISION: 01

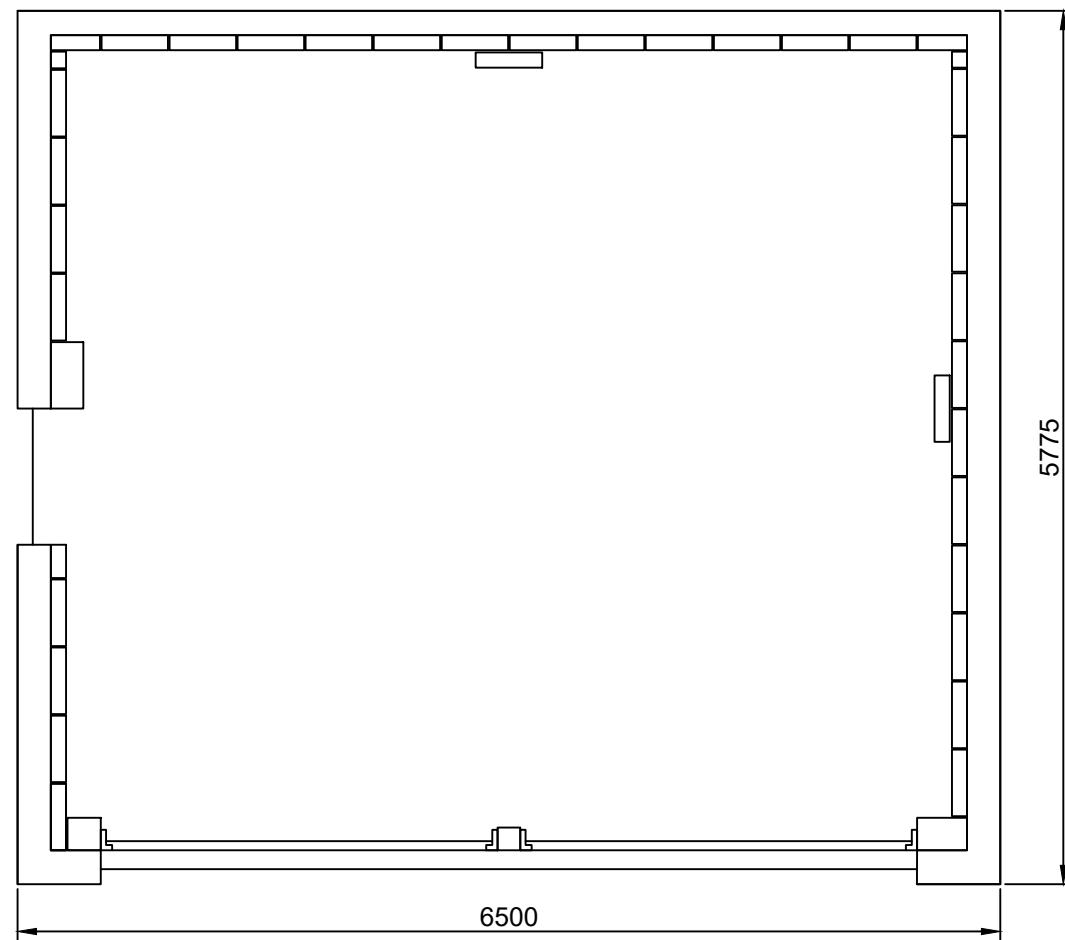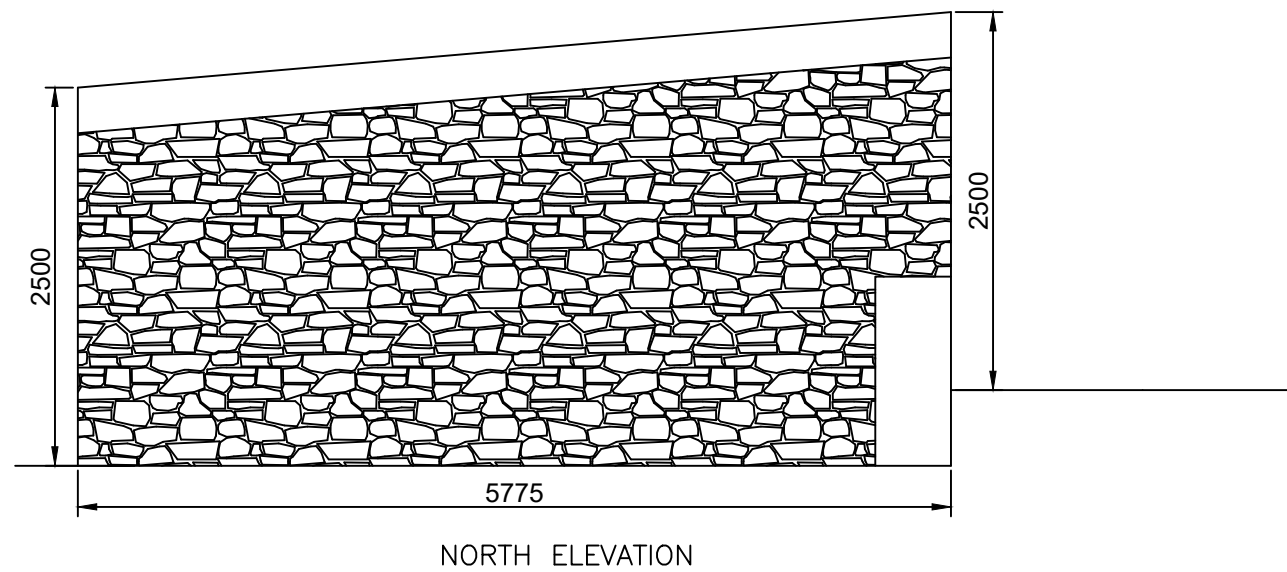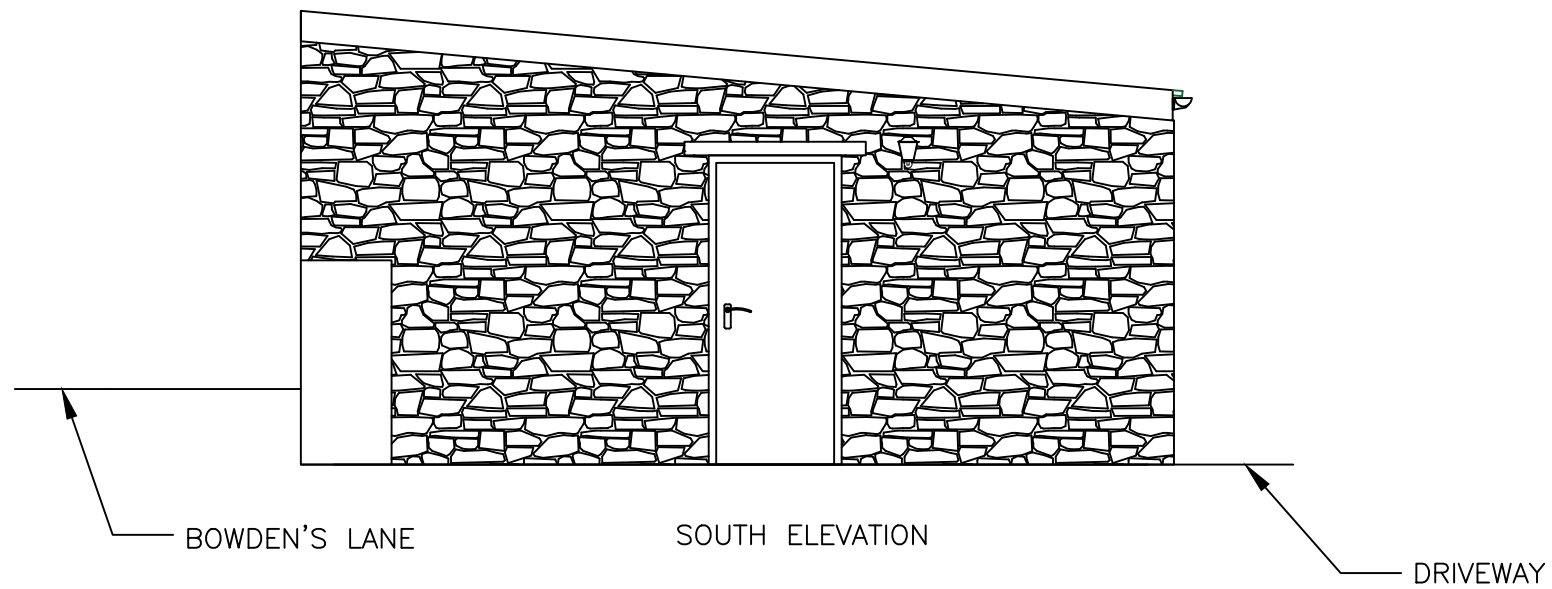

REVISION HISTORY			
REV:	DESCRIPTION:		DATE:
01	As built		May 26
William Laws The Grove Bowden's Lane Penhow Caldicot NP26 3AA		OS Grid Ref: ST 41183 90696 Latitude: 51° 36' 43" N Longitude: 2° 51' 2" W	
PROJECT TITLE:			
THE GROVE, NP26 3AA			
DRAWING TITLE:			
GARAGE – AS BUILT			
SCALE AT A3: 1:50		DATE: 03/05/26	DRAWN: WL
DRAWING NO:			SHEET: 2/2
GRO_010			REVISION: 01