



# CAMBRIAN INN, COMMERCIAL ROAD, NEWPORT

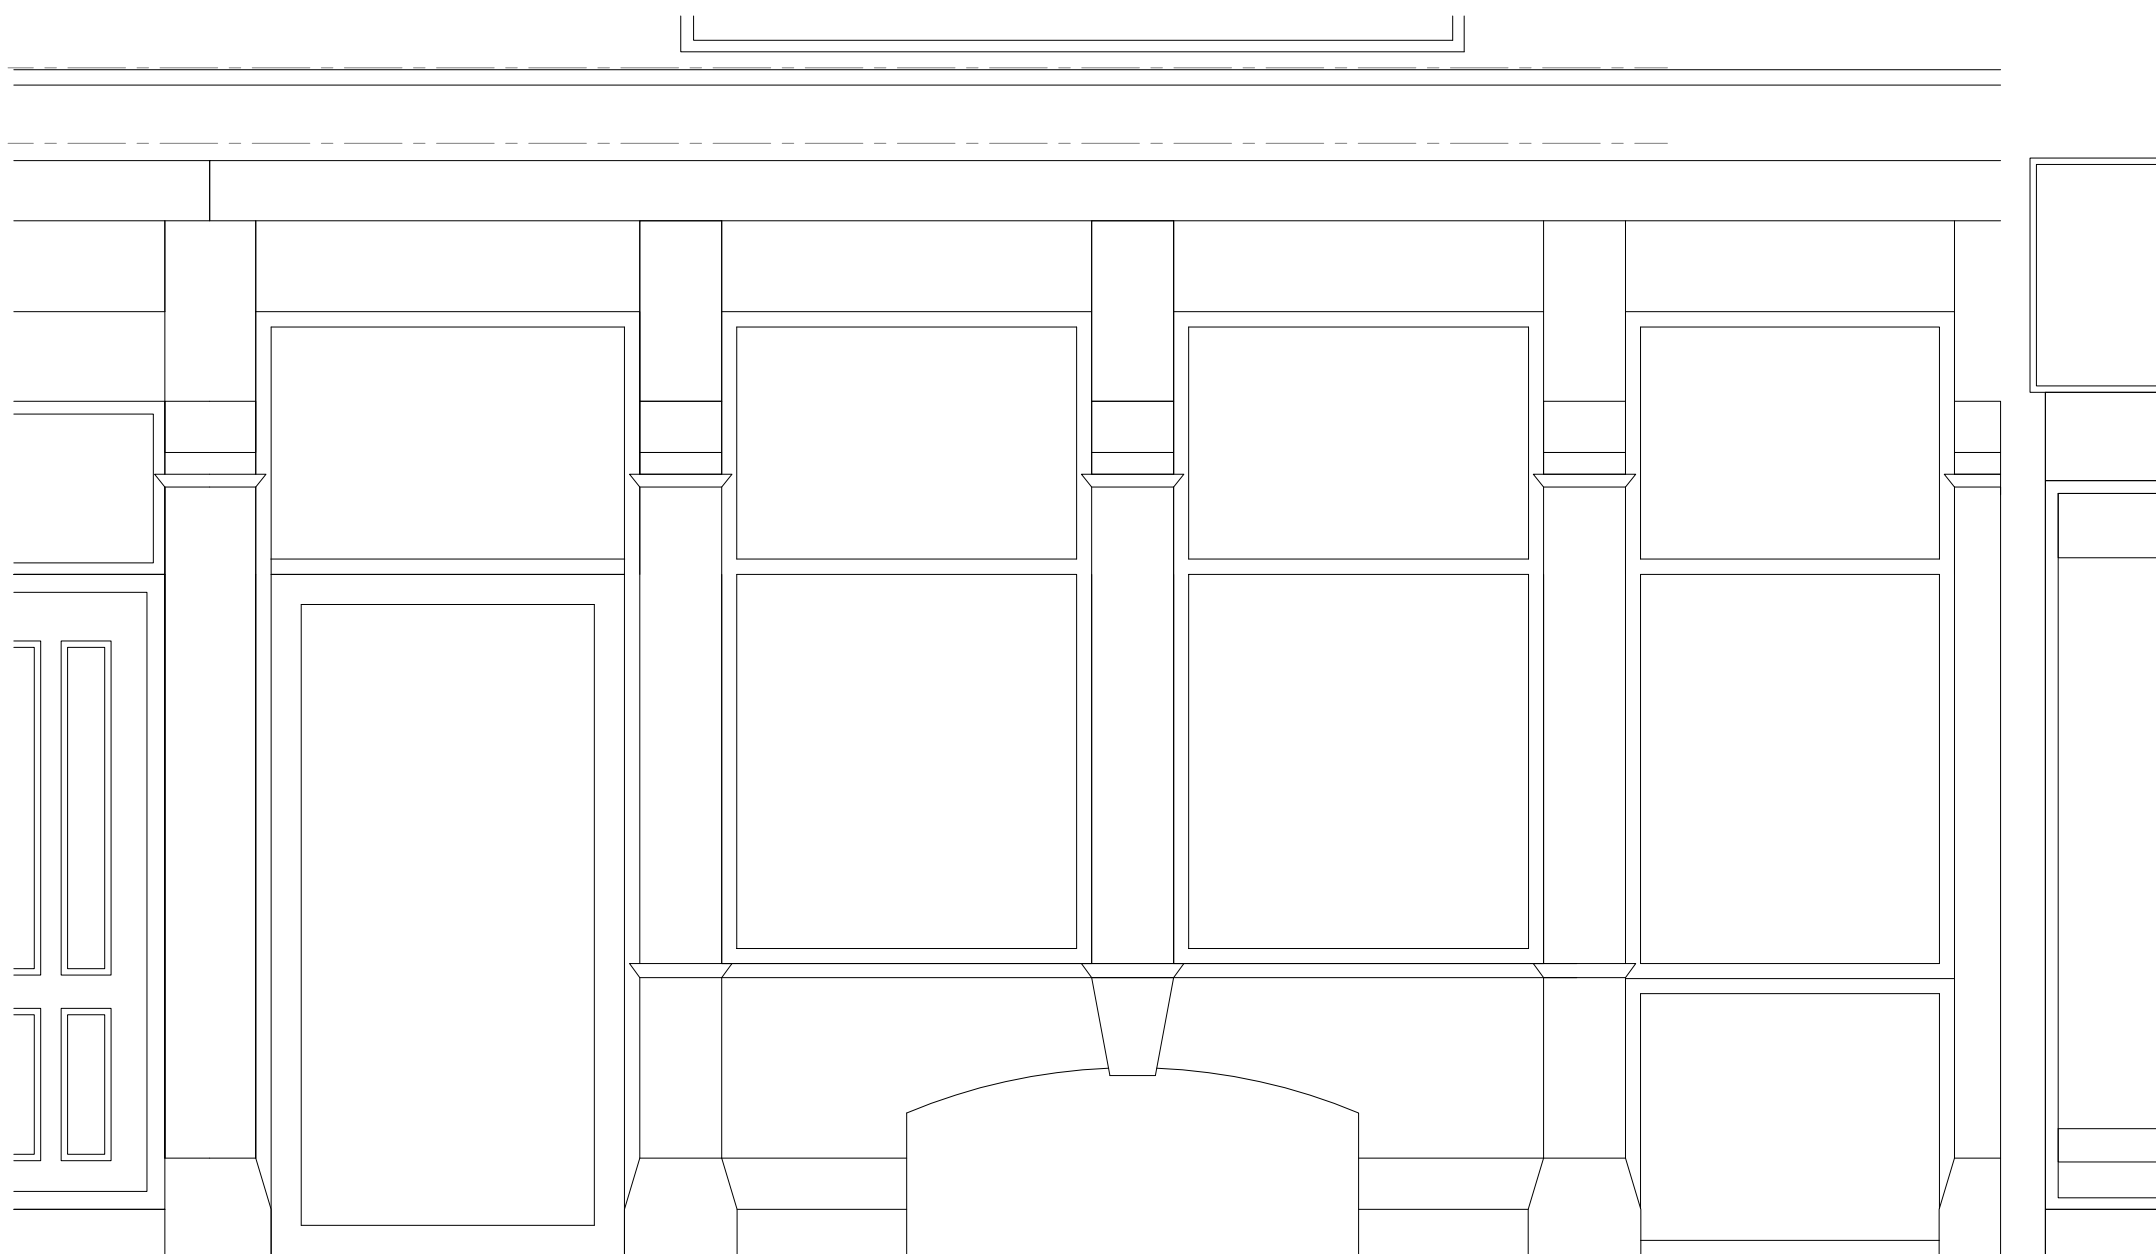


SHOPFRONT ELEVATION  
SCALE 1:25

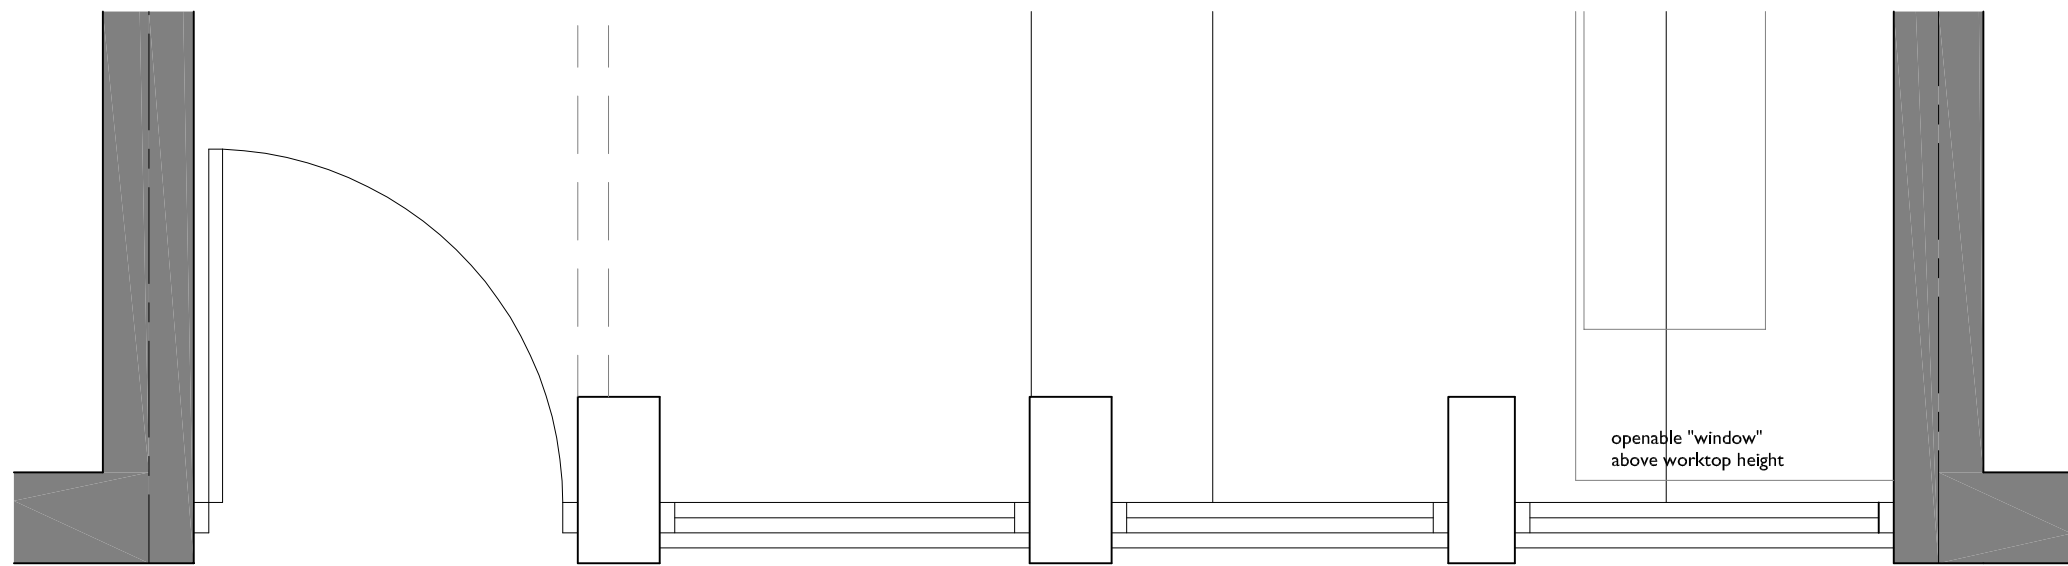


SHOPFRONT PLAN  
SCALE 1:25


## DETAILS

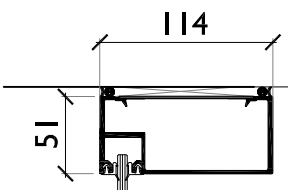


HEAD DETAIL E  
SCALE 1:5

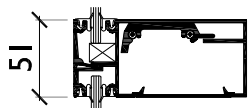


TRANSOM DETAIL D  
SCALE 1:5

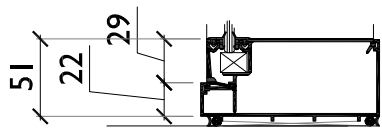

CILL DETAIL C  
SCALE 1:5

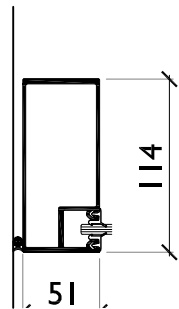

JAMB DETAIL A  
SCALE 1:5

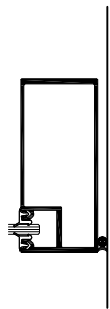

JAMB DETAIL B  
SCALE 1:25

SCALE THIS DRAWING ONLY FOR  
PLANNING PURPOSES CHECK ALL  
DIMENSIONS ON SITE

This drawing is to establish design intent. The contractor is responsible for  
quantities, dimensions, verification of site conditions, compliance with contract  
documents for information that pertains to the fabrication processes or techniques  
of construction and for the co-ordination of work with all trades. All errors or  
omissions are to be reported to the designers.

Original drawing size A1

No drawing is copyright of ajt tech

|     |        |                                  |     |         |
|-----|--------|----------------------------------|-----|---------|
| Rev | Date   | Description                      | By  | Checked |
| A   | 260619 | Shop front amended as installed. | jmt | -       |

|         |                                                                                  |              |                               |
|---------|----------------------------------------------------------------------------------|--------------|-------------------------------|
| Client  | MR F. SACAN                                                                      |              |                               |
| Project | PROPOSED TURKISH RESTAURANT AT FORMER<br>CAMBRIAN INN, COMMERCIAL ROAD, NEWPORT. |              |                               |
| Title   | SHOPFRONT DETAILS<br>AS PROPOSED                                                 | Scale        | 1:51:25 @ A1<br>1:101:50 @ A3 |
| Status  | PLANNING                                                                         | Drawn<br>jmt | Date<br>May 2026              |
| Job No  | 2025.542                                                                         | Drwg No      | PL12                          |
| Rev.    | A                                                                                | Revised      | ---                           |