



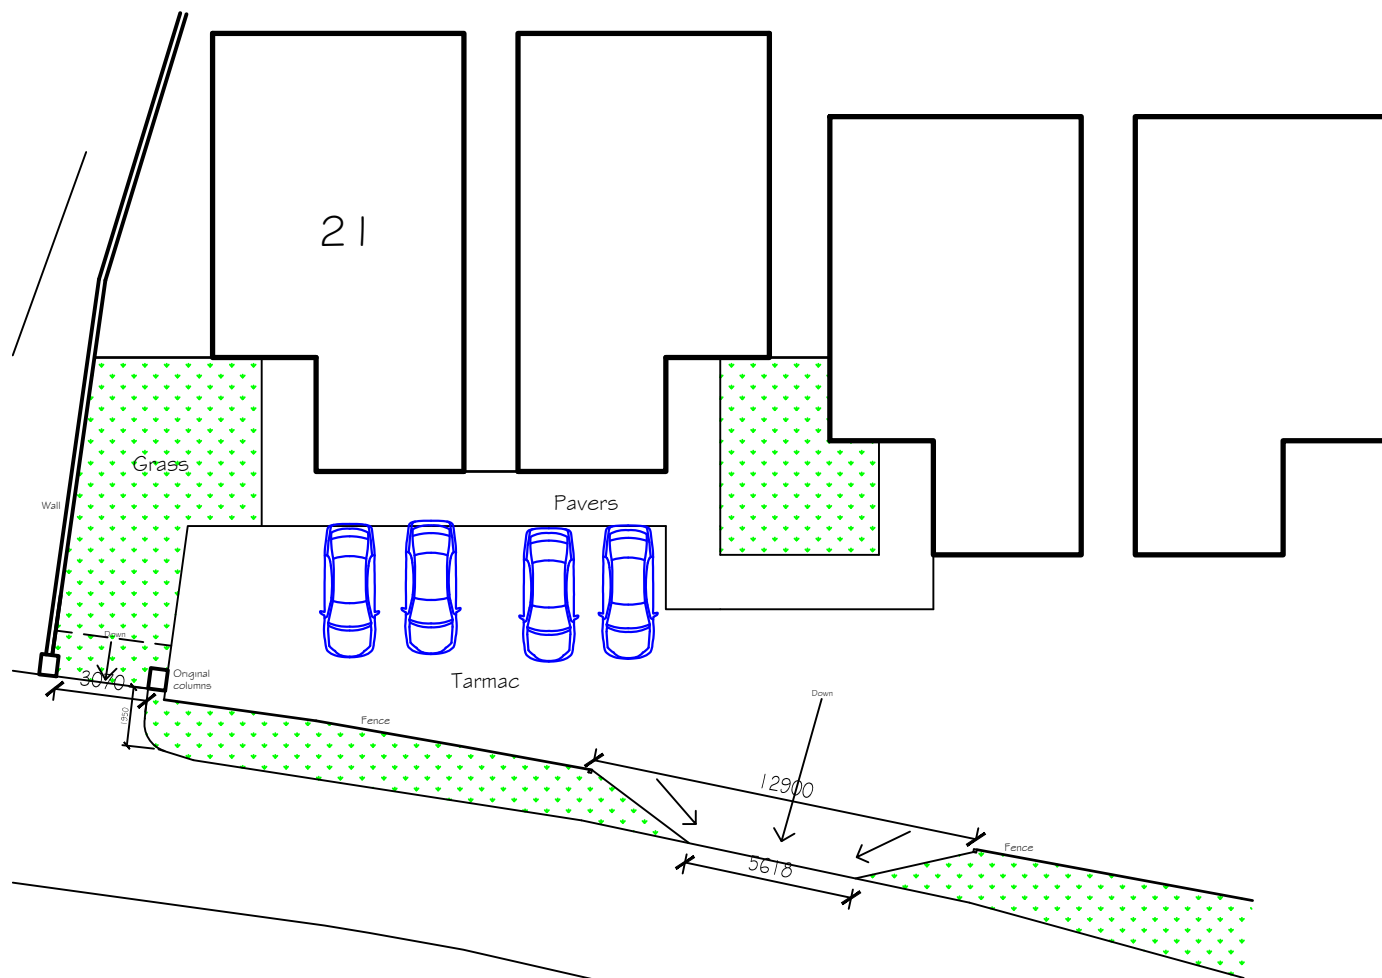

Original Plans

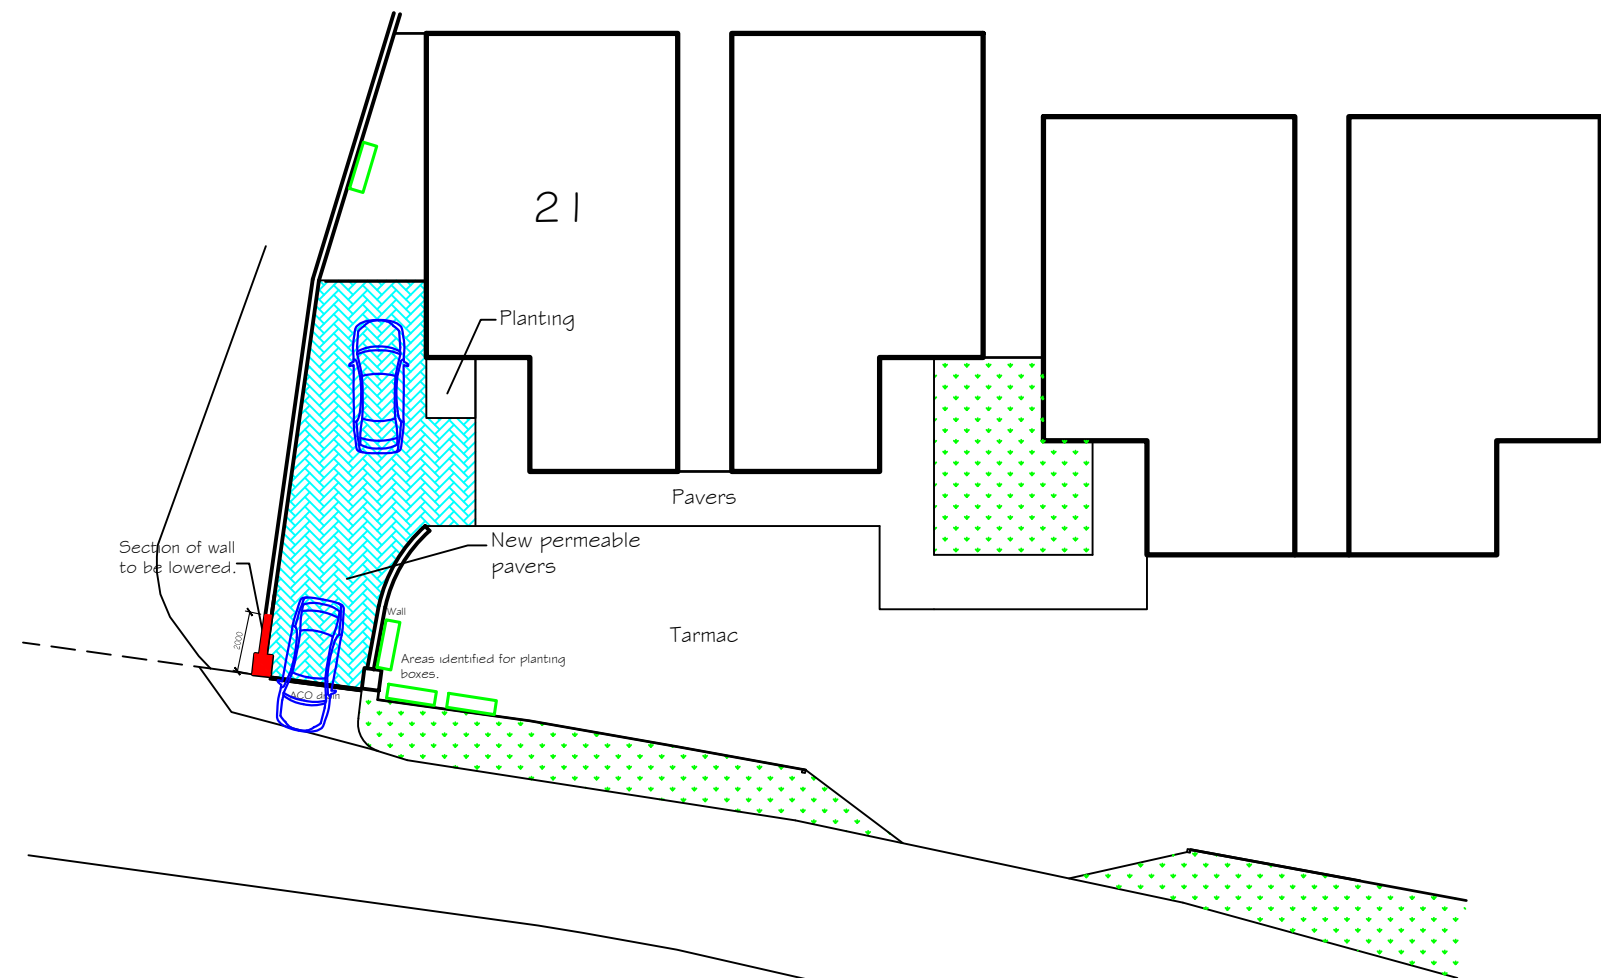

Proposed Plans
(as built except where noted)

		© This drawing is copyright.	
		21 St Mellons Road Marshfields	
EXISTING & PROPOSED PLANS			
Scale: 1.250@A3		Drwg No. 21SMR/26/01A	
Date: March 2026			
Revisions: 1. Shows section of wall to be lowered.			
Drawings not to be scaled, use figured dimensions and levels only. Any inaccuracies should be notified to the architect.			