



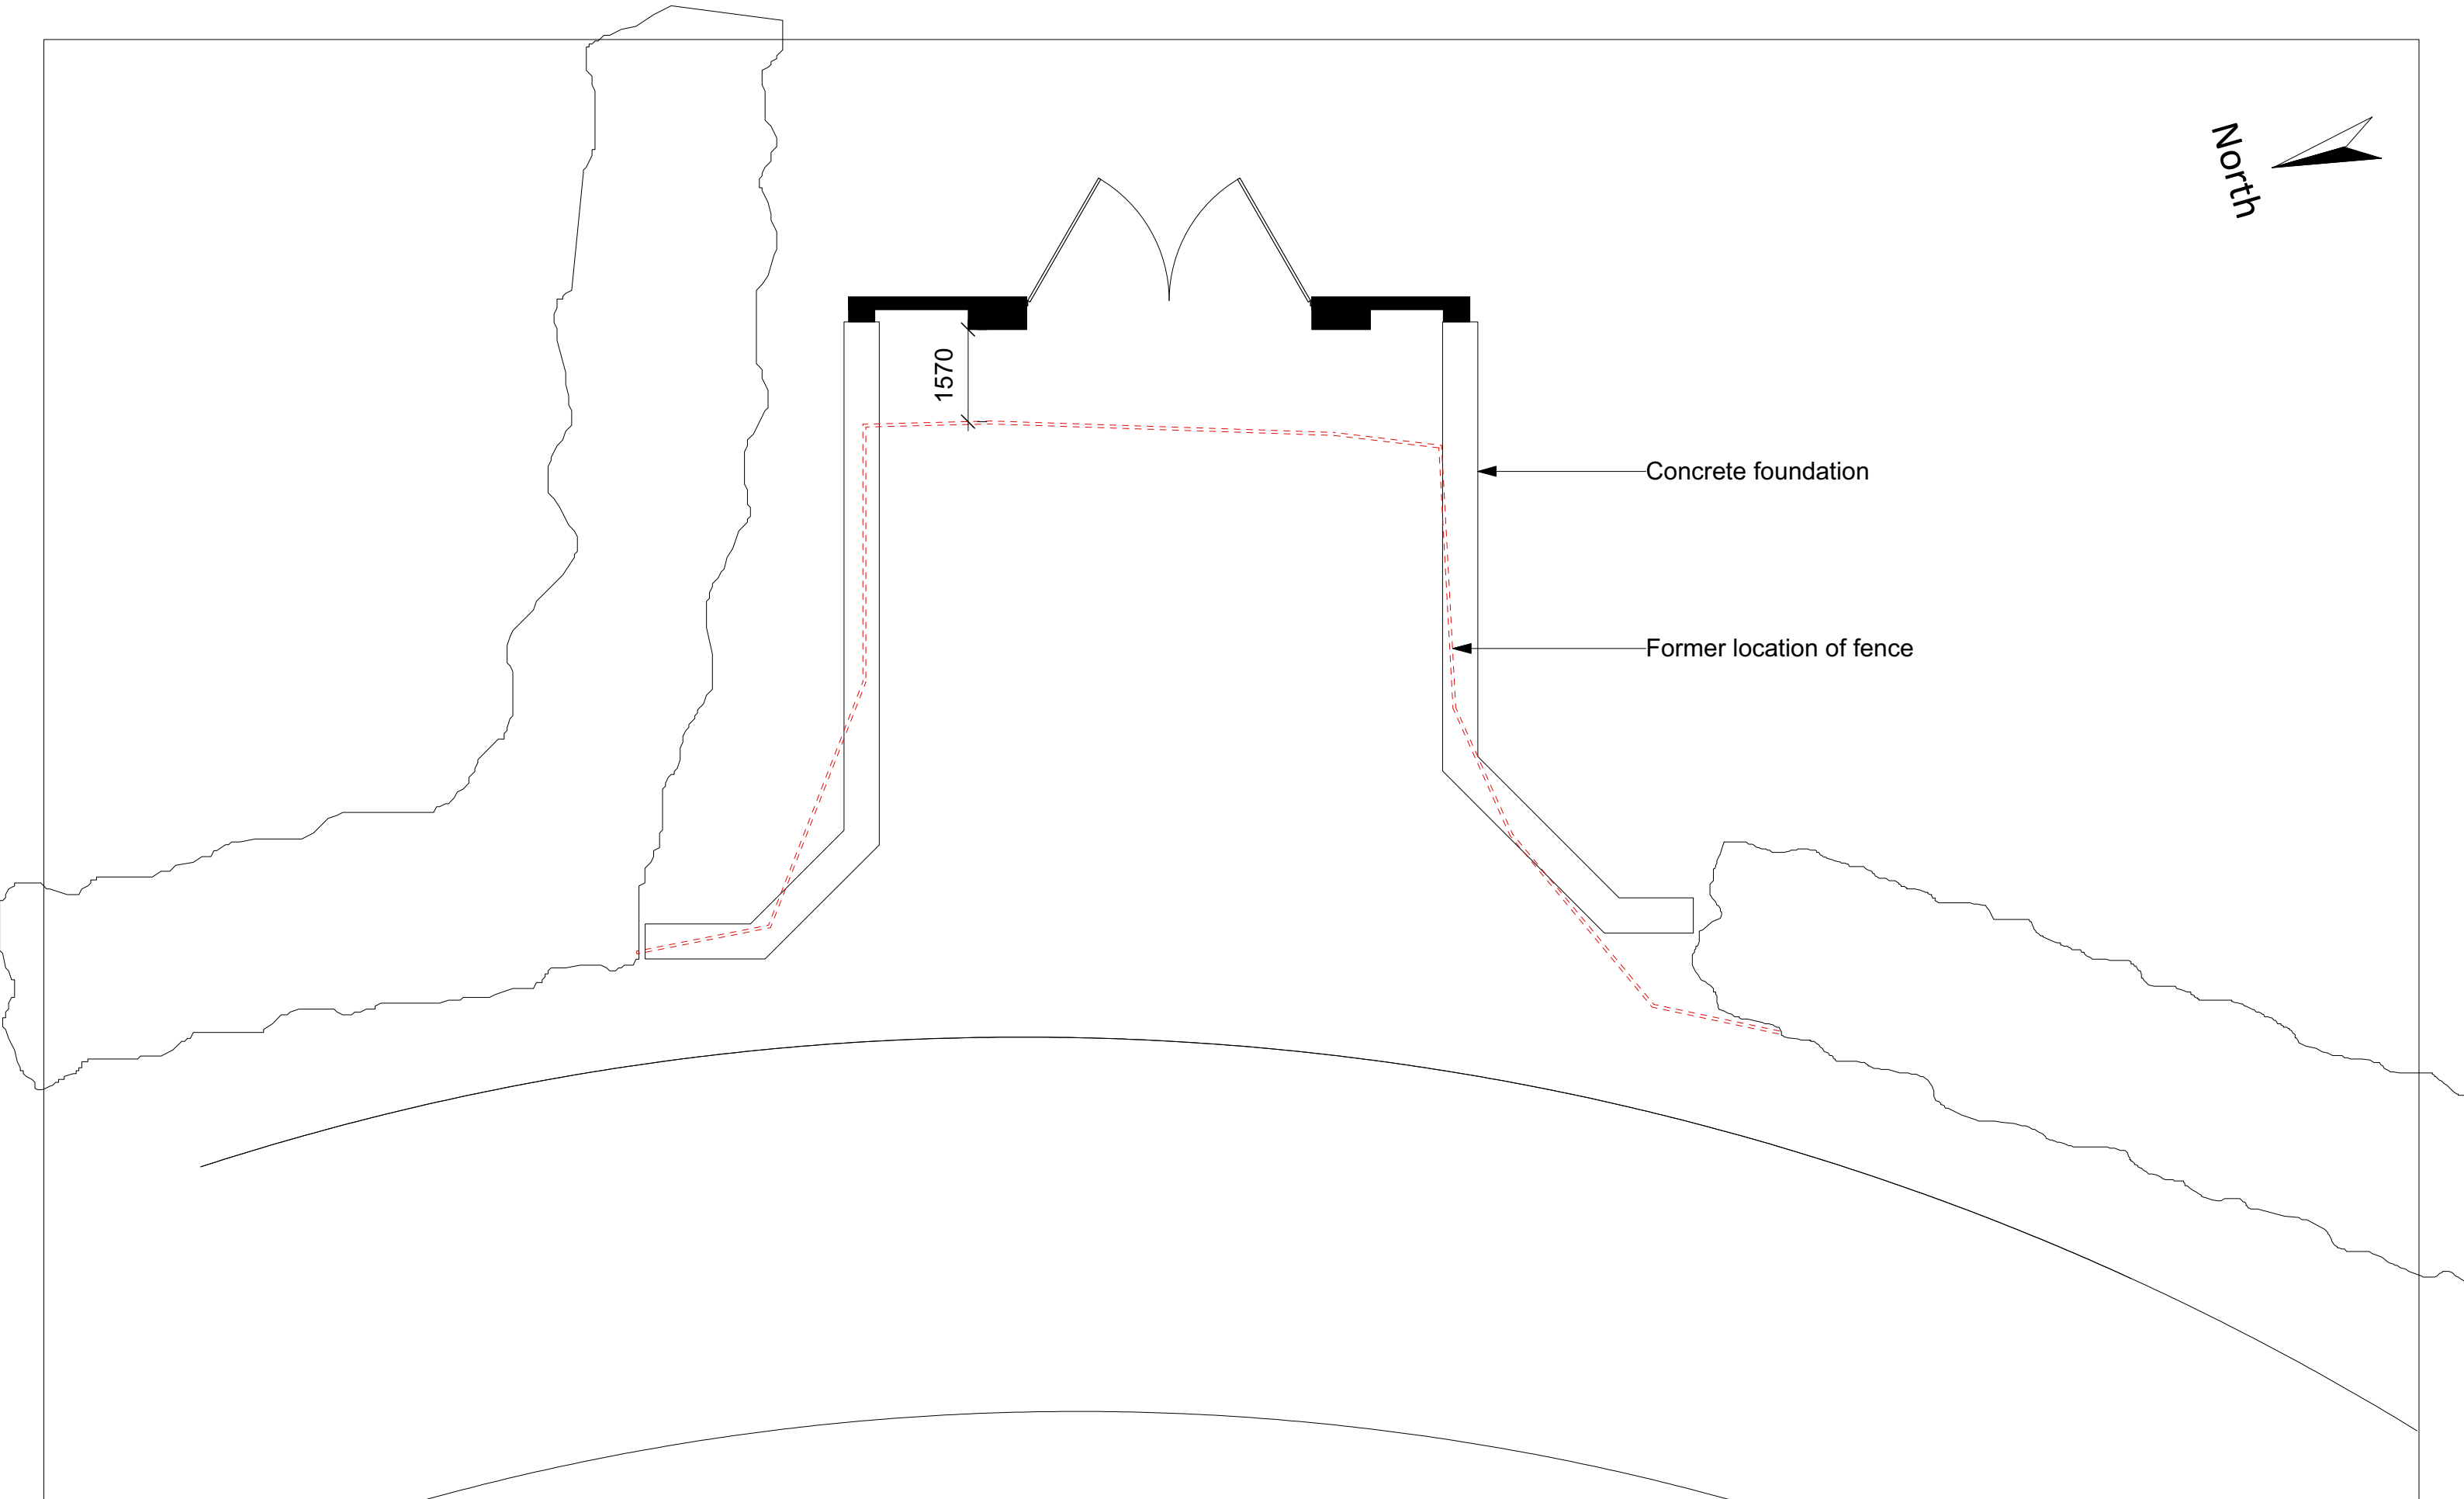

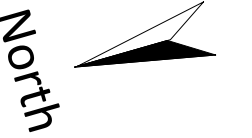

Skerryvore Designs Ltd

skerryvoredesigns.co.uk

Phone **01633 897922**

Mobile **07816 934352**

contact@skerryvoredesigns.co.uk

JOB

TITLE

Oakfields,
St. Brides,
Lighthouse Road,
Newport
NP10 8SF

DRAWING

TITLE

As built site entrance

DRAWING No.

SD1065-03B

SCALE

1:100 @ A3

DATE

April 2025