


GENERAL NOTES

- DO NOT SCALE THIS DRAWING. ONLY USE FIGURED DIMENSIONS IF IN DOUBT ASK.
- UNLESS NOTED OTHERWISE ALL DIMENSIONS ARE IN MILLIMETRES & AND ALL LEVELS ARE IN METRES RELATIVE TO ORDNANCE DATUM.
- ALL LONGITUDINAL AND TRANSVERSE DIMENSIONS ARE MEASURED IN PLAN UNLESS OTHERWISE NOTED.
- THIS DRAWING IS TO BE READ IN CONJUNCTION WITH ALL SCHEME DRAWINGS AND DESIGNERS RISK ASSESSMENT.
- THE CONTRACTOR IS TO CHECK ALL DIMENSIONS PRIOR TO CONSTRUCTION AND ANY DISCREPANCIES MUST BE REPORTED TO SPRING DESIGN BEFORE PROCEEDING.
- ALL STATUTORY SERVICES INFORMATION SHOWN HAS BEEN PROVIDED BY THE RELEVANT STATUTORY AUTHORITIES. THE CONTRACTOR IS TO SATISFY HIMSELF AS TO THE ACCURACY OF THE LOCATIONS, SIZE AND MATERIAL AND OWNERSHIP OF THE SERVICES PRIOR TO ANY WORKS BEING CARRIED OUT.

- = DENOTES BUFF BRICK
 - = DENOTES PURAFASCAD OKO (OR EQUAL APPROVED) BROWN/TERRACOTA COLOURED FEATURED NON-COMBUSTIBLE CLADDING.
 - = DENOTES DARK GREY METAL INFILL PANEL
 - = DENOTES BRONZE COLOURED PRESSED METAL PANELS
- HOPPERS AND RAIN WATER DRAIN PIPES TO BE PPC ALUMINIUM DARK GREY RAL COLOUR 7015
- UPVC WINDOWS TO BE DARK GREY, RAL COLOUR 7015
- DOORS TO BE DARK GREY, RAL COLOUR 7015
- ALUMINIUM CURTAIN WALL WINDOWS AND DOORS TO BE DARK GREY, RAL COLOUR 7015
- ME = MECHANICAL EXTRACT TO MATCH COLOUR OF FASCAD


Elevation A (Front)

SCALE 1:100 @ A1

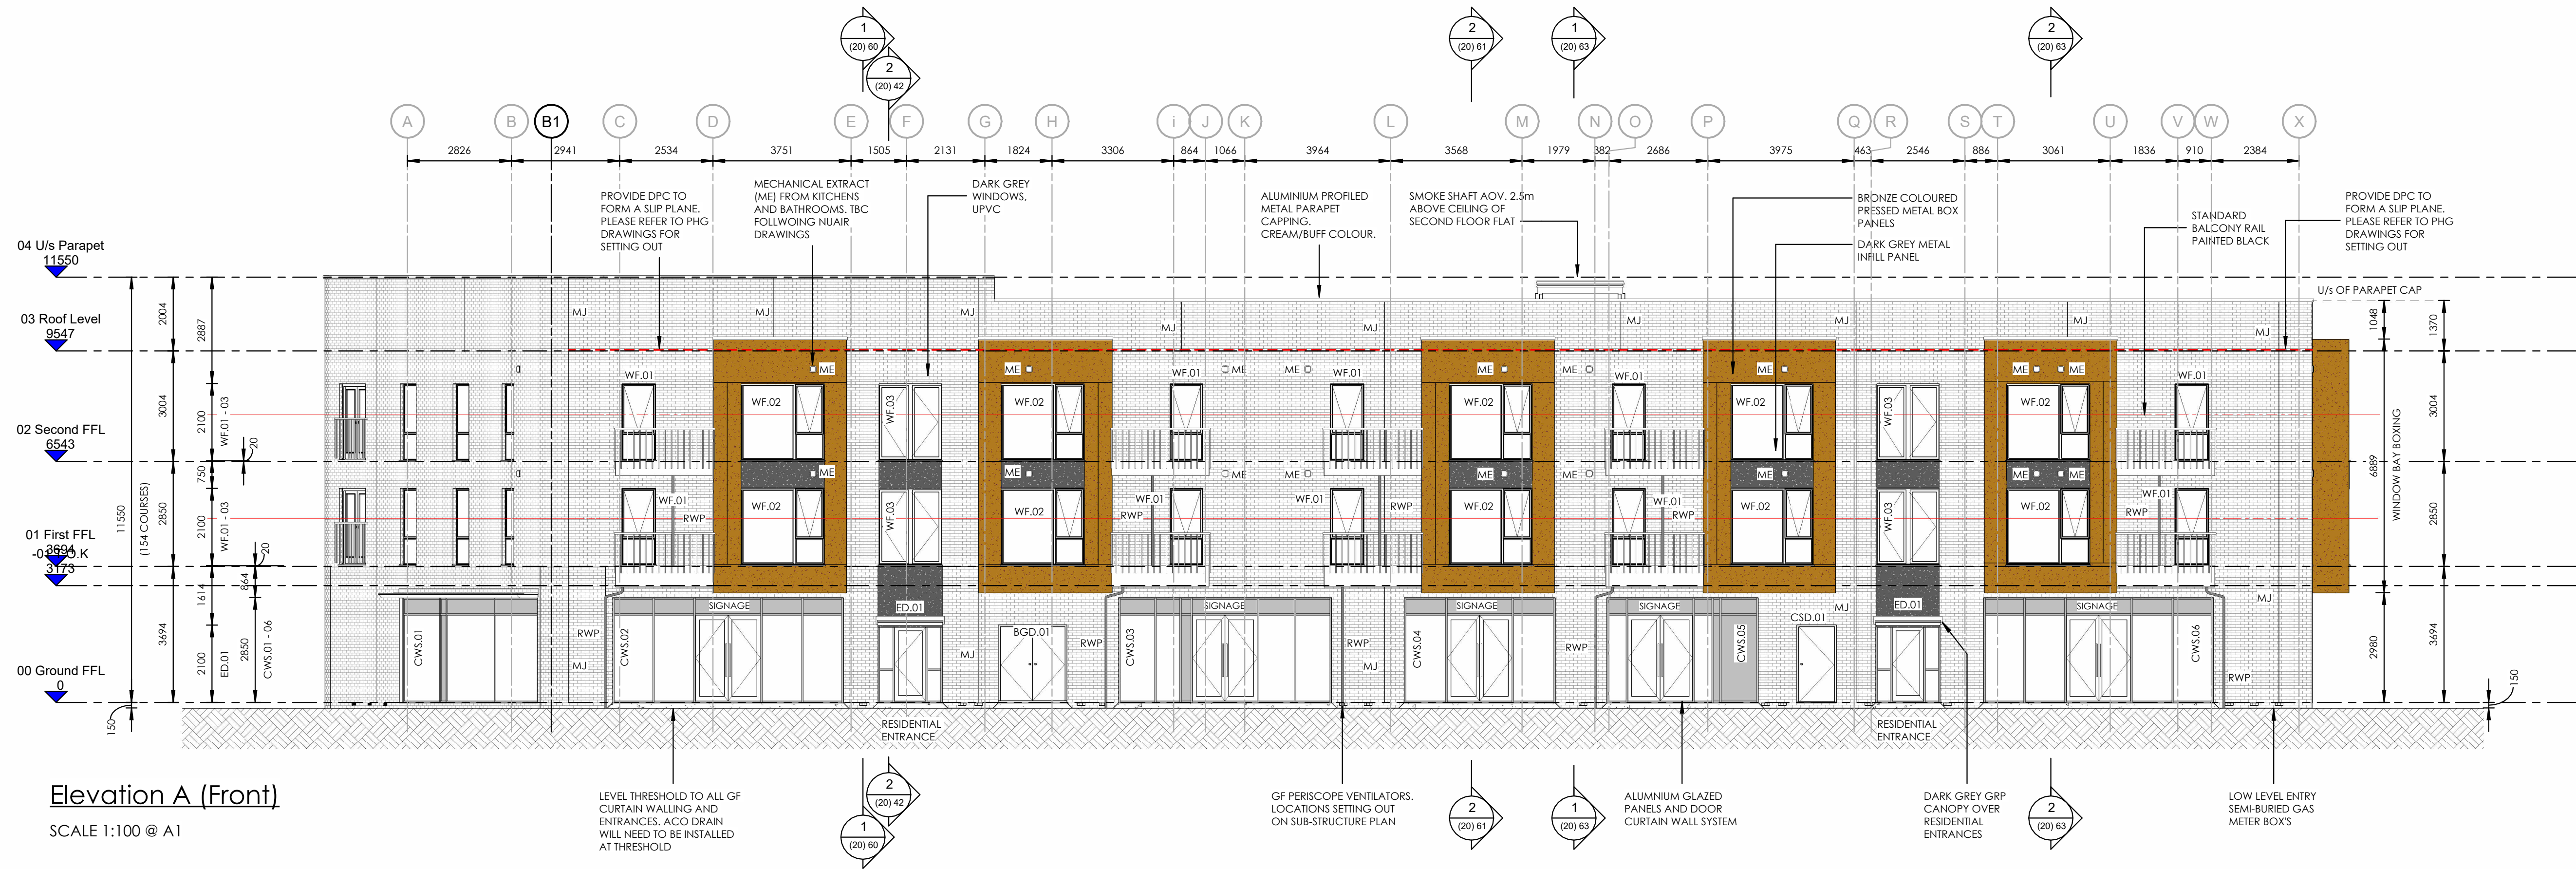

Elevation B (R.H Side)

SCALE 1:100 @ A1

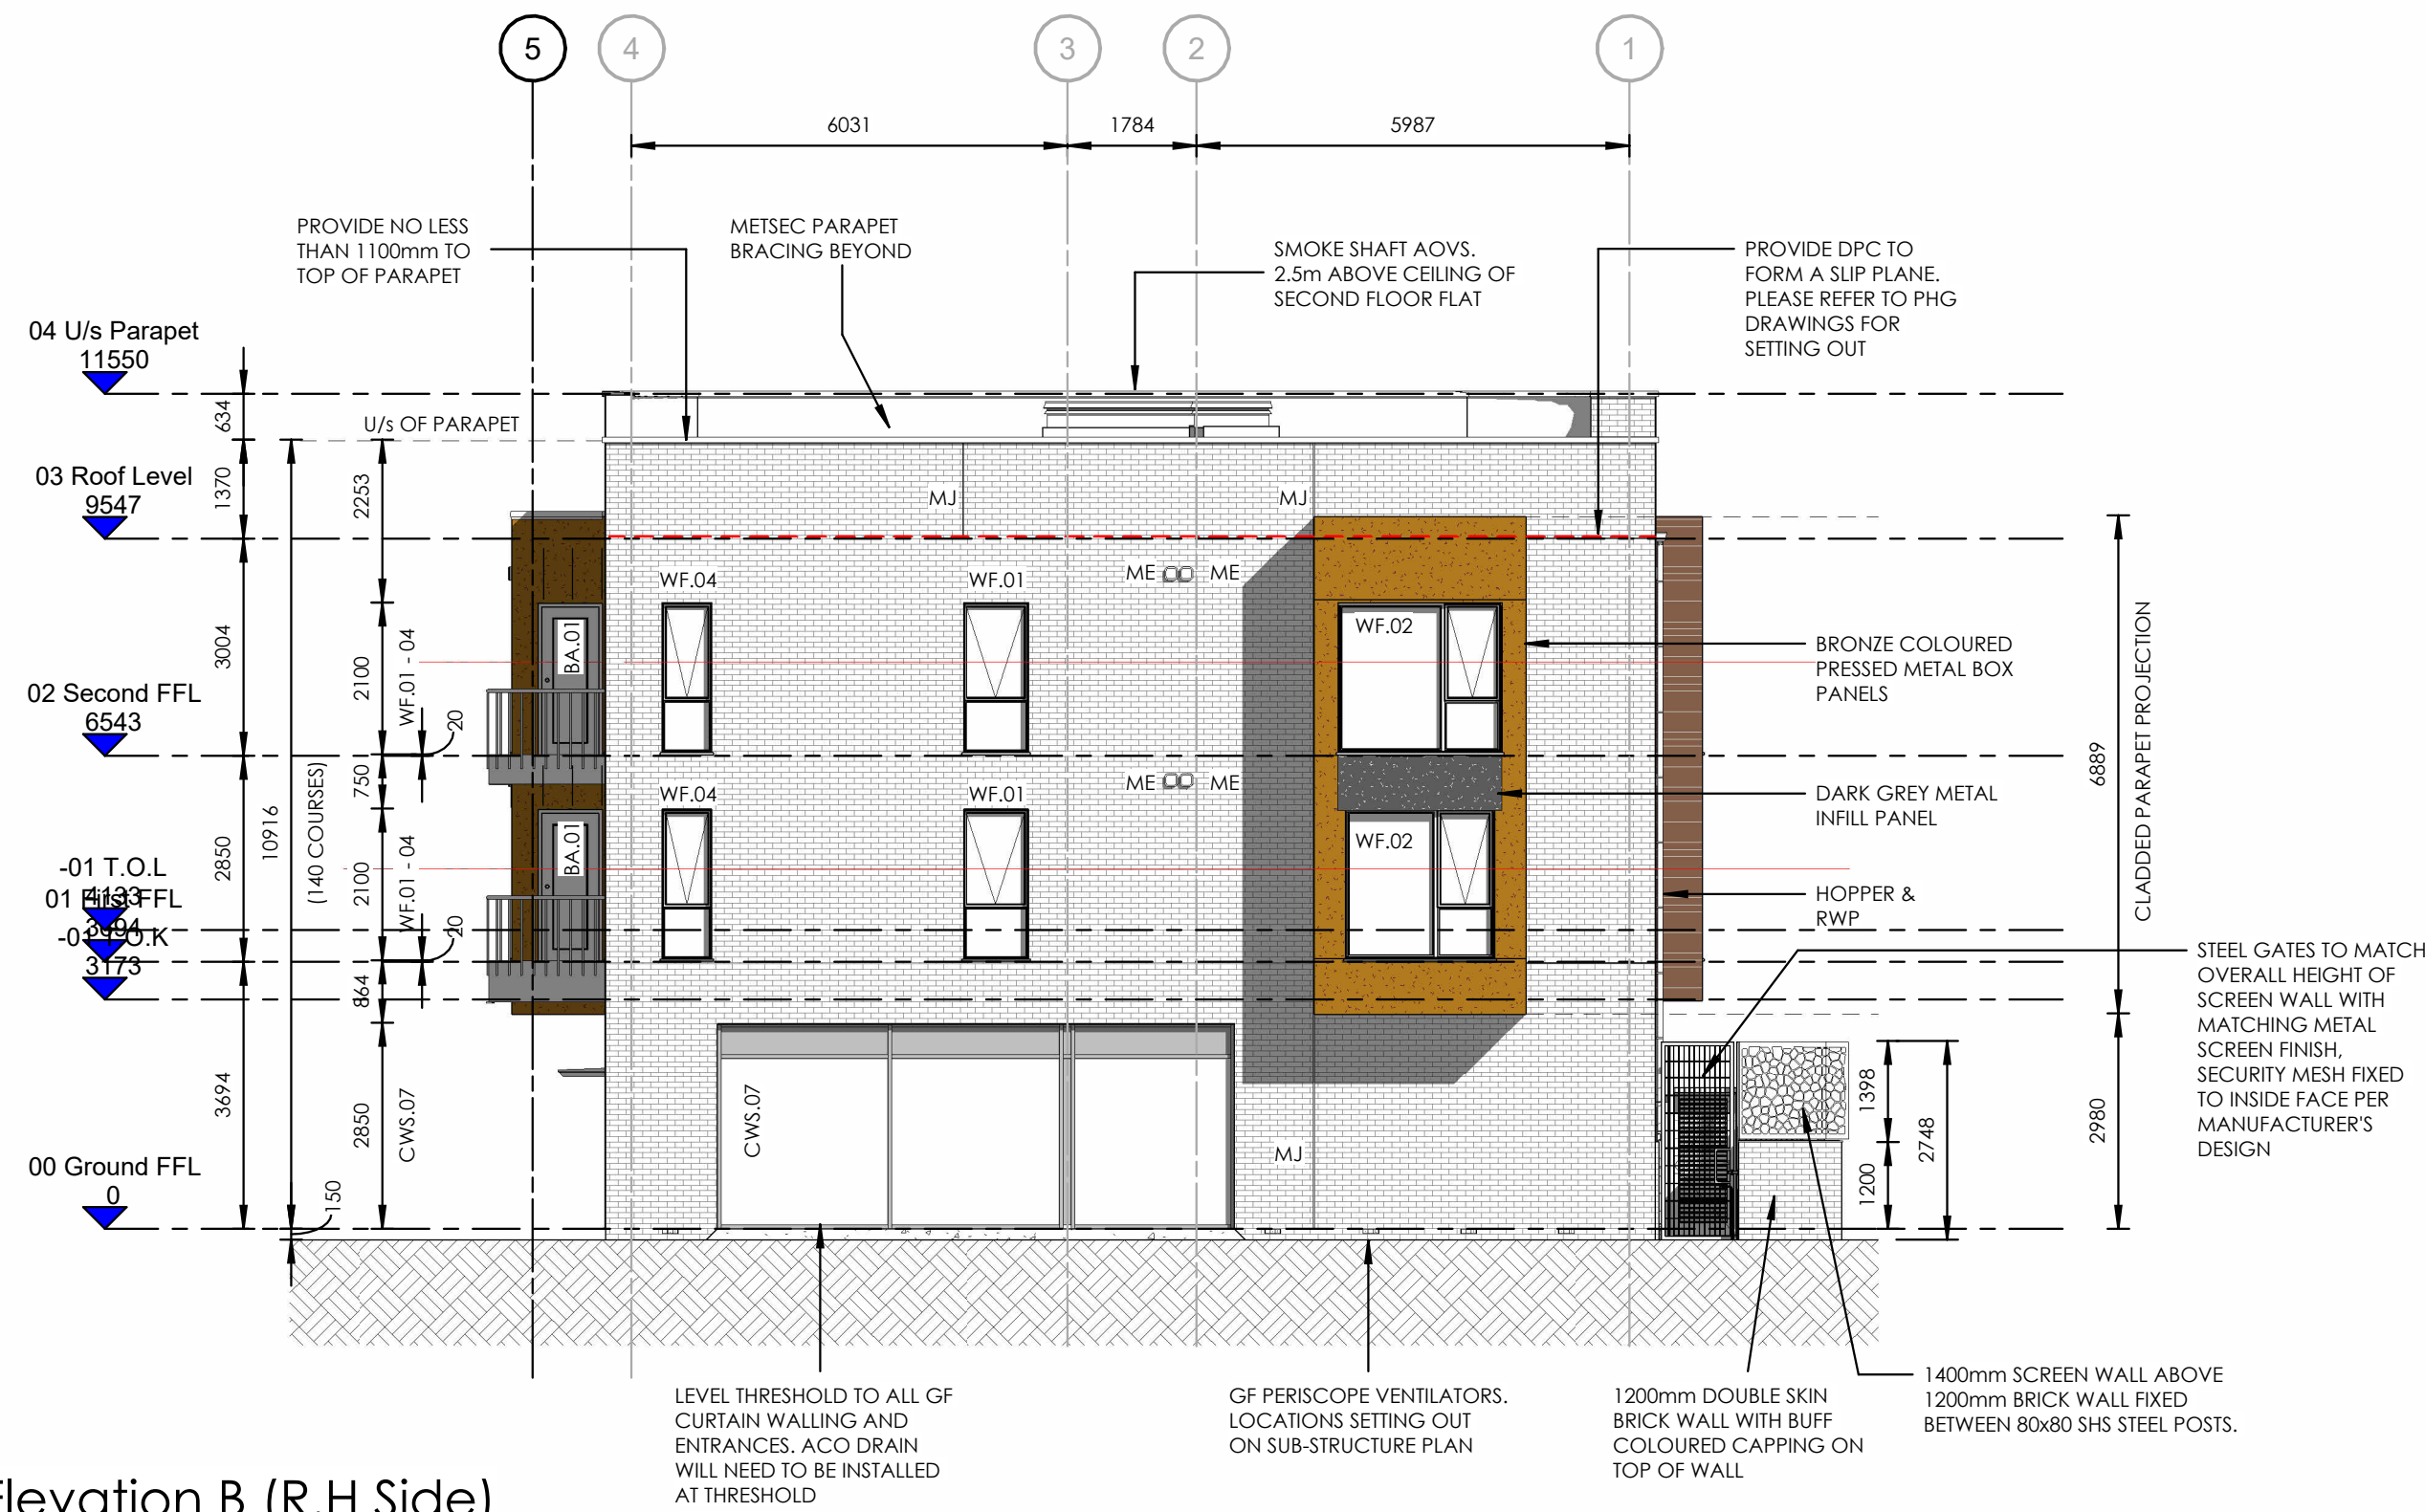

A1

Original sheet size

Note: This Drawing is copyright. Its use or reproduction is subject to permission from Spring Design Consultancy Limited. All rights are reserved until invoices are paid in full. Contact SDC regarding terms & conditions. Check printed scale. Responsibility is not accepted for reproduction of digital media or measuring from this document. Only figured dimensions to be used for construction. No responsibility will be taken for any design used for construction prior to receipt of relevant approvals. Report doubts/discrepancies to project Architect.

Rev	Date	Description	By
1	29.04.22	Decommissioned perforated screen panels amended	MLM
2	29.04.22	As Built Issue	MLM

Client
Lovell Group

Project
Ringland Regeneration

Drawing Title
RB 01 - Elevations A & B (Front & R.H Side)

Drawing Status
AS BUILT ISSUE

Date
29.04.22

Drawn By
MLM

Checked By
MLM

Director
CW

Scale
As indicated@A1

Sheet No.
2603

Opt.
01

Drawing No.
(20) 50

Rev.
N

Unit 2 Chapel Barns | Merthyr Mawr | Bridgend | CF32 0L5
spring-design.co.uk | T: 01656 436267

spring design