



RB 02 Elevation C1 - Rear
Elevation on Main Building

SCALE 1:100 @ A1

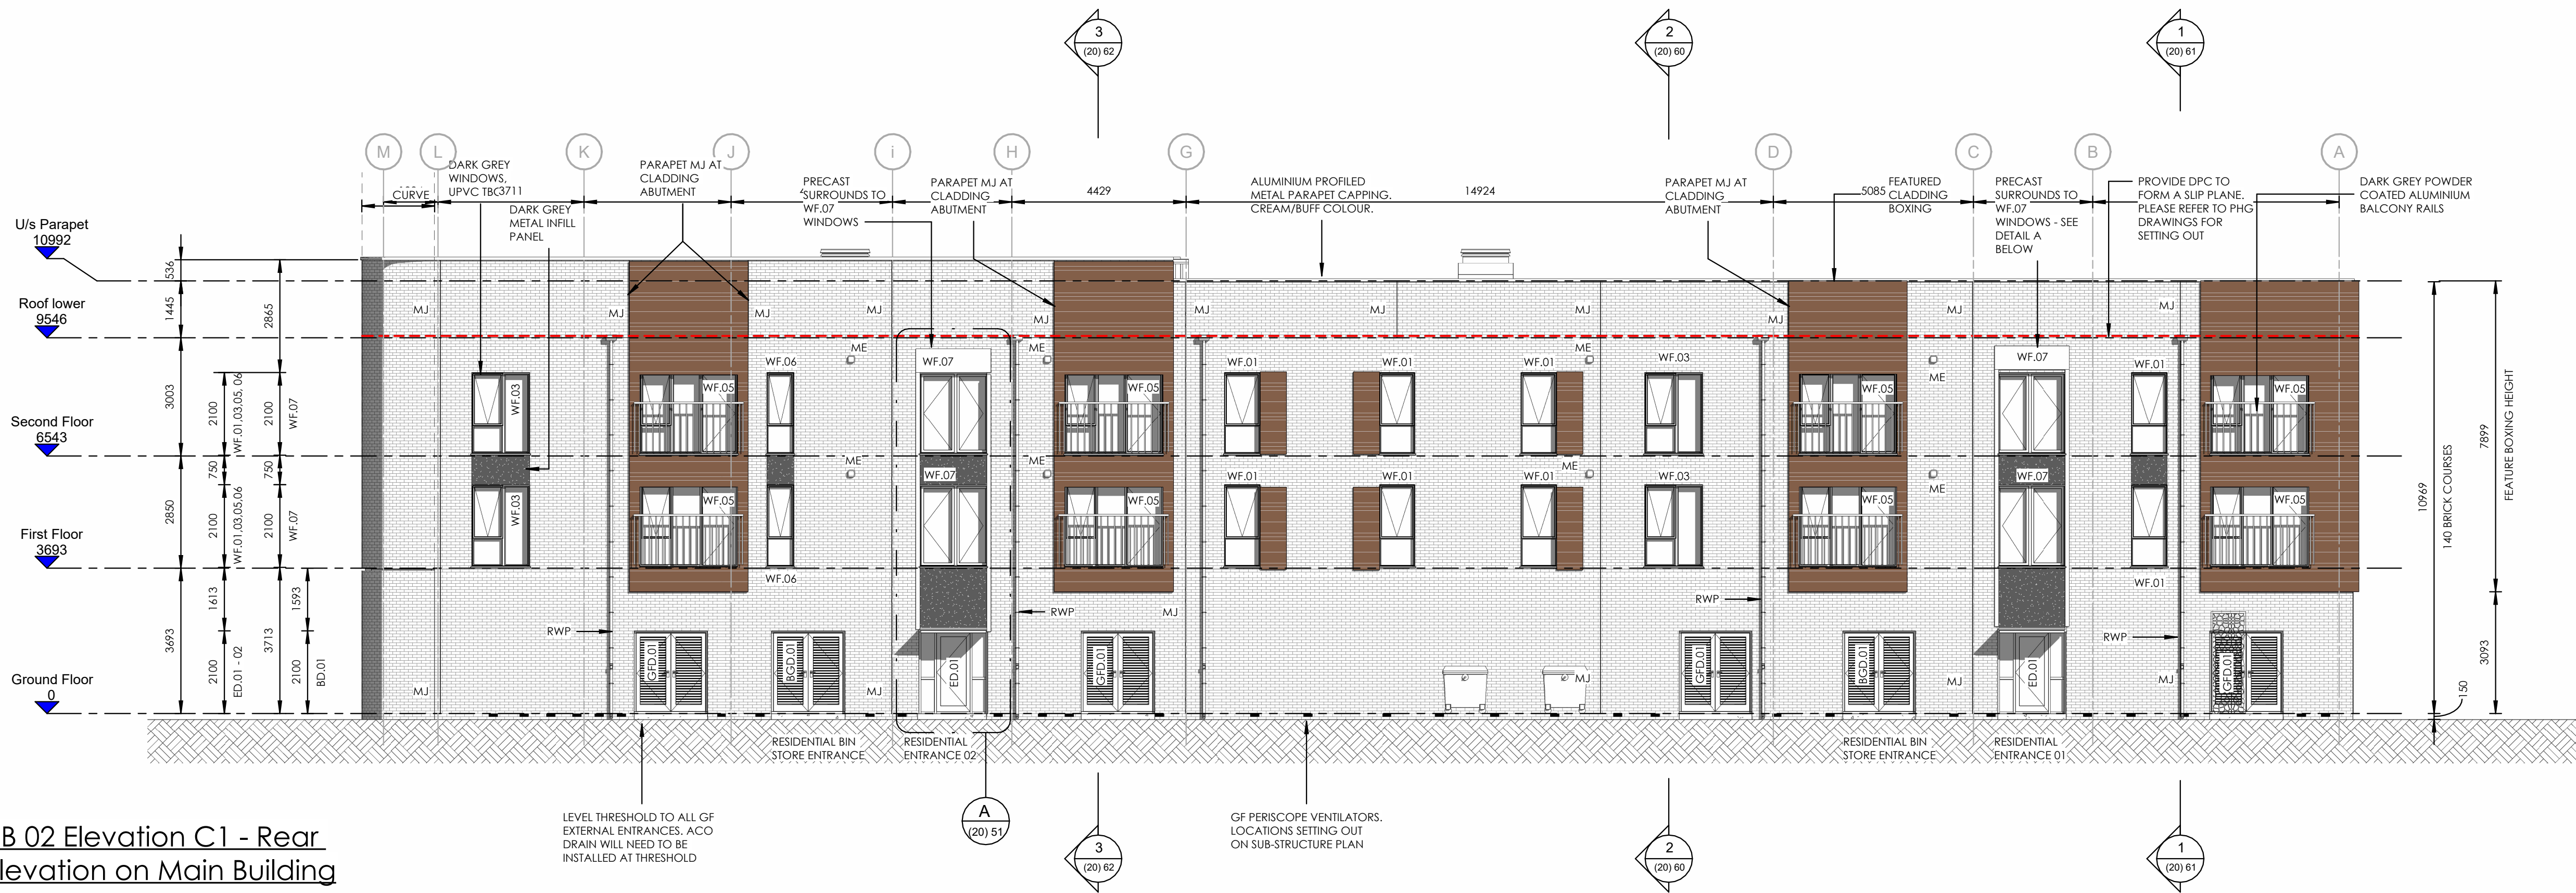

RB 02 Elevation C2 - Rear
Elevation on External Stores

SCALE 1:100 @ A1

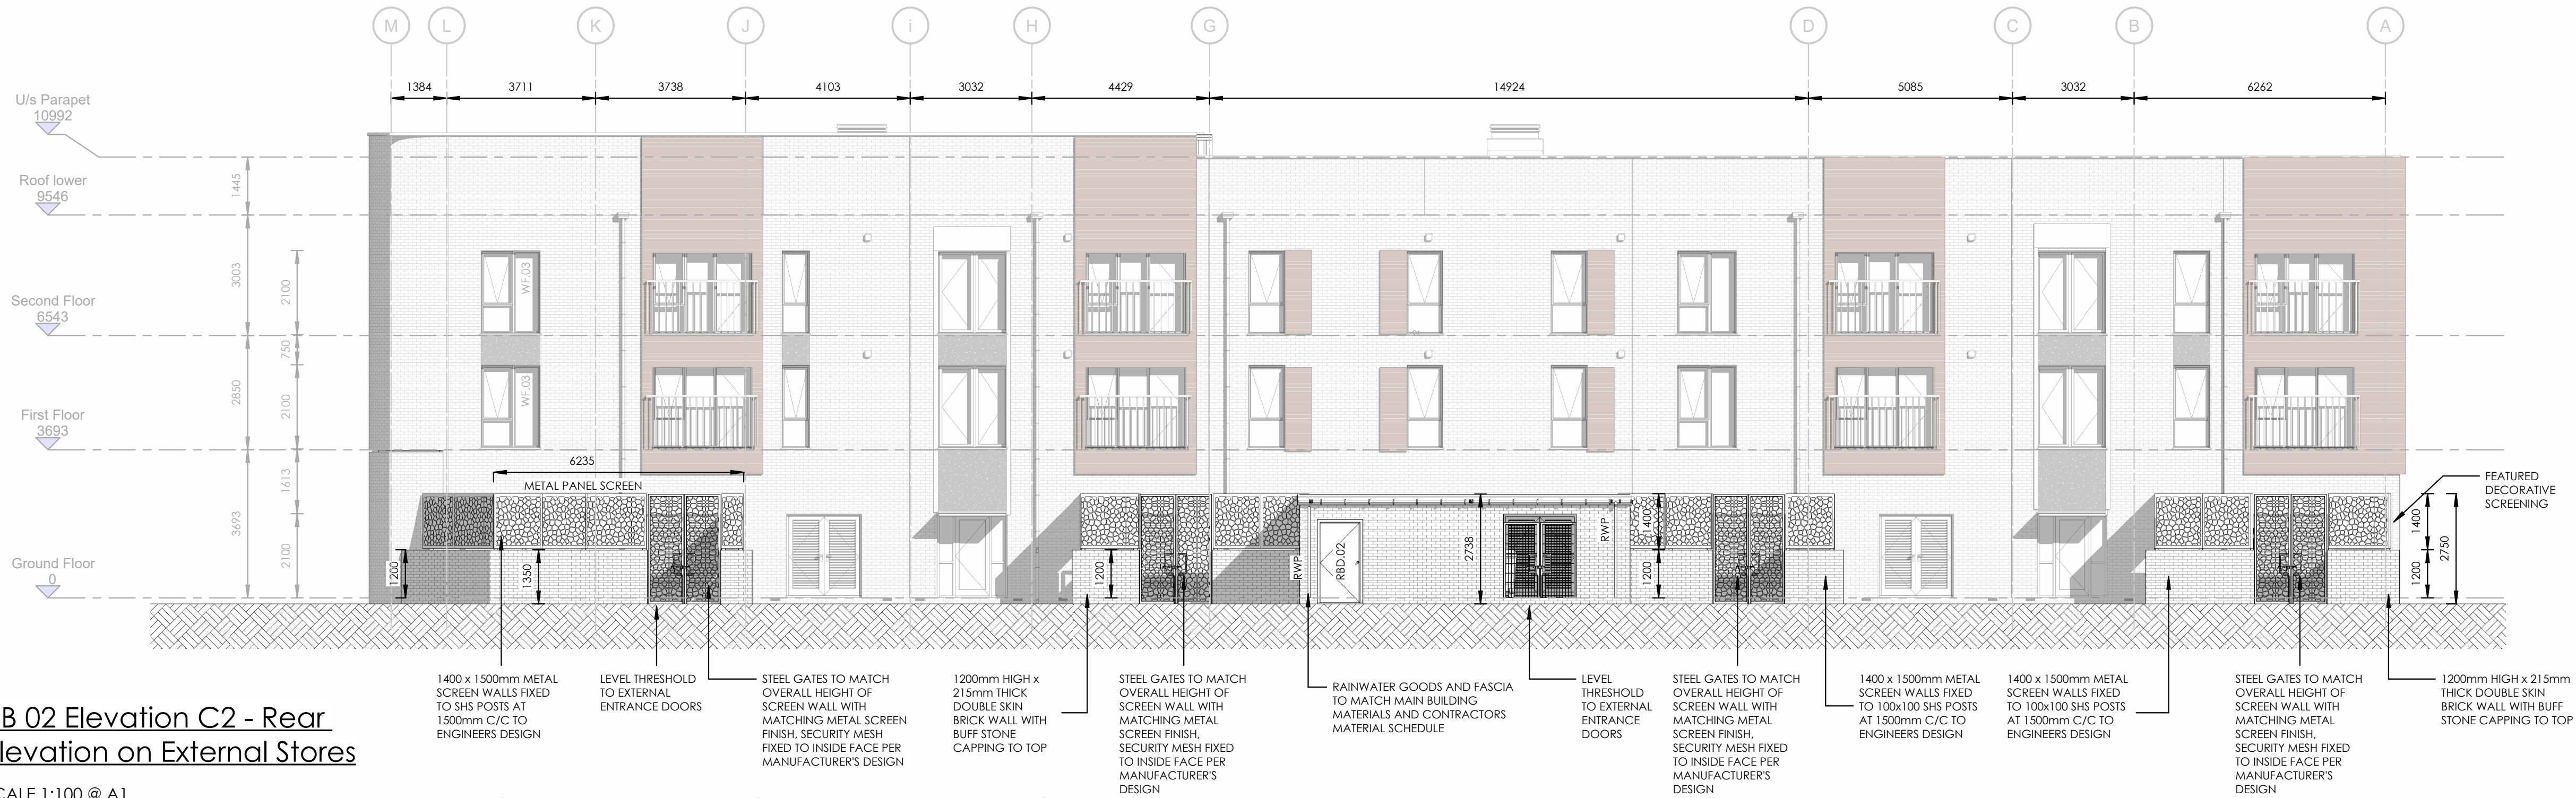

GENERAL NOTES

1. DO NOT SCALE THIS DRAWING. ONLY USE FIGURED DIMENSIONS IF IN DOUBT ASK.
2. UNLESS NOTED OTHERWISE ALL DIMENSION ARE IN MILLIMETRES & ALL LEVELS ARE IN METRES RELATIVE TO ORDINANCE DATUM.
3. ALL LONGITUDINAL AND TRANSVERSE DIMENSIONS ARE MEASURED IN PLAN UNLESS OTHERWISE NOTED.
4. THIS DRAWING IS TO BE READ IN CONJUNCTION WITH ALL SCHEME DRAWINGS AND DESIGNERS RISK ASSESSMENT
5. THE CONTRACTOR IS TO CHECK ALL DIMENSIONS PRIOR TO CONSTRUCTION AND ANY DISCREPANCIES MUST BE REPORTED TO SPRING DESIGN BEFORE PROCEEDING.
6. ALL STATUTORY SERVICES INFORMATION SHOWN HAS BEEN PROVIDED BY THE RELEVANT STATUTORY AUTHORITIES. THE CONTRACTOR IS TO SATISFY HIMSELF AS TO THE ACCURACY OF THE LOCATIONS, SIZE AND MATERIAL AND OWNERSHIP OF THE SERVICES PRIOR TO ANY WORKS BEING CARRIED OUT.

- = DENOTES BUFF BRICK
- = DENOTES PURAFASCADE OKO (OR EQUAL APPROVED) BROWN/TERRACOTA COLOURED FEATURED NON-COMBUSTIBLE CLADDING.
- = DENOTES DARK GREY METAL INFILL PANEL
- = DENOTES BRONZE COLOURED PRESSED METAL PANELS


HOPPERS AND RAIN WATER DRAIN PIPES TO BE PPC ALUMINIUM DARK GREY RAL COLOUR 7015

UPVC WINDOWS TO BE DARK GREY, RAL COLOUR 7015

DOORS TO BE DARK GREY, RAL COLOUR 7015

ALUMINIUM CURTAIN WALL WINDOWS AND DOORS TO BE DARK GREY, RAL COLOUR 7015

ME = MECHANICAL EXTRACT TO MATCH COLOUR OF HOST FASCADE

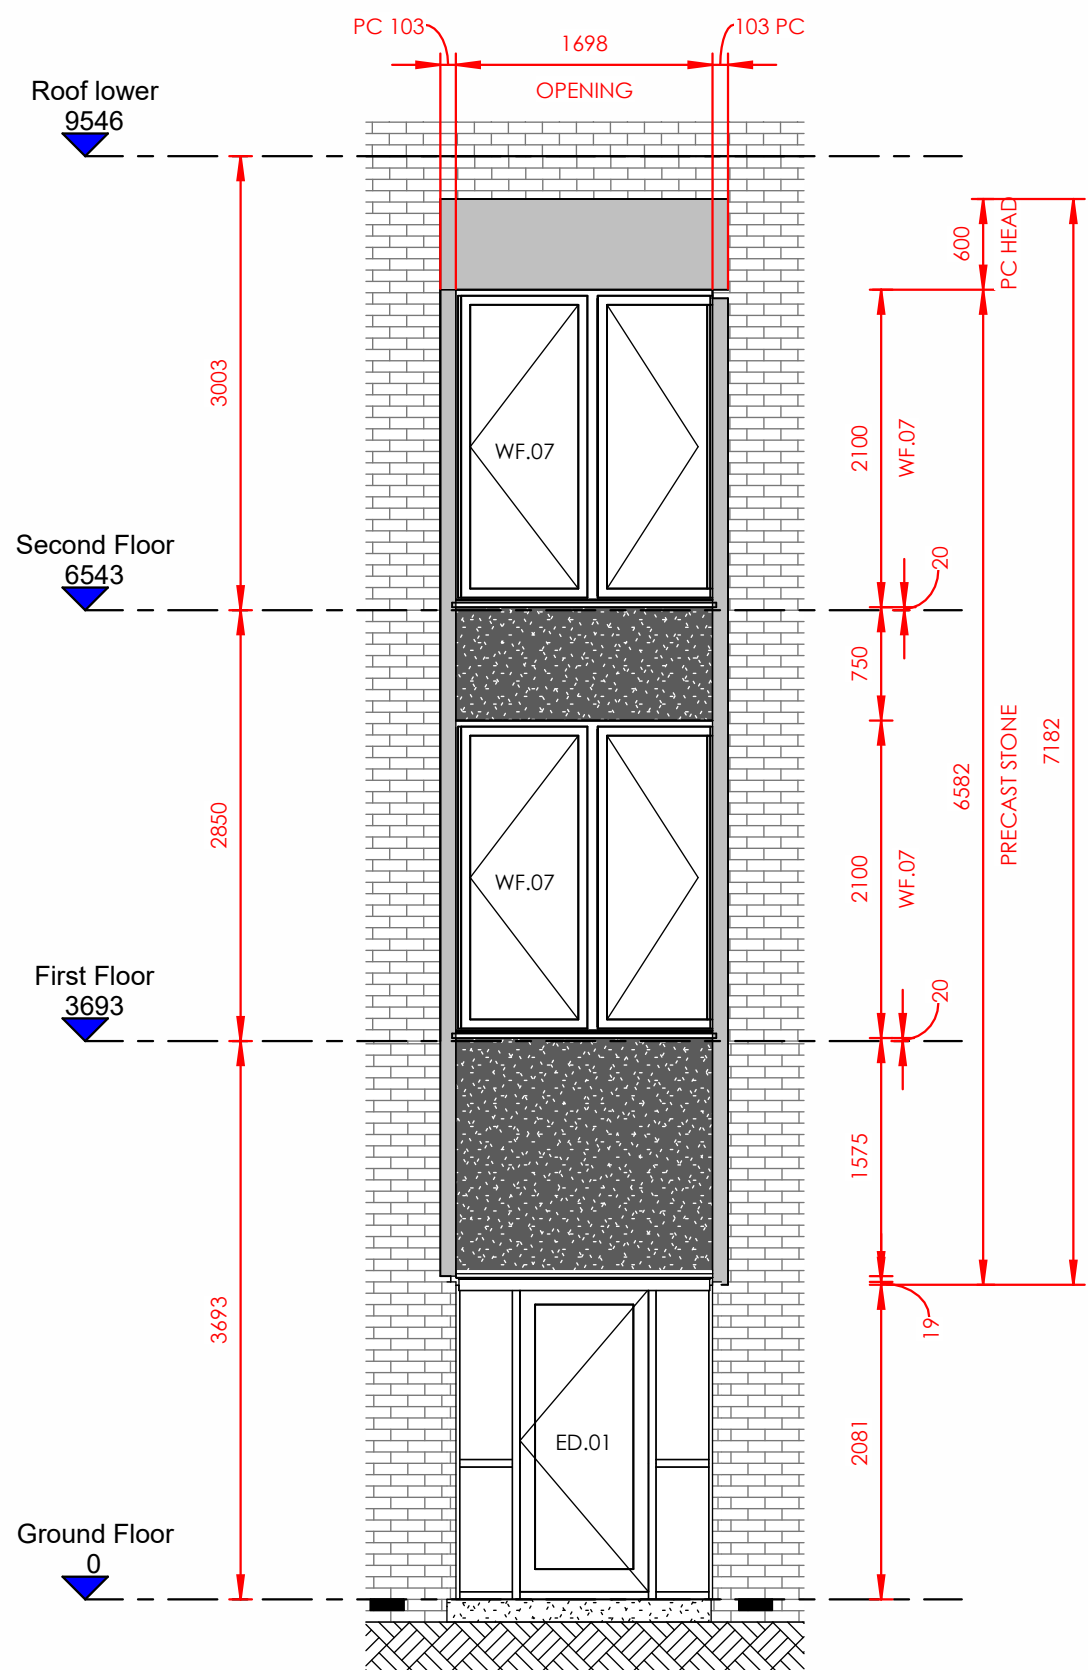

RB.02 Typical Stone
Surround Dims - Detail A

SCALE 1:50 @ A1/ 1:100 @ A3



A1

Original sheet size

Note: This Drawing is copyright. Its use or reproduction is subject to permission from Spring Design Consultancy Limited. All rights are reserved until invoices are paid in full. Contact SDC regarding terms & conditions. Check printed scale. Responsibility is not accepted for reproduction of digital media or measuring from this document. Only figured dimensions to be used for construction. No responsibility will be taken for any design used for construction prior to receipt of relevant approvals. Report doubts/discrepancies to project Architect.

Rev	Date	Description	By
1	29.06.22	Decommissioned perforated screen walls corrected	MLM
2	29.06.22	Decommissioned perforated screen walls corrected	MLM
Client
Lovell Group

Project
Ringland Regeneration

Drawing Status
AS BUILT ISSUE

Date
29.06.22

Drawn By
MLM

Checked By
MLM

Director
CW

Scale
As indicated@A1

Drawing Title
RB 02 - Elevations C1 & C2 (Rear Elevations)

305 No.
2603

02 (20) 51

Rev
M

Unit 2 Chapel Barrs | Merthyr Mawr | Bridgend | CF32 0LS

spring design

Unit 2 Chapel Barrs | Merthyr Mawr | Bridgend | CF32 0LS

spring design