

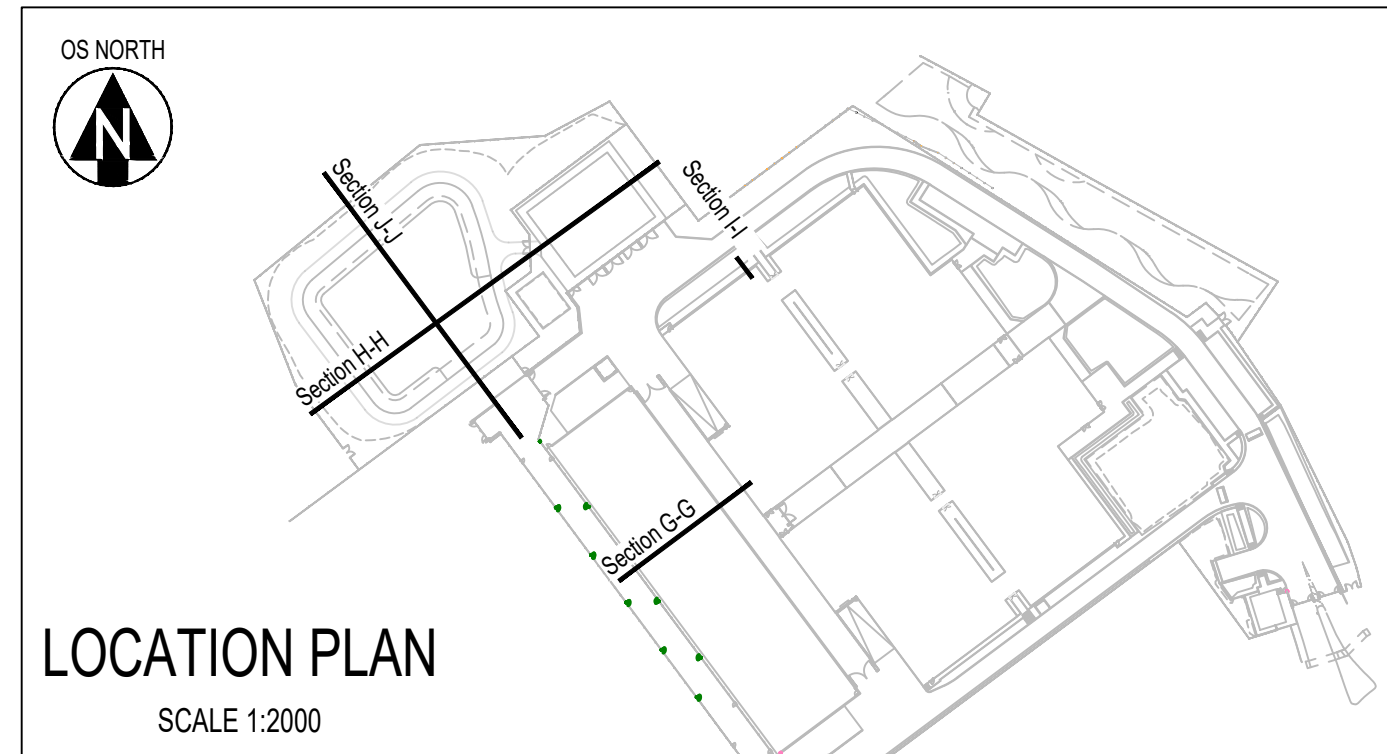
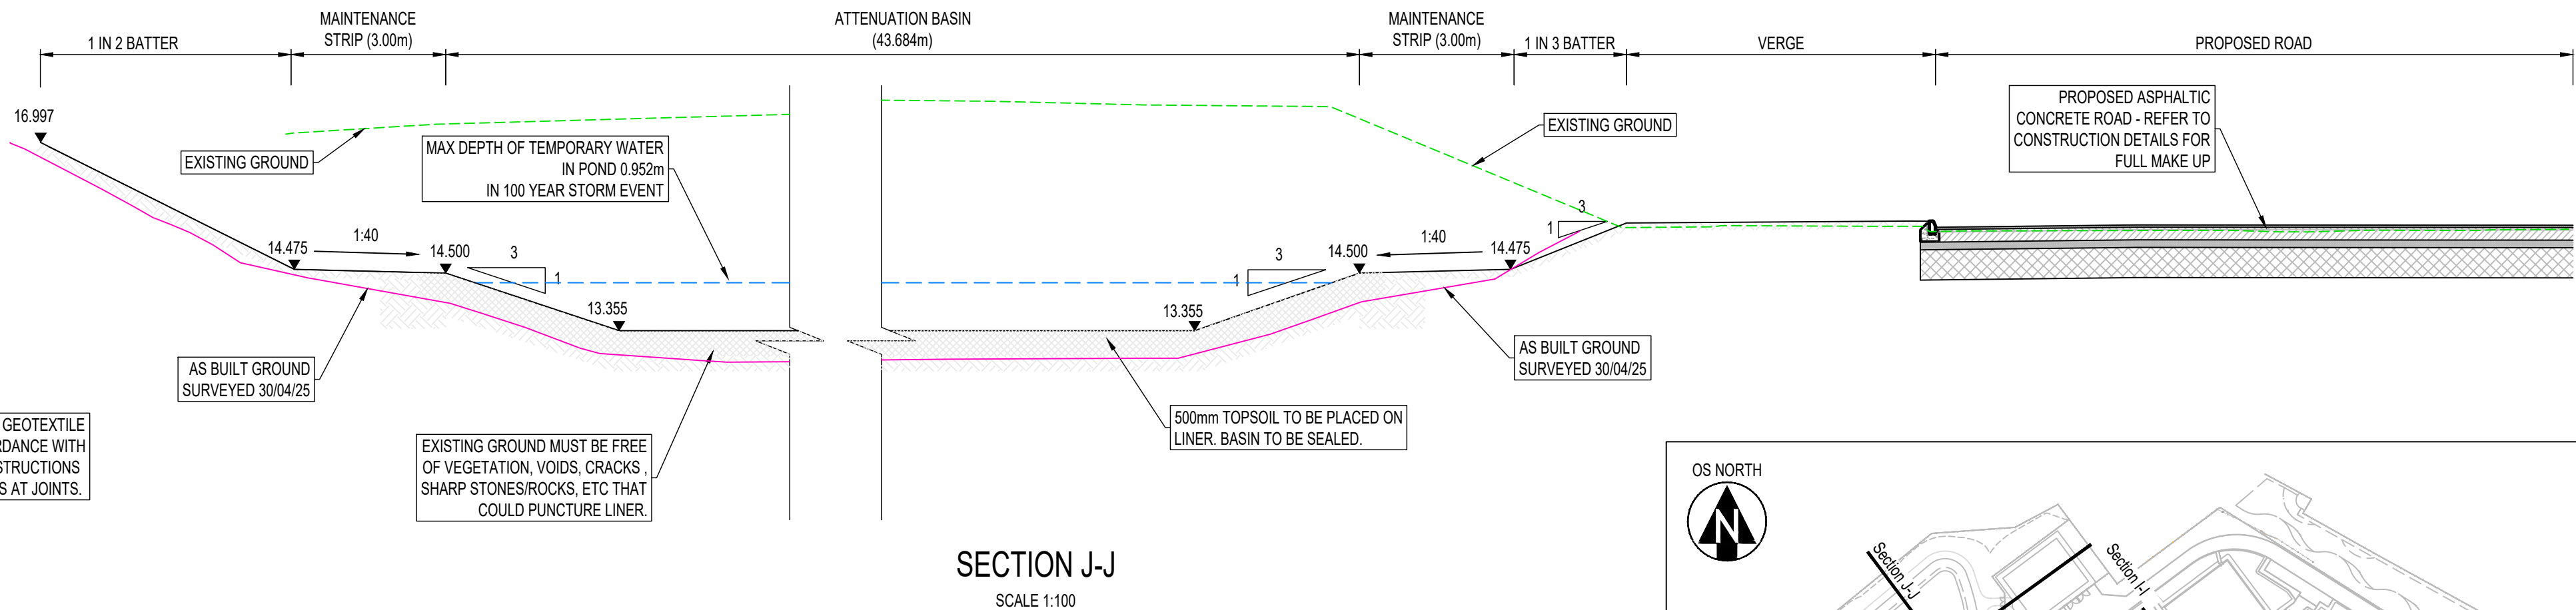
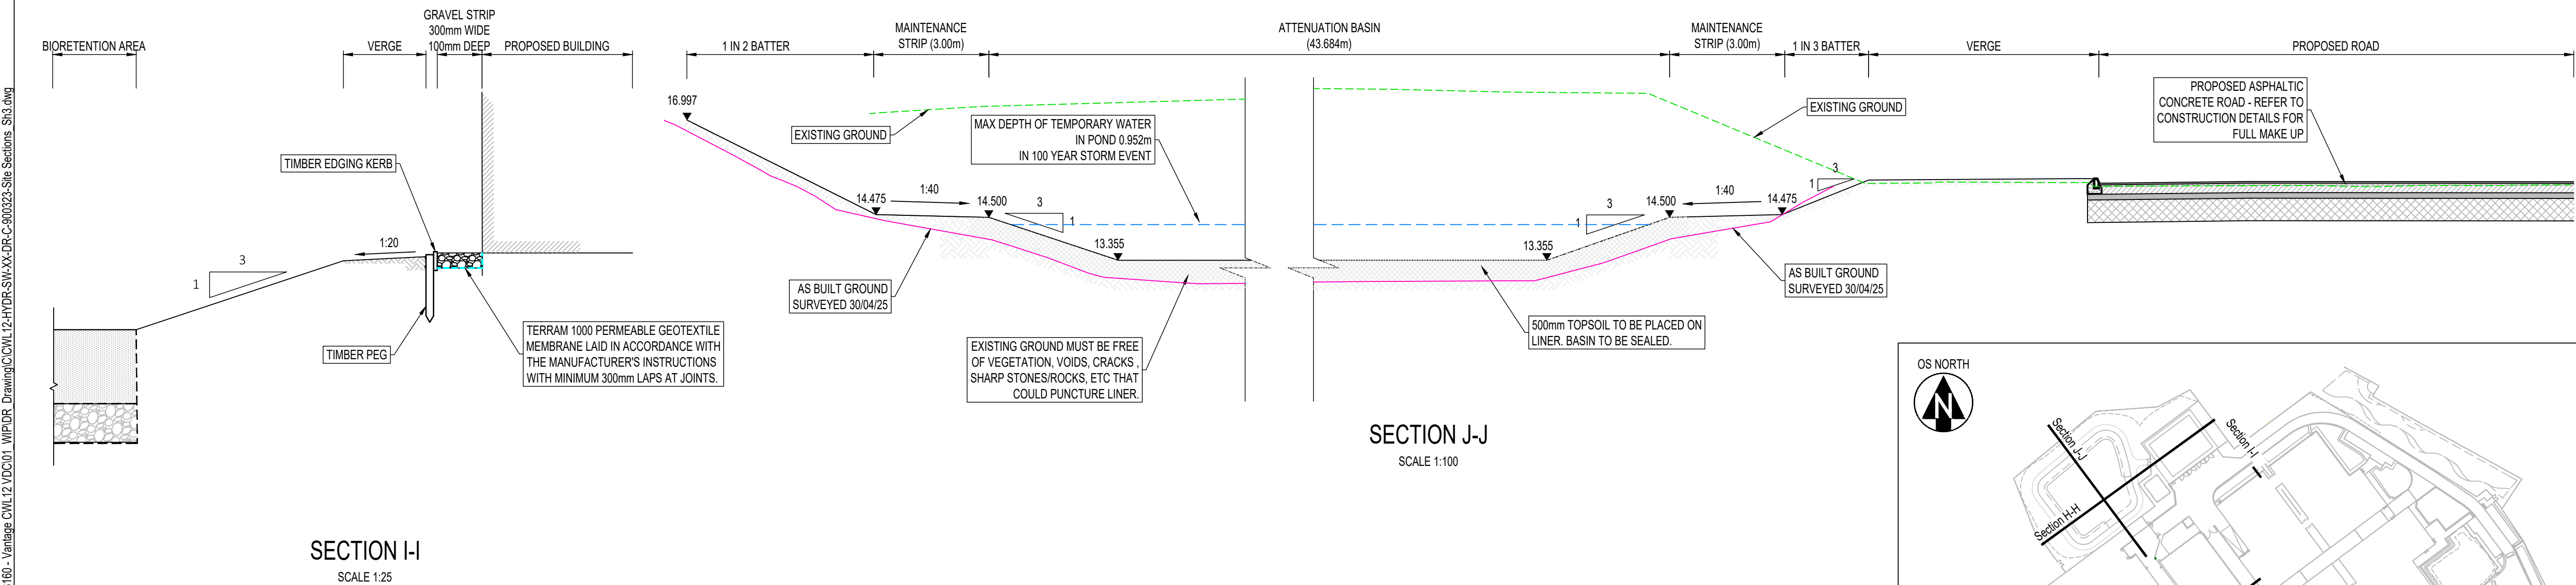
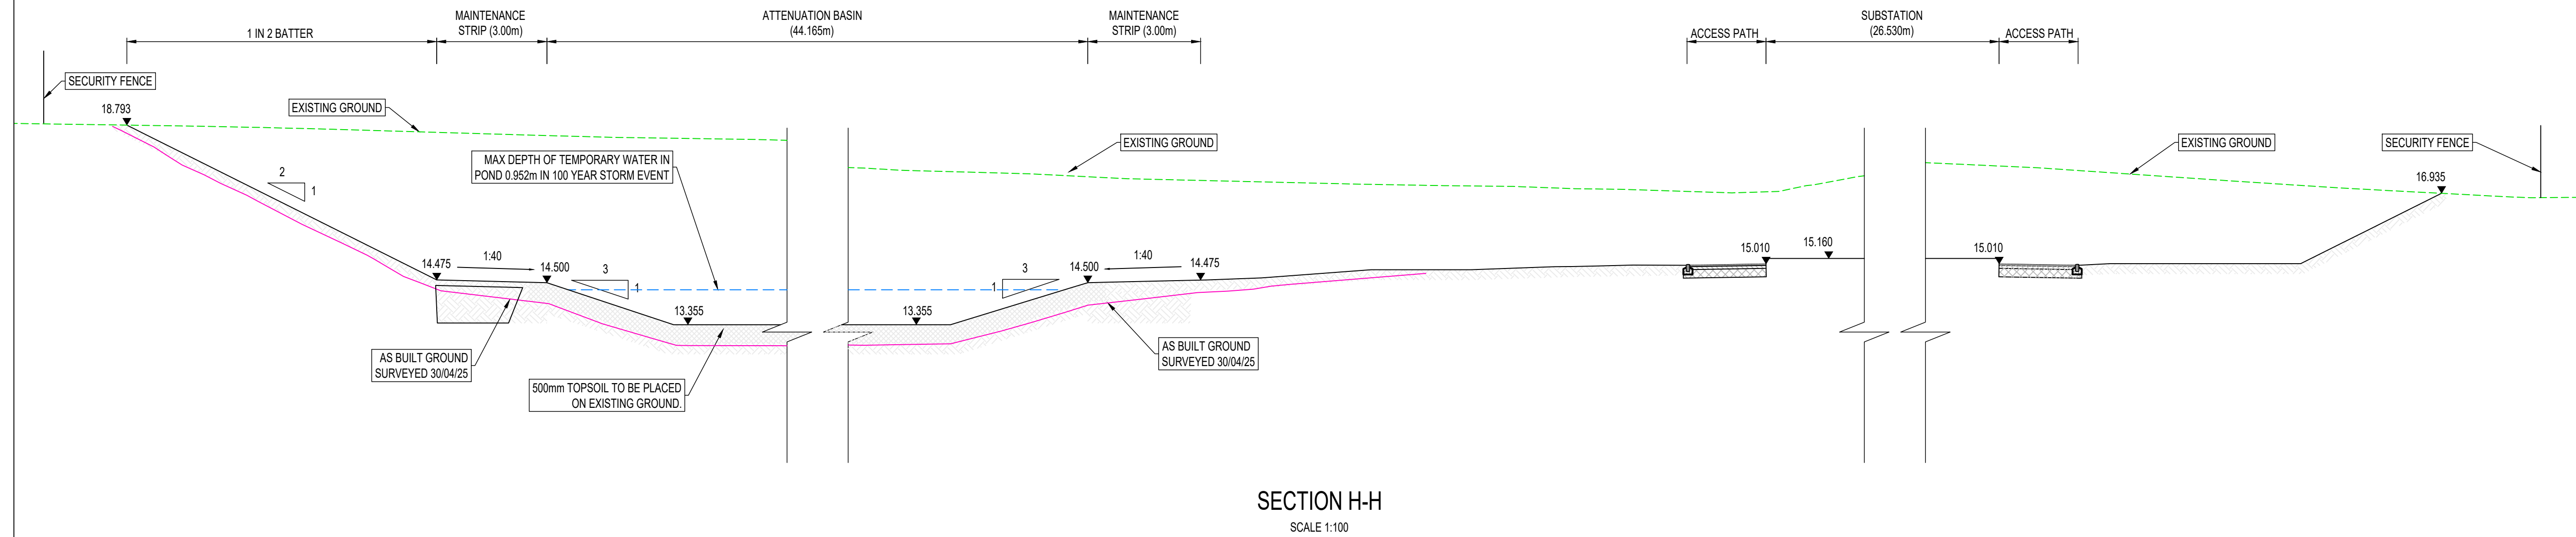


Filename: P:\33000-33989\33160 - Vantage CWL12\DC01 - WIP\DR - Drawings\CWL12-HYDR-SW-XX-DR-C-900323-Site Sections S03.dwg

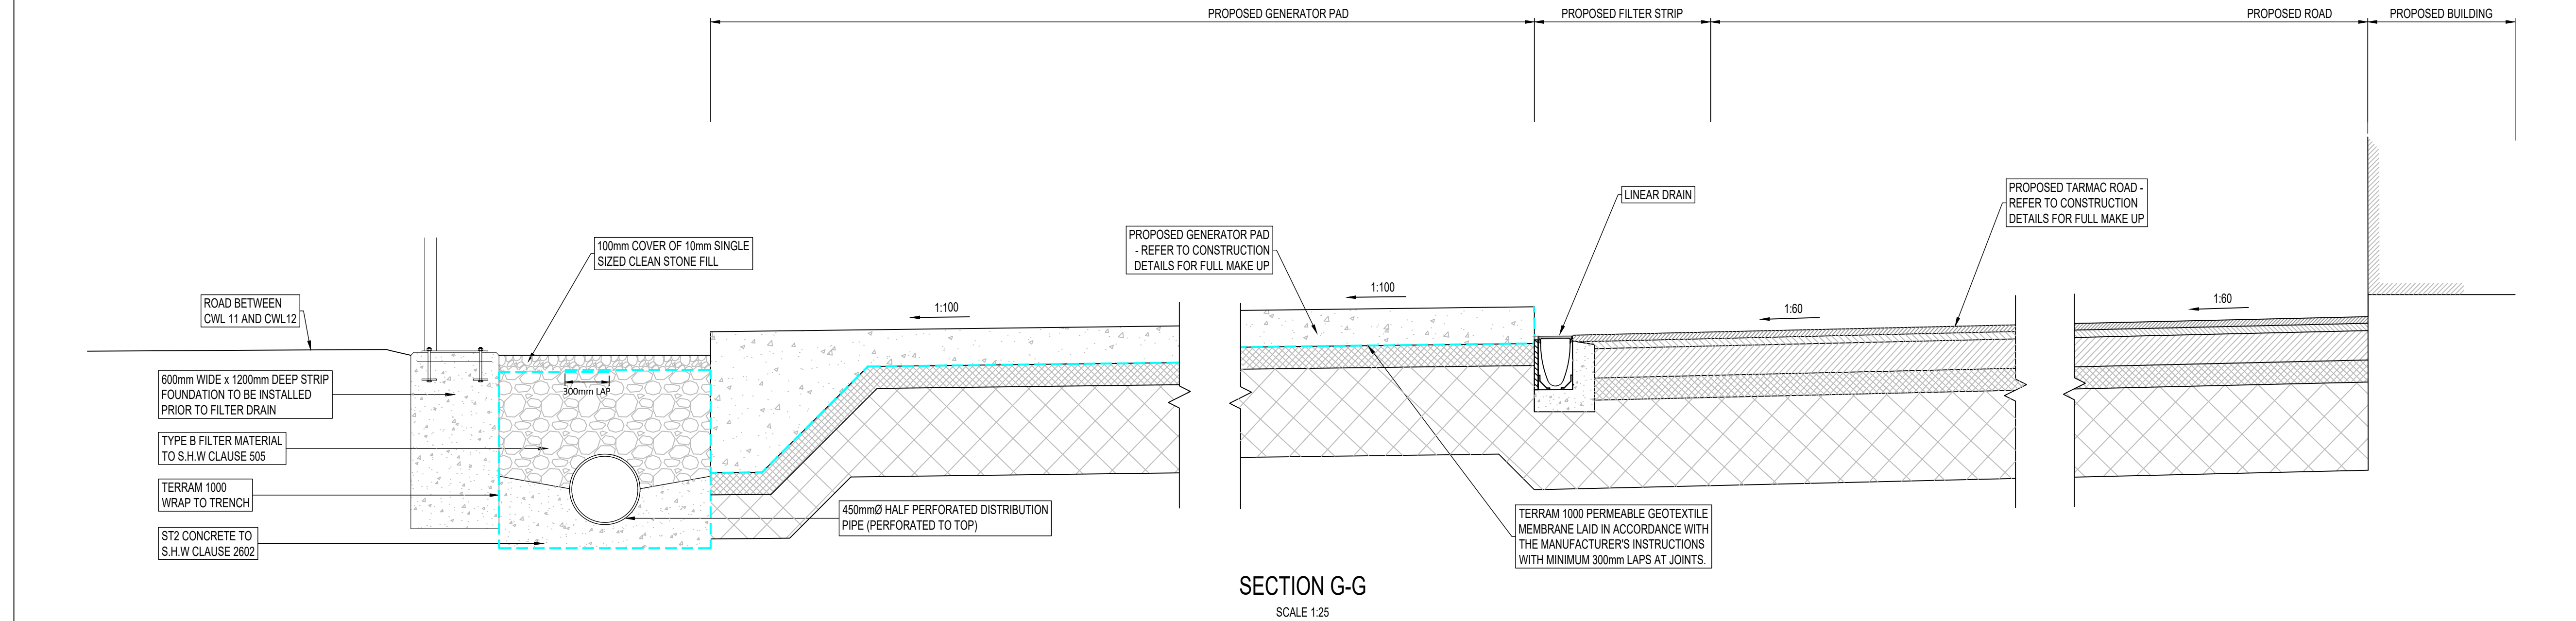

- GENERAL NOTES:
- DRAWING TO BE READ IN CONJUNCTION WITH ALL OTHER RELEVANT PROJECT DRAWINGS AND SPECIFICATIONS.

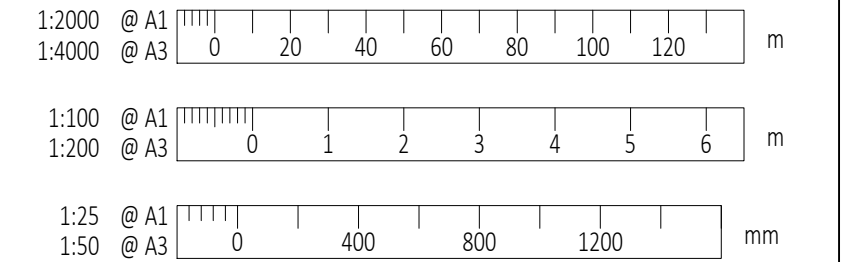

REVISIONS							
C05	Section H-H extended						
S5	ML	14/05/25	AS	14/05/25	ML	14/05/25	
C04	Existing and as built ground added						
S5	AS	09/05/25	ML	12/05/25	ML	12/05/25	
C03	General Update						
S2	JK	19/04/24	ML	19/04/24	ML	19/04/24	
C02	General Update						
S2	JK	12/04/24	ML	12/04/24	ML	12/04/24	
C01	WS4 Issue						
S2	AS	19/01/24	ML	19/01/24	ML	19/01/24	
P02	UPDATED TO SAB COMMENTS						
S2	JG	13/10/23	CS	13/10/23	CS	13/10/23	
P01	ISSUED FOR INFORMATION						
S2	MPC	31/07/23	CS	31/07/23	CS	31/07/23	
REV	REVISION NOTES/COMMENTS						
STA.	DRAWN BY	DATE	CHECKED BY	DATE	APPROVED BY	DATE	

Hydrock

THIRD FLOOR, WHARTON PLACE
13 WHARTON STREET
CARDIFF
CF10 1GS
t: +44 (0) 2920 023665
e: cardiff@hydrock.com

CLIENT

VANTAGE
DATA CENTERS

PROJECT

VANTAGE CWL12

TITLE

SITE SECTIONS
SHEET 3 OF 3

HYDROCK PROJECT NO.		SCALE @ A1	
C-33160		AS SHOWN	
STATUS DESCRIPTION			STATUS
STAGE APPROVAL STAGE 5			S5
DRAWING NO. (PROJECT-ORIGINATOR-ZONE-LEVEL-TYPE-ROLE-NUMBER)			REVISION
CWL12-HYDR-SW-XX-DR-C-900323			C05