



Notes
1- All work is to be carried out the requirements, to the satisfaction of the Local Authorities. These drawings are for planing purposes only.
2- Responsibility is not accepted for errors made by others in scaling from this drawing. All construction information should be cross checked on the site.
3- All discrepancies and change of design requests by authorities should be reported to surveyor immediately.
4- All drawings to be read in conjunction with the project specification with all works carried out in accordance with the latest British Standards and codes of practice. Planning drawings are not to be used for the purpose of building & installation regulations.
5-It is assumed that all works will be carried out by a competent contractor working, where appropriate, to an approved method statement.
6-It is contractor's responsibility to notify the Building Control and get approval before any work commences.
7- It is contractors responsibility to determine if any wall is load-bearing.
8-Dimensions are based on information provided and existing records.
9-All dimensions are in millimeters.
10-The copyright of this drawing belongs to Se & Se Consultancy Ltd.


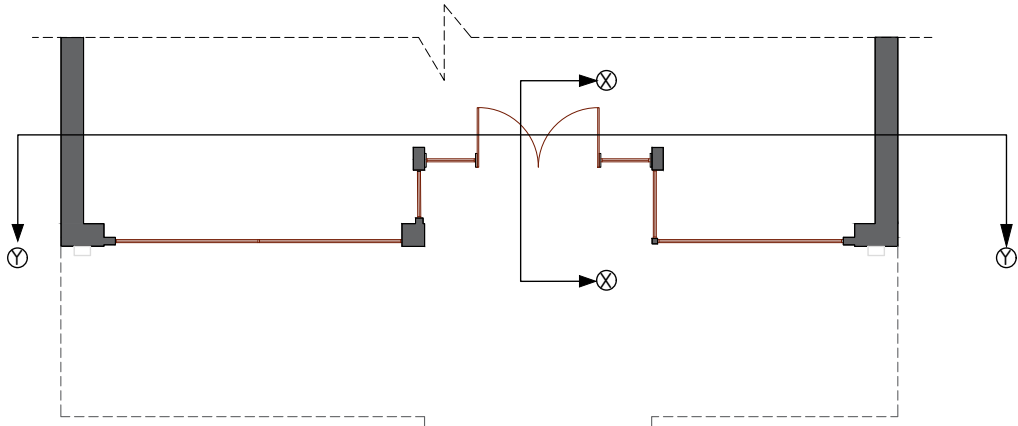


Pre-Existing Front Elevation

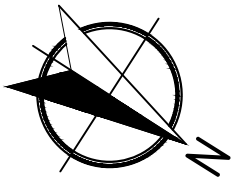

Address 165 Commercial Street, Newport, NP20 1JN.		Rev V3	Date 06/10/2025	 Architecture - Town Planning Premises Licensing E: info@seandse.co.uk T: 020 4579 53 00 M: +44 (0) 7404 765500 W: www.seandse.co.uk
Sheet 1/8	Name Pre-Existing Front Elevation.		Drawn By MDF	
Reference 165CS-0610-PEFE			Checked By SS	

Notes
1- All work is to be carried out the requirements, to the satisfaction of the Local Authorities. These drawings are for planing purposes only.
2- Responsibility is not accepted for errors made by others in scaling from this drawing. All construction information should be cross checked on the site.
3- All discrepancies and change of design requests by authorities should be reported to surveyor immediatelly.
4- All drawings to be read in conjunction with the project specification with all works carried out in accordance with the latest British Standards and codes of practice. Planning drawings are not to be used for the purpose of building & installation regulations.
5-It is assumed that all works will be carried out by a competent contractor working, where appropriate, to an approved method statement.
6-It is contractor's responsibility to notify the Building Control and get approval before any work commences.
7- It is contractors responsibility to determine if any wall is load-bearing.
8-Dimensions are based on information provided and existing records.
9-All dimensions are in millimeters.
10-The copyright of this drawing belongs to Se & Se Consultancy Ltd.

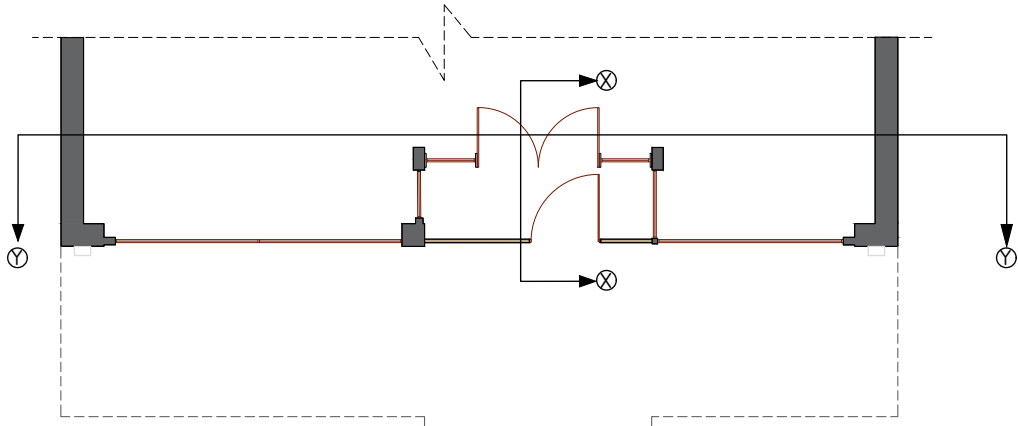
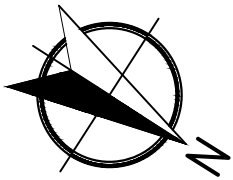


Existing Front Elevation



Address 165 Commercial Street, Newport, NP20 1JN.		Rev V3	Date 06/10/2025	 Architecture - Town Planning Premises Licensing E: info@seandse.co.uk T: 020 4579 53 00 M: +44 (0) 7404765500 W: www.seandse.co.uk
Sheet 2/8	Name Existing Front Elevation.		Drawn By MDF	
Reference 165CS-0610-EFE			Checked By SS	

Notes
1- All work is to be carried out the requirements, to the satisfaction of the Local Authorities. These drawings are for planing purposes only.
2- Responsibility is not accepted for errors made by others in scaling from this drawing. All construction information should be cross checked on the site.
3- All discrepancies and change of design requests by authorities should be reported to surveyor immediatelly.
4- All drawings to be read in conjunction with the project specification with all works carried out in accordance with the latest British Standards and codes of practice. Planning drawings are not to be used for the purpose of building & installation regulations.
5-It is assumed that all works will be carried out by a competent contractor working, where appropriate, to an approved method statement.
6-It is contractor's responsibility to notify the Building Control and get approval before any work commences.
7- It is contractors responsibility to determine if any wall is load-bearing.
8-Dimensions are based on information provided and existing records.
9-All dimensions are in millimeters.
10-The copyright of this drawing belongs to Se & Se Consultancy Ltd.

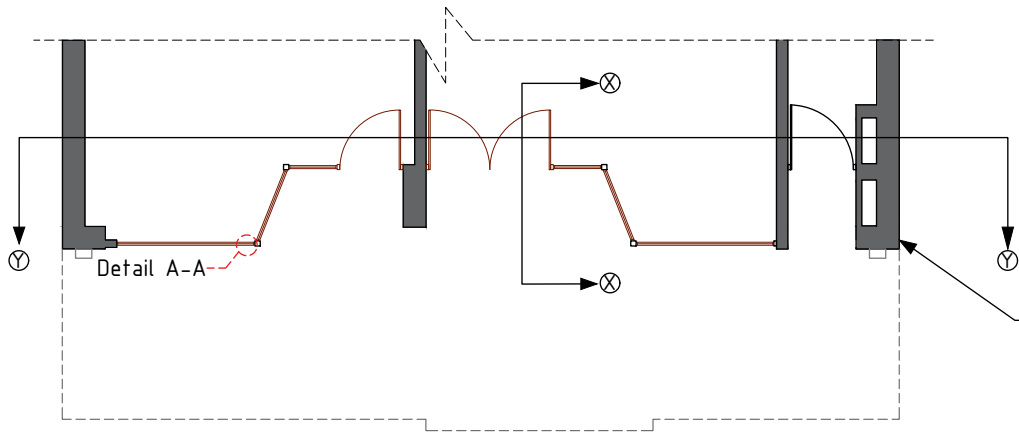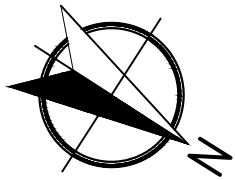

Planning Application (Ref. 21/0311)
Approved for ground floor alterations.





Proposed Front Elevation
(Shutters Closed).

1:100 @A3



Address	165 Commercial Street, Newport, NP20 1JN.	Rev	V3	Date	06/10/2025	 Architecture - Town Planning Premises Licensing E: info@seandse.co.uk T: 020 4579 53 00 M: +44 (0) 7404 765500 W: www.seandse.co.uk
Sheet	3/8	Name	Proposed Front Elevation (Shutters Closed).	Drawn By	MDF	
Reference	165CS-0610-PFE/SC			Checked By	SS	

Notes
1- All work is to be carried out the requirements, to the satisfaction of the Local Authorities. These drawings are for planing purposes only.
2- Responsibility is not accepted for errors made by others in scaling from this drawing. All construction information should be cross checked on the site.
3- All discrepancies and change of design requests by authorities should be reported to surveyor immediatelly.
4- All drawings to be read in conjunction with the project specification with all works carried out in accordance with the latest British Standards and codes of practice. Planning drawings are not to be used for the purpose of building & installation regulations.
5-It is assumed that all works will be carried out by a competent contractor working, where appropriate, to an approved method statement.
6-It is contractor's responsibility to notify the Building Control and get approval before any work commences.
7- It is contractors responsibility to determine if any wall is load-bearing.
8-Dimensions are based on information provided and existing records.
9-All dimensions are in millimeters.
10-The copyright of this drawing belongs to Se & Se Consultancy Ltd.

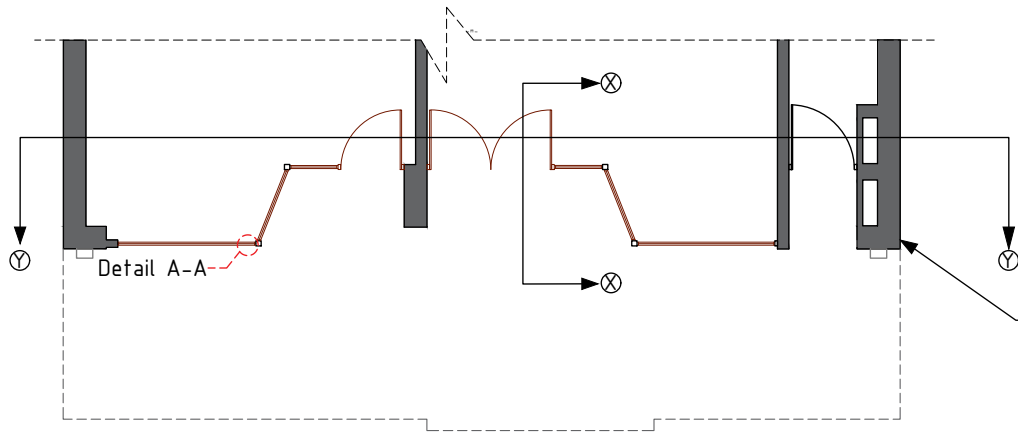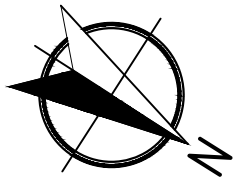

Planning Application (Ref. 21/0311)
Approved for ground floor alterations.





Proposed Front Elevation
(Shutters Open).

1:100 @A3




Address 165 Commercial Street, Newport, NP20 1JN.		Rev V3	Date 06/10/2025	 Architecture - Town Planning Premises Licensing E: info@seandse.co.uk T: 020 4579 53 00 M: +44 (0) 7404765500 W: www.seandse.co.uk
Sheet 4/8	Name Proposed Front Elevation (Shutters Open).		Drawn By MDF	
Reference 165CS-0610-PFE/SO			Checked By SS	


- Notes
- 1- All work is to be carried out the requirements, to the satisfaction of the Local Authorities. These drawings are for planing purposes only.
 - 2- Responsibility is not accepted for errors made by others in scaling from this drawing. All construction information should be cross checked on the site.
 - 3- All discrepancies and change of design requests by authorities should be reported to surveyor immediately.
 - 4- All drawings to be read in conjunction with the project specification with all works carried out in accordance with the latest British Standards and codes of practice. Planning drawings are not to be used for the purpose of building & installation regulations.
 - 5-It is assumed that all works will be carried out by a competent contractor working, where appropriate, to an approved method statement.
 - 6-It is contractor's responsibility to notify the Building Control and get approval before any work commences.
 - 7- It is contractors responsibility to determine if any wall is load-bearing.
 - 8-Dimensions are based on information provided and existing records.
 - 9-All dimensions are in millimeters.
 - 10-The copyright of this drawing belongs to Se & Se Consultancy Ltd.

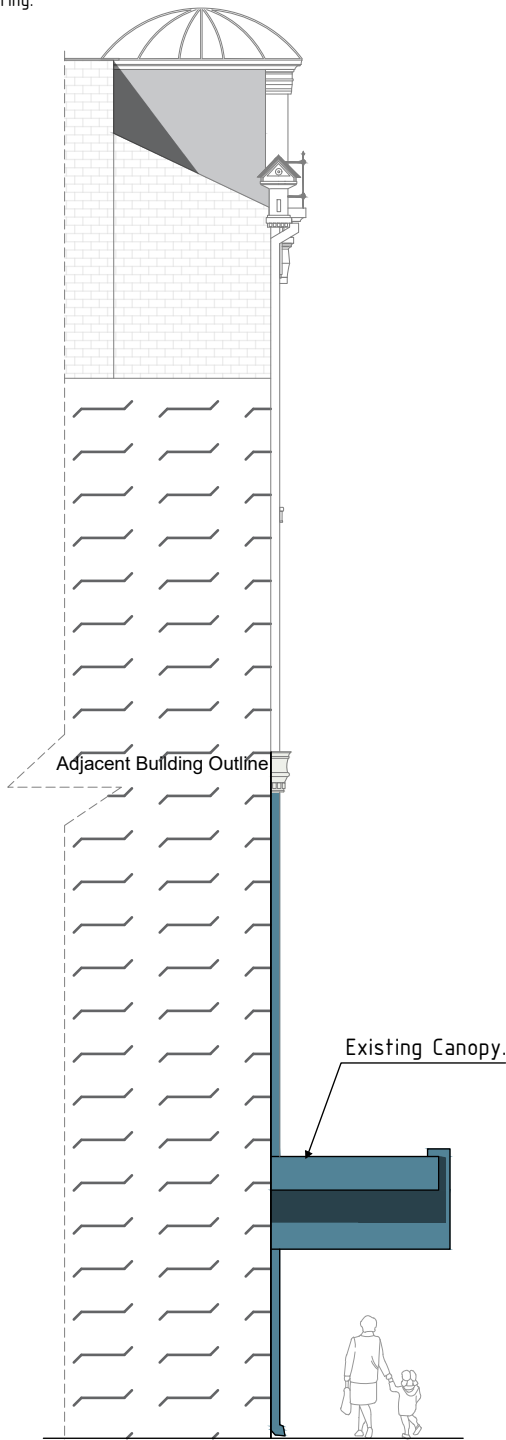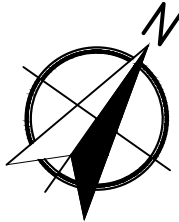

Pre-existing Left Side Elevation.

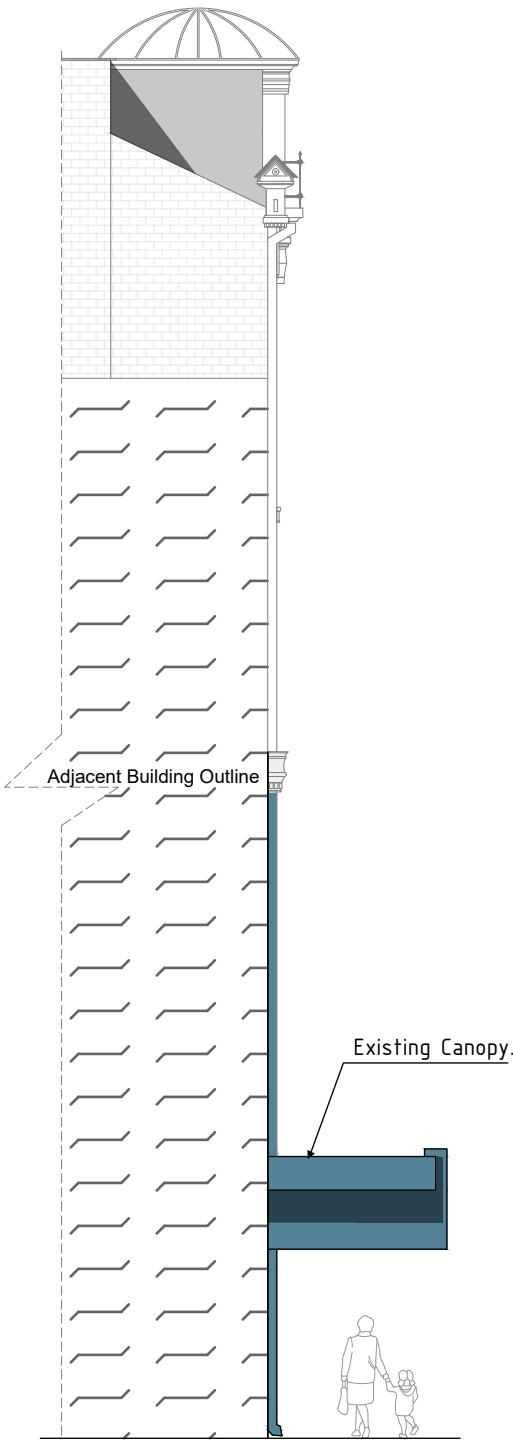


Existing As-built Left Side Elevation.

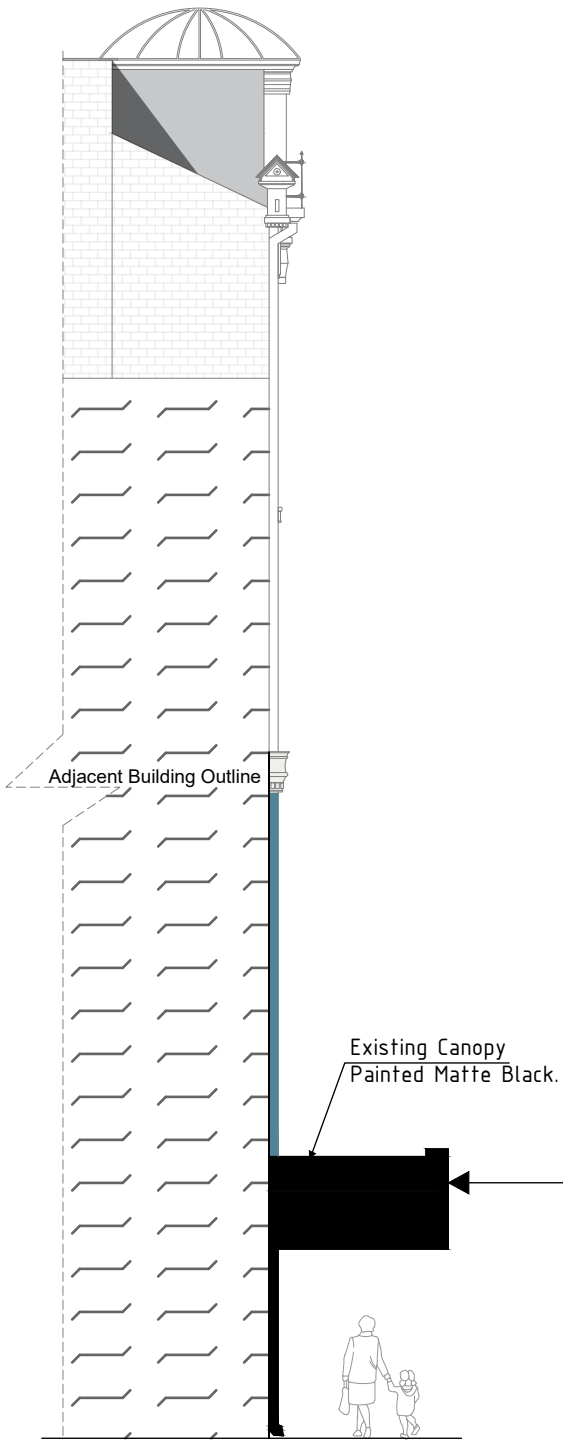



Proposed Left Side Elevation

Advertisement Consent
Application in Progress.

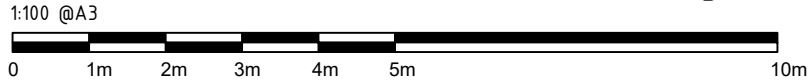


Address	165 Commercial Street, Newport, NP20 1JN.		Drawn By	Date	Rev	 Architecture - Town Planning Premises Licensing E: info@seandse.co.uk T: 020 4579 53 00 M: +44 (0) 7404765500 W: www.seandse.co.uk	
Sheet	5/8	Name Pre-Existing, Existing As-built & Proposed Left Side Elevation.	MDF	06/10/2025	V3		
Reference	165CS-0610-PE/E/PLSE.		Checked By				SS


Notes
1- All work is to be carried out the requirements, to the satisfaction of the Local Authorities. These drawings are for planing purposes only.
2- Responsibility is not accepted for errors made by others in scaling from this drawing. All construction information should be cross checked on the site.
3- All discrepancies and change of design requests by authorities should be reported to surveyor immediatelly.
4- All drawings to be read in conjunction with the project specification with all works carried out in accordance with the latest British Standards and codes of practice. Planning drawings are not to be used for the purpose of building & installation regulations.
5-It is assumed that all works will be carried out by a competent contractor working, where appropriate, to an approved method statement.
6-It is contractor's responsibility to notify the Building Control and get approval before any work commences.
7- It is contractors responsibility to determine if any wall is load-bearing.
8-Dimensions are based on information provided and existing records.
9-All dimensions are in millimeters.
10-The copyright of this drawing belongs to Se & Se Consultancy Ltd.

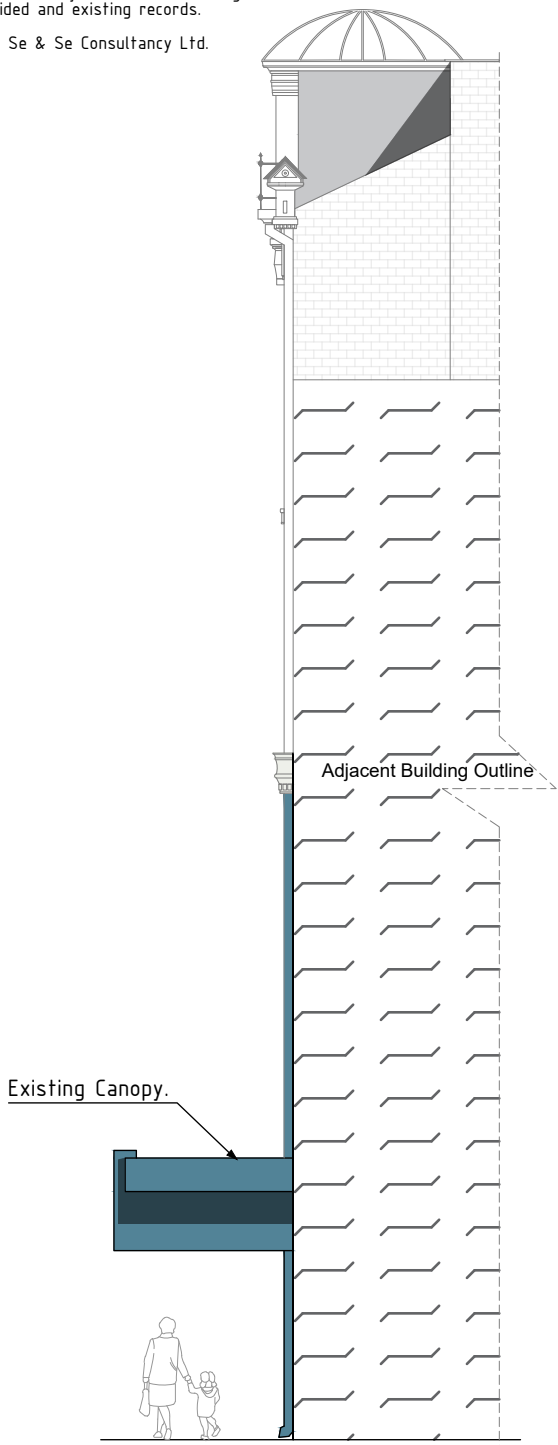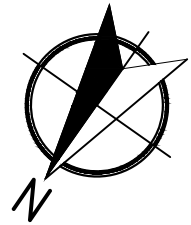

Pre-existing Right Side Elevation

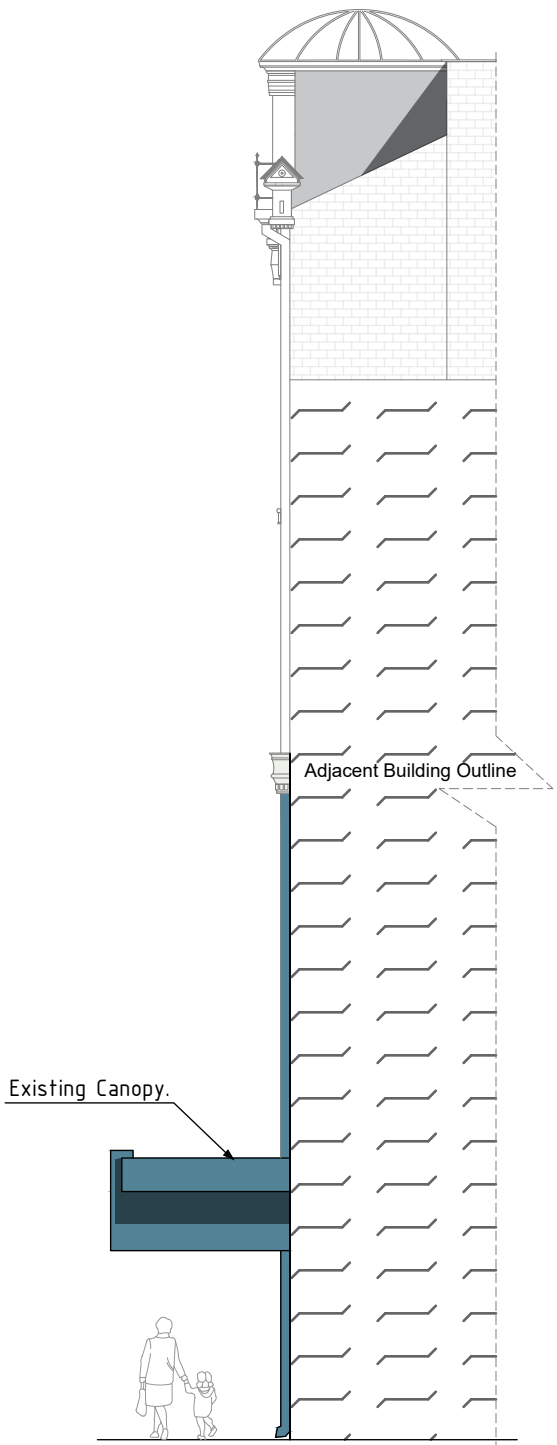

Existing As-built Right Side Elevation

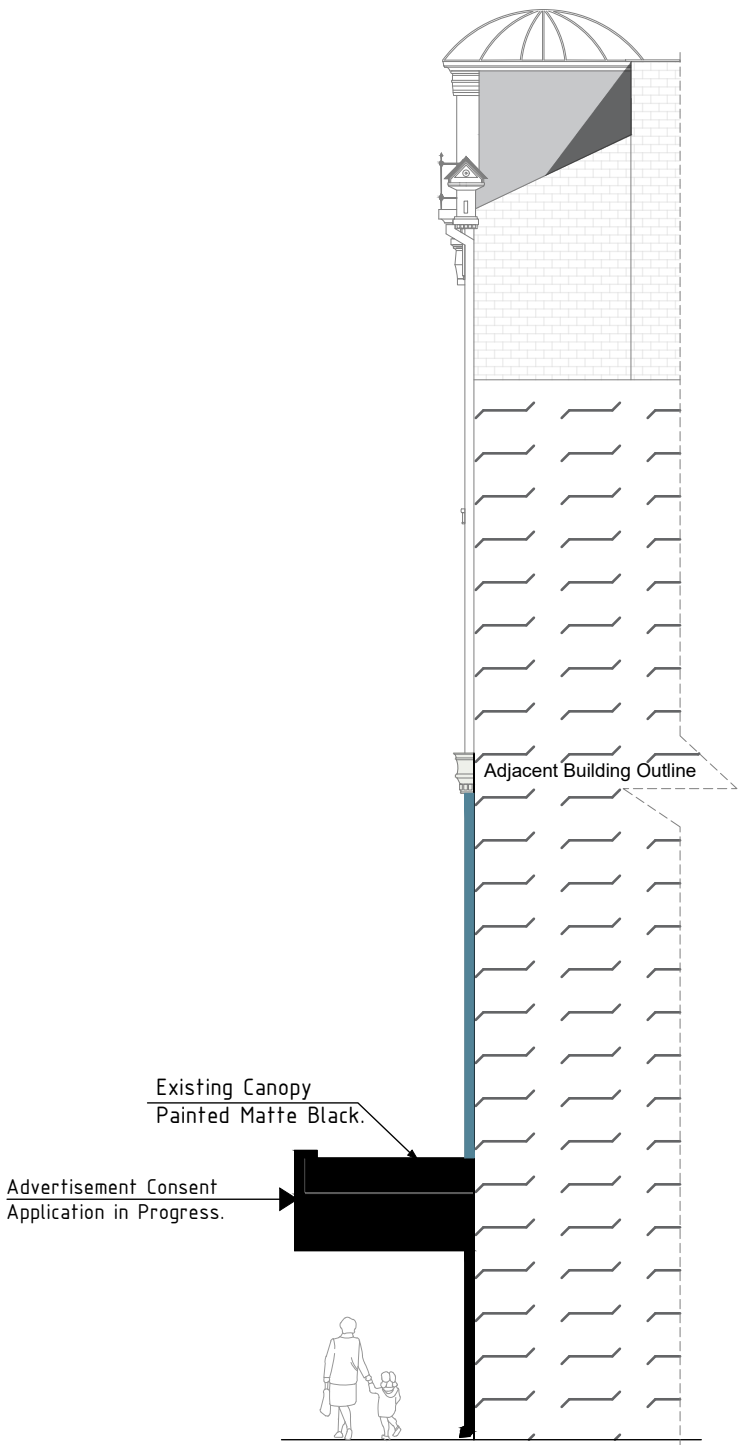


Proposed Right Side Elevation




Address	165 Commercial Street, Newport, NP20 1JN.	Drawn By	MDF	Date	06/10/2025	Rev	V3	 Architecture - Town Planning Premises Licensing E: info@seandse.co.uk T: 020 4579 53 00 M: +44 (0) 7404765500 W: www.seandse.co.uk
Sheet	6/8	Checked By	SS					
Reference	165CS-0610-PE/E/PRSE							
Name		Pre-Existing, Existing As-built & Proposed Right Side Elevation.						


- Notes
- 1- All work is to be carried out the requirements, to the satisfaction of the Local Authorities. These drawings are for planing purposes only.
 - 2- Responsibility is not accepted for errors made by others in scaling from this drawing. All construction information should be cross checked on the site.
 - 3- All discrepancies and change of design requests by authorities should be reported to surveyor immediately.
 - 4- All drawings to be read in conjunction with the project specification with all works carried out in accordance with the latest British Standards and codes of practice. Planning drawings are not to be used for the purpose of building & installation regulations.
 - 5-It is assumed that all works will be carried out by a competent contractor working, where appropriate, to an approved method statement.
 - 6-It is contractor's responsibility to notify the Building Control and get approval before any work commences.
 - 7- It is contractors responsibility to determine if any wall is load-bearing.
 - 8-Dimensions are based on information provided and existing records.
 - 9-All dimensions are in millimeters.
 - 10-The copyright of this drawing belongs to Se & Se Consultancy Ltd.

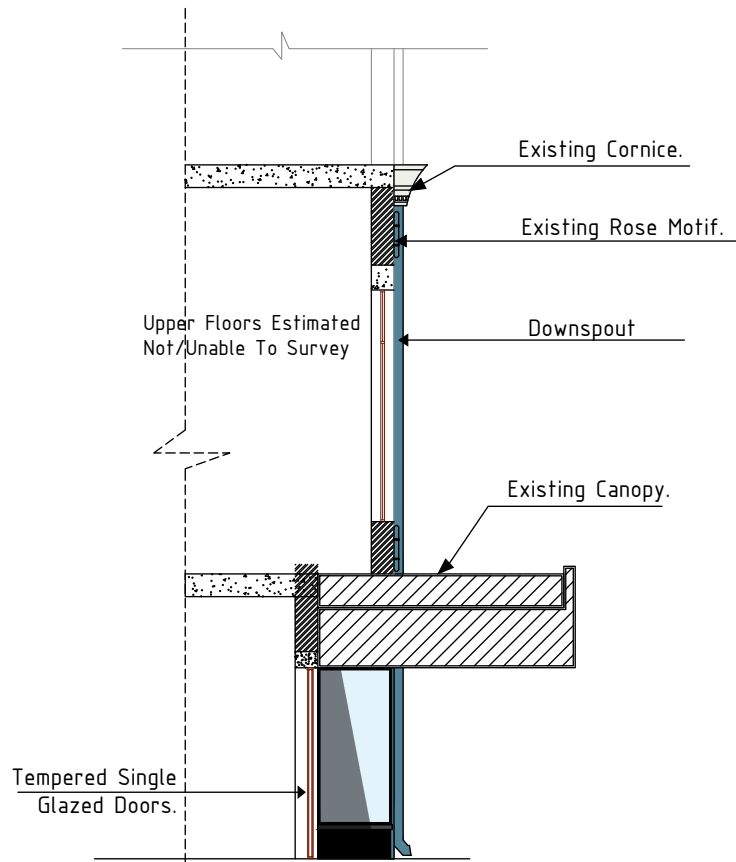


Pre-Existing Section X-X
(through Door)

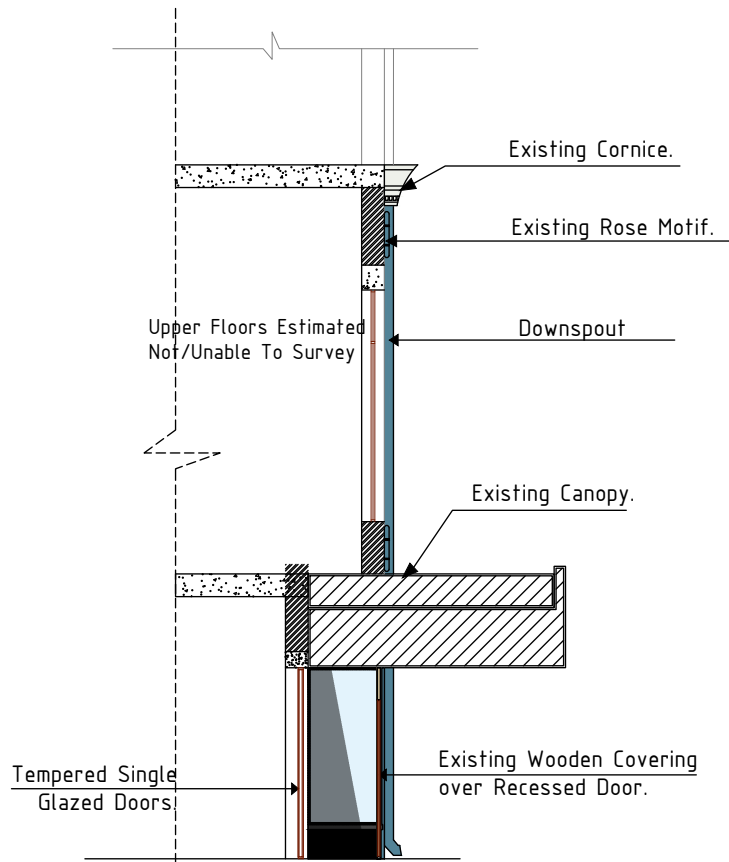


Existing Section X-X
(through Door)

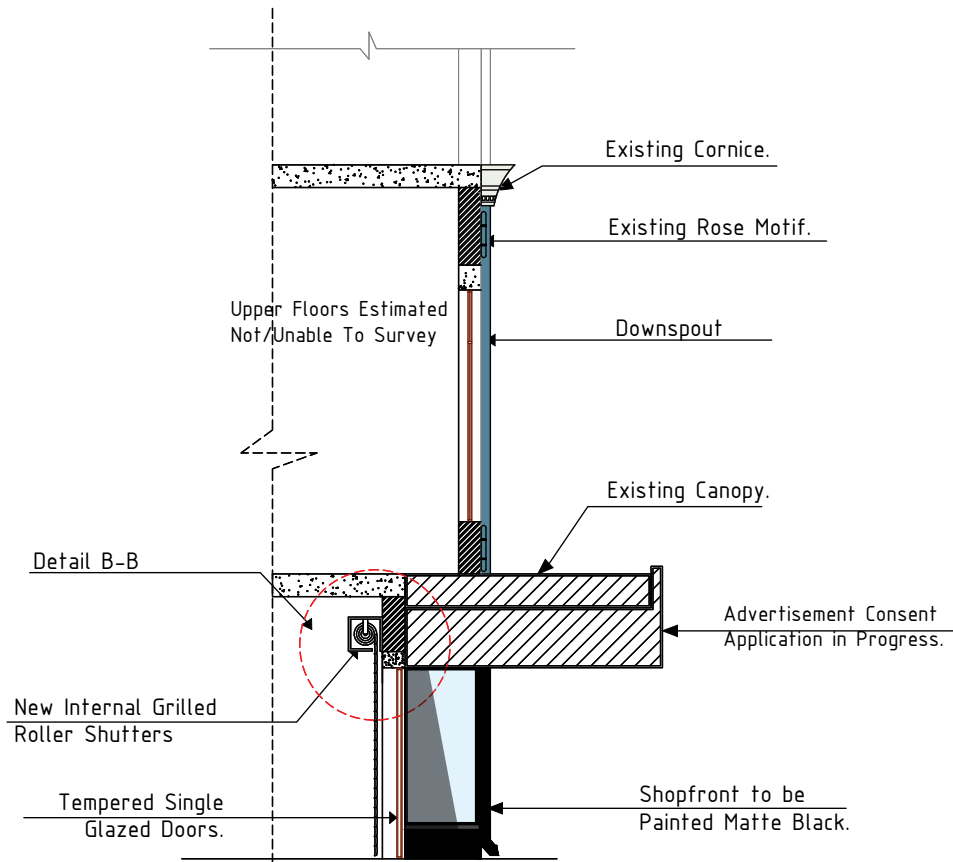


Proposed Section X-X
(through Door)

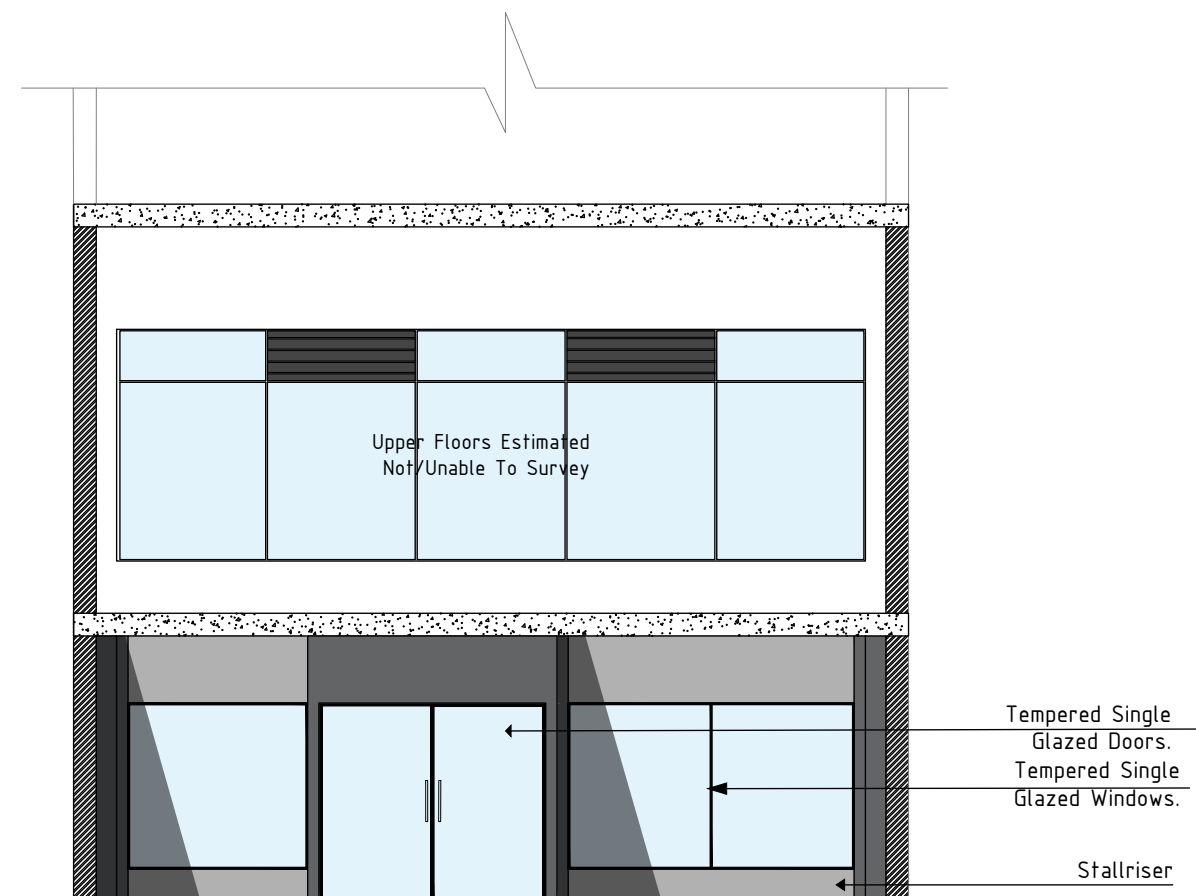


Pre-Existing Section Y-Y

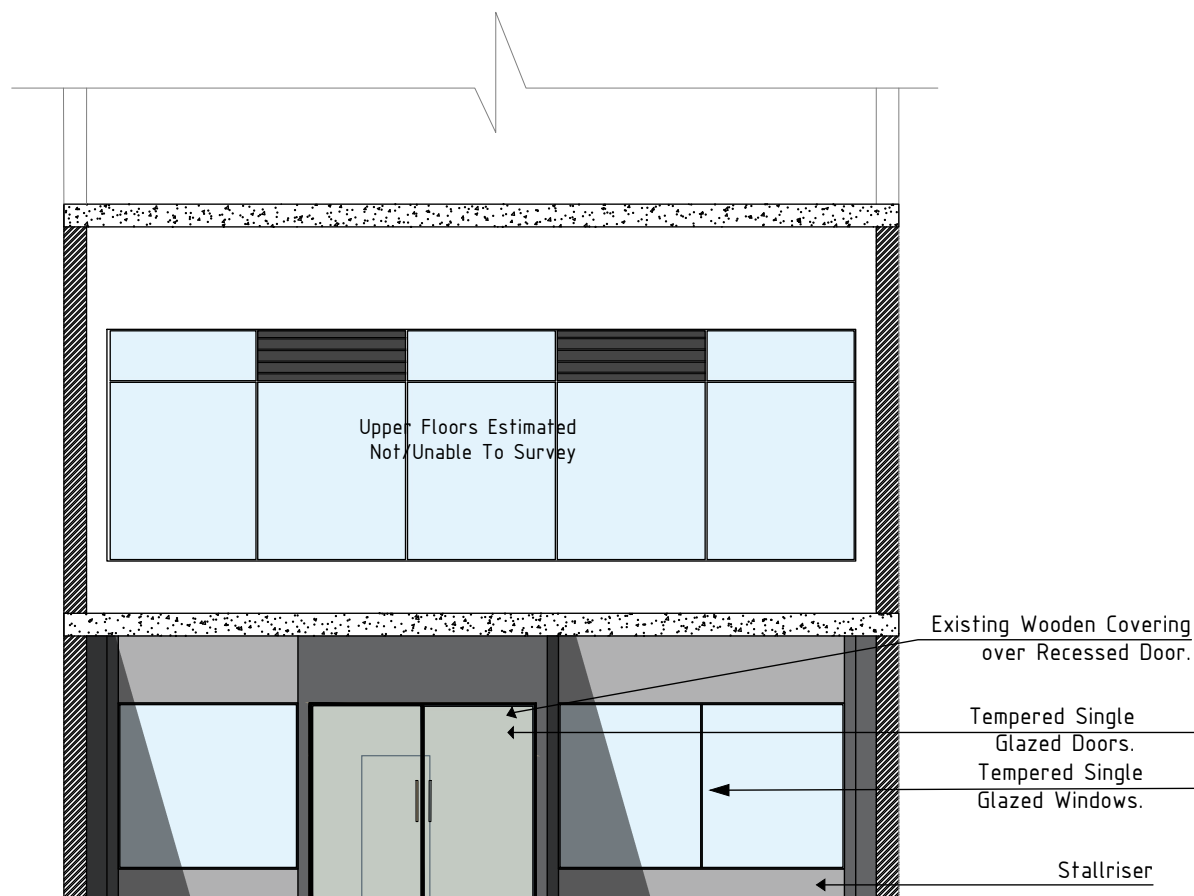

Existing Section Y-Y

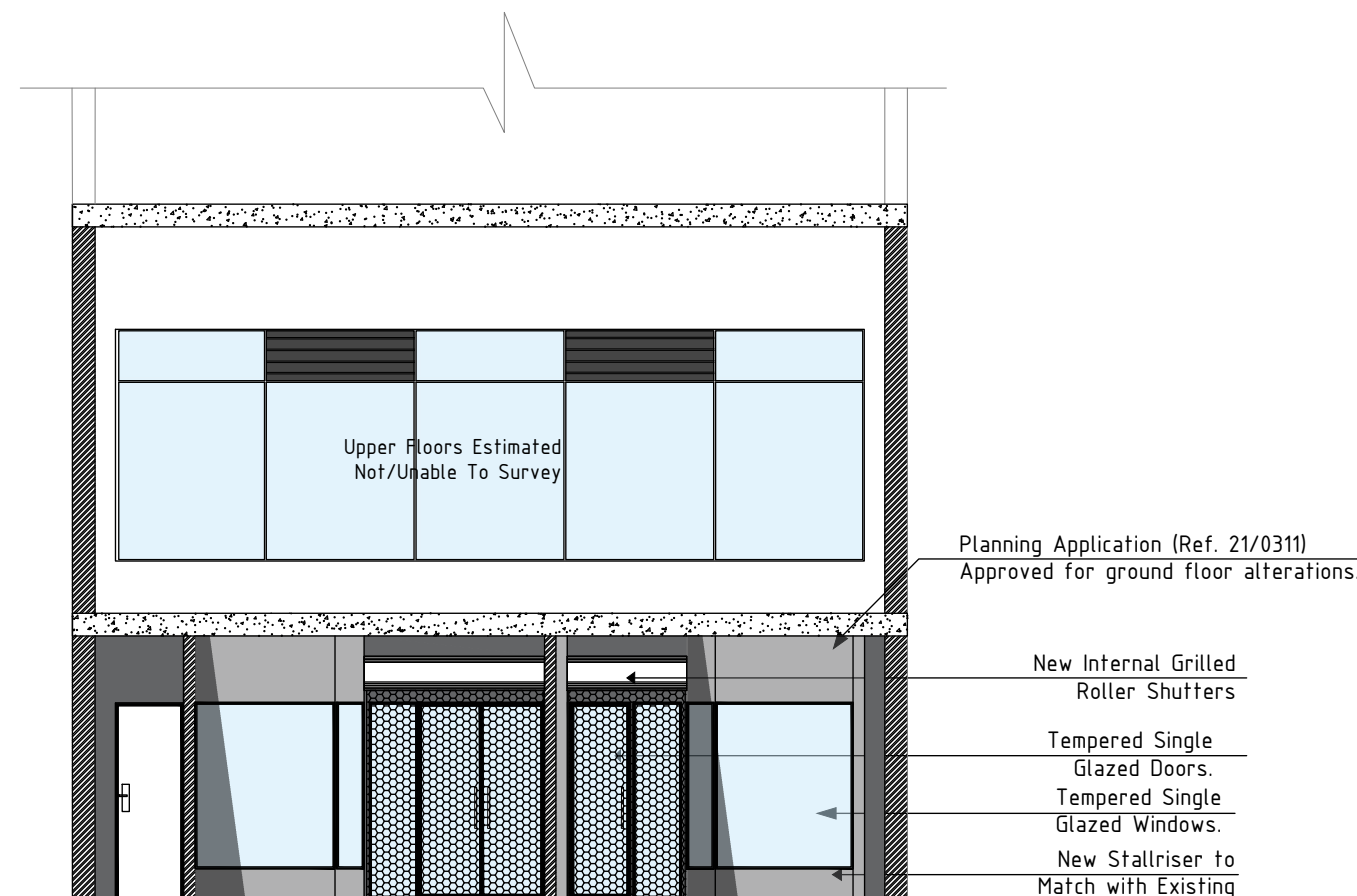

Proposed Section Y-Y


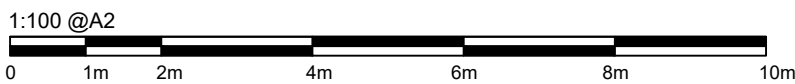


Address	165 Commercial Street, Newport, NP20 1JN.
Sheet	7/8
Reference	165CS-0610-PE/E/PS

Name	Pre-Existing, Existing & Proposed Sections
------	--

Rev	V3	Date	06/10/2025	Drawn By	MDF
				Checked By	SS

Notes
1- All work is to be carried out the requirements, to the satisfaction of the Local Authorities. These drawings are for planing purposes only.
2- Responsibility is not accepted for errors made by others in scaling from this drawing. All construction information should be cross checked on the site.
3- All discrepancies and change of design requests by authorities should be reported to surveyor immediately.
4- All drawings to be read in conjunction with the project specification with all works carried out in accordance with the latest British Standards and codes of practice. Planning drawings are not to be used for the purpose of building & installation regulations.
5-It is assumed that all works will be carried out by a competent contractor working, where appropriate, to an approved method statement.
6-It is contractor's responsibility to notify the Building Control and get approval before any work commences.
7- It is contractors responsibility to determine if any wall is load-bearing.
8-Dimensions are based on information provided and existing records.
9-All dimensions are in millimeters.
10-The copyright of this drawing belongs to Se & Se Consultancy Ltd.

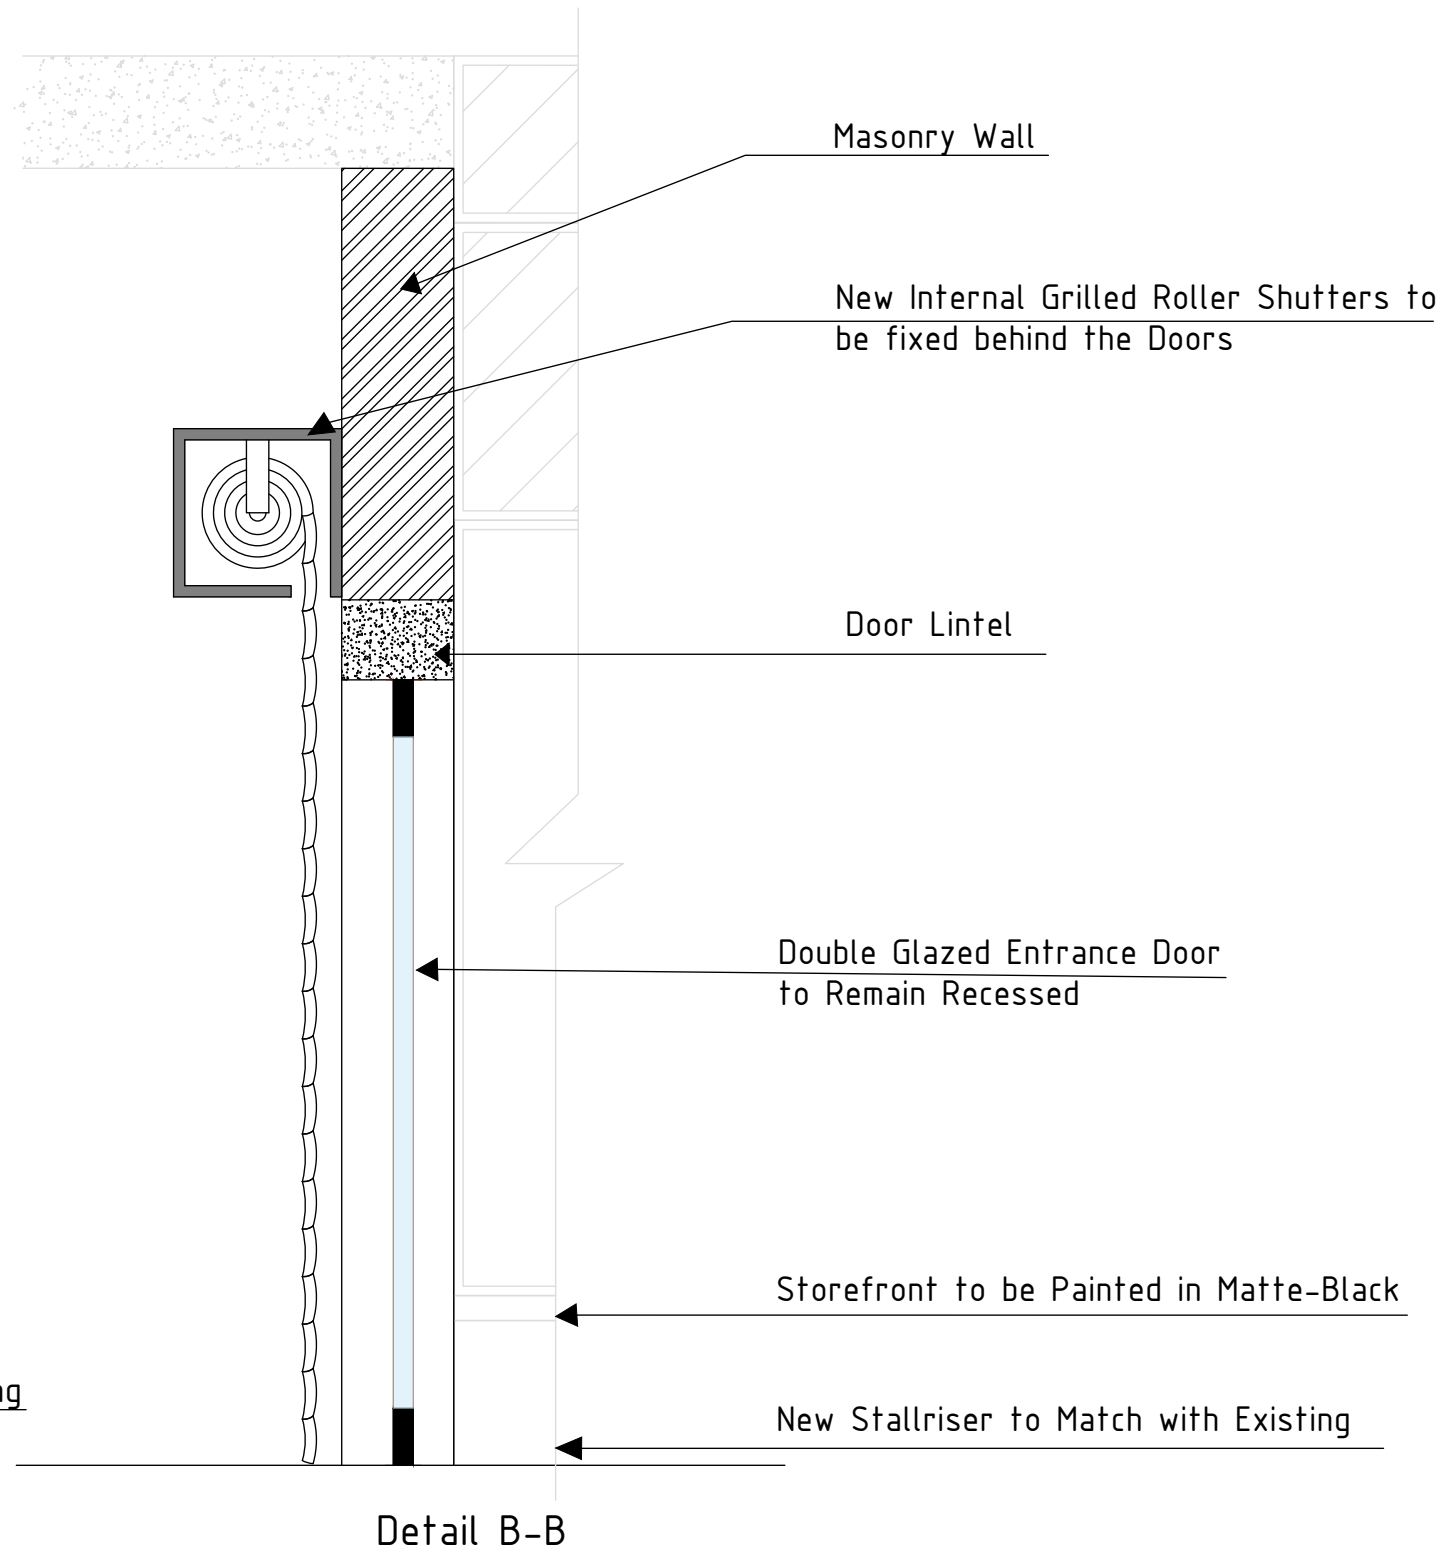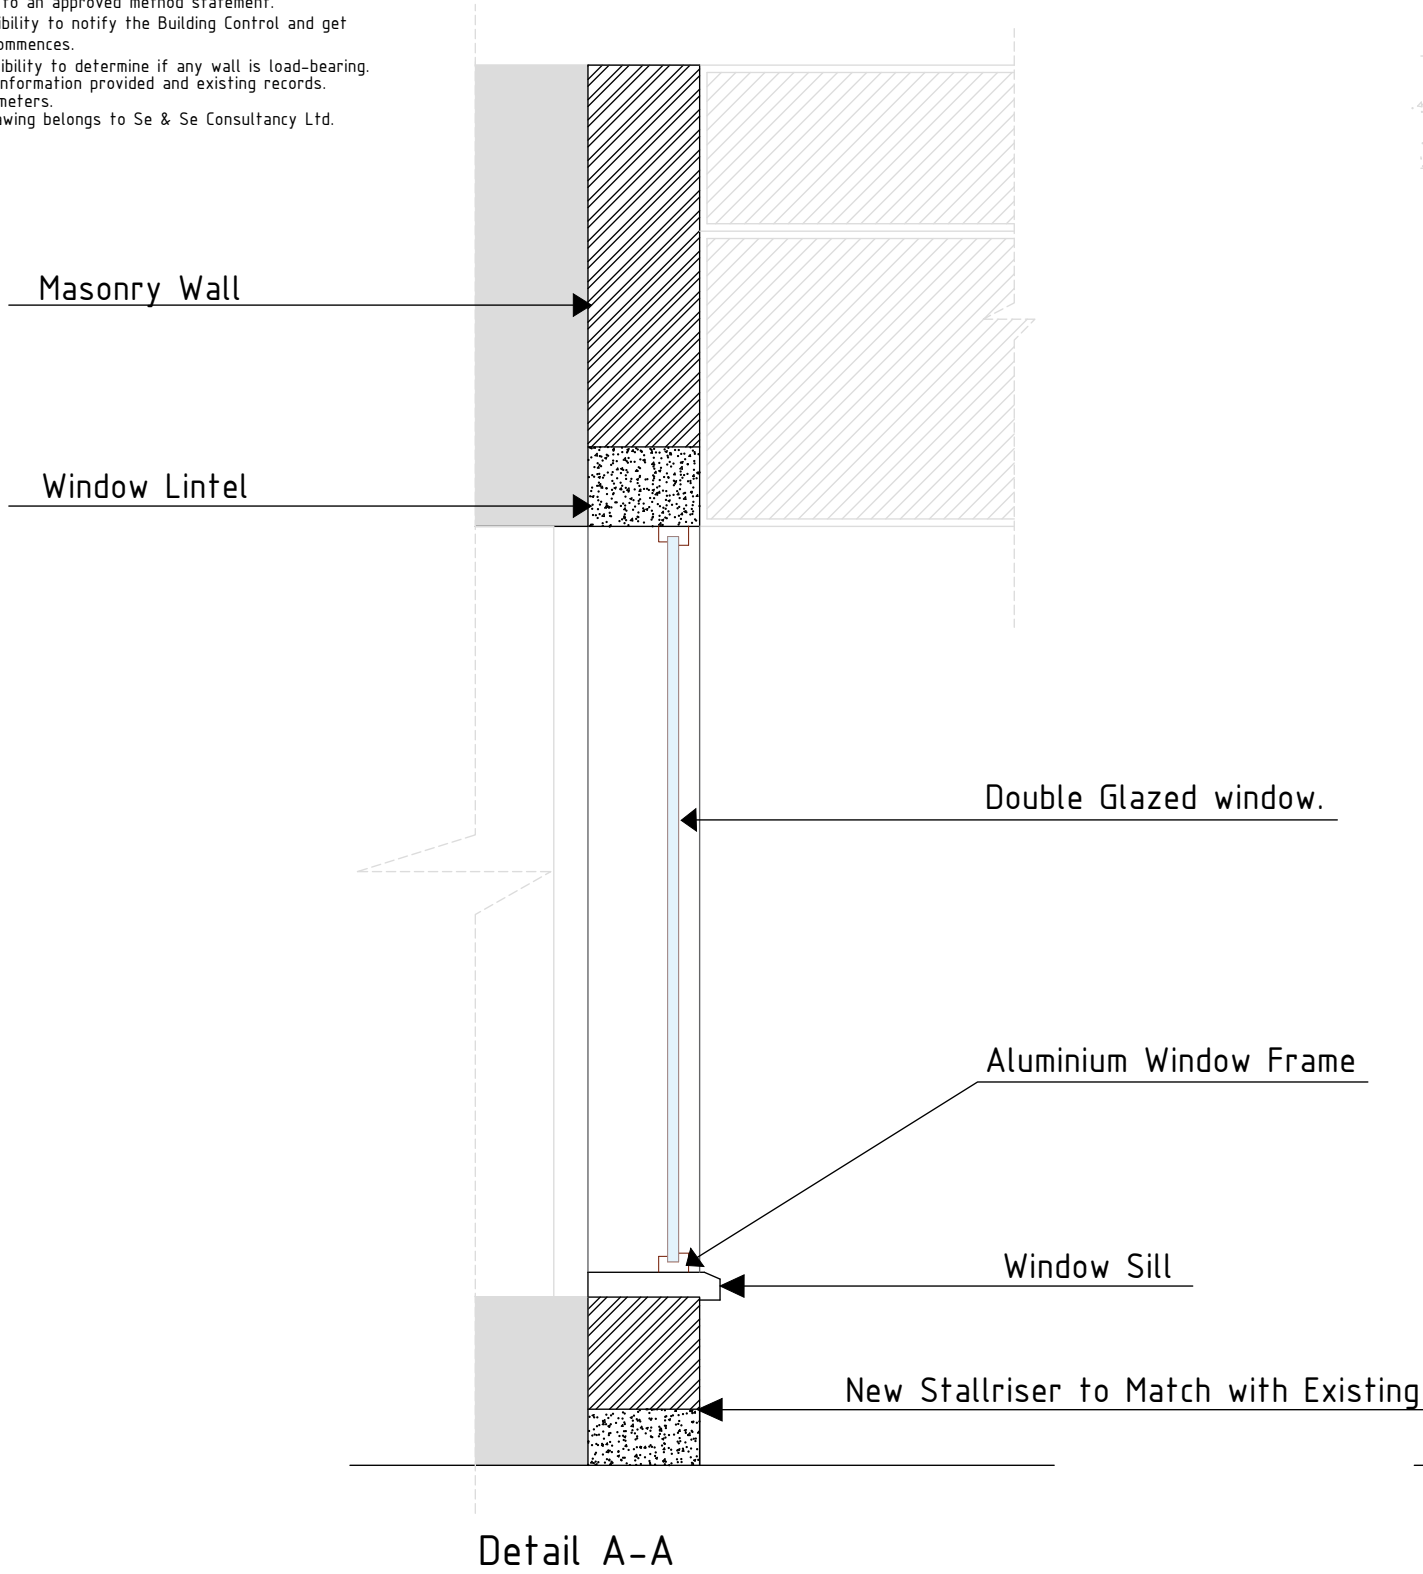

Address	165 Commercial Street, Newport, NP20 1JN.
Sheet	8/8
Reference	165CS-0610-PD.

Name	Proposed Details.
------	-------------------

Drawn By	MDF
Checked By	SS

Date	06/10/2025
------	------------

Rev	V3
-----	----