





Pre-development Side (South) Elevation

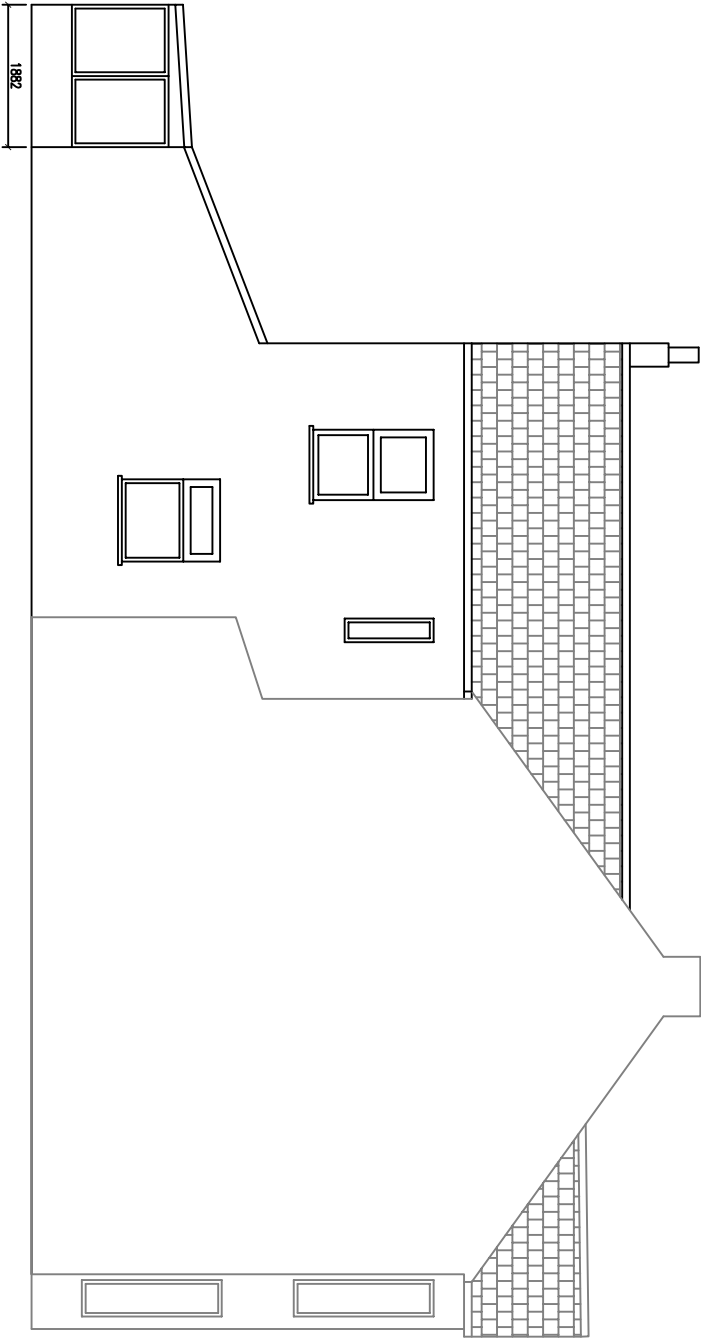

Pre-development Rear (West) Elevation

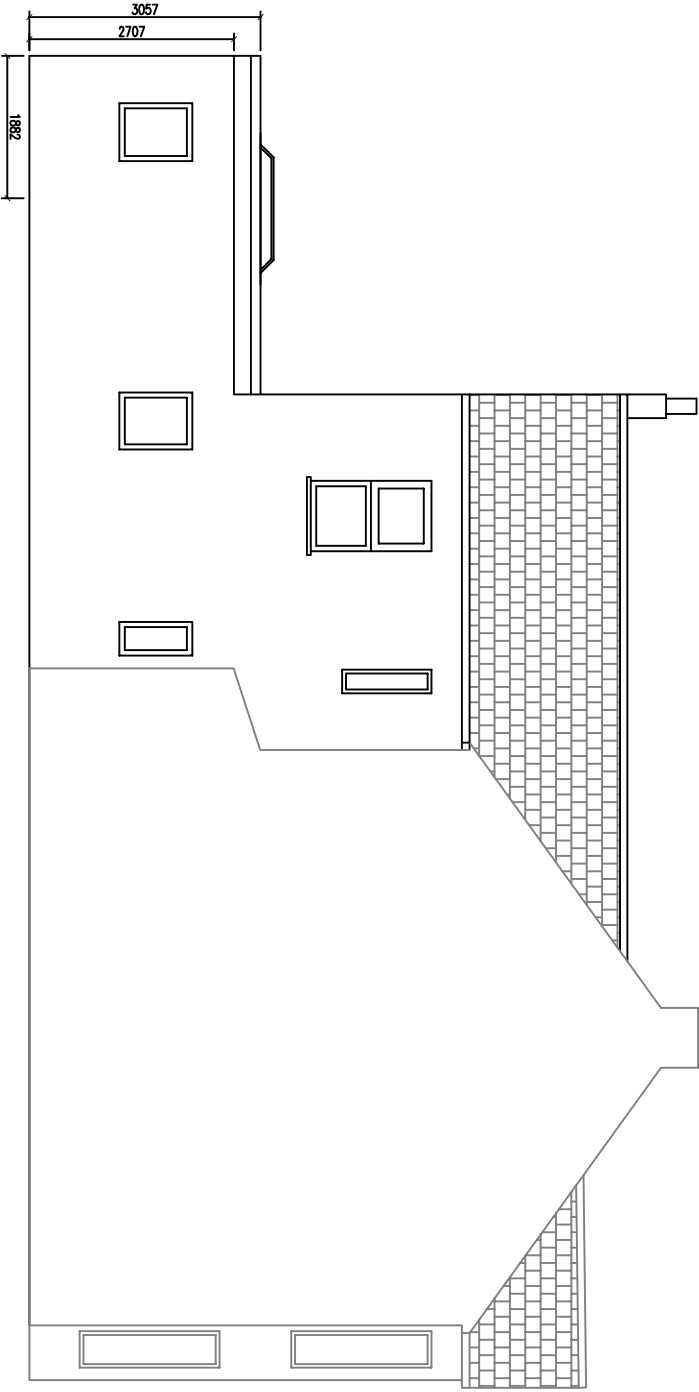

As-built Side (South) Elevation



As-built Rear (West) Elevation

| PROJECT                                                  |  | DRAWING    |  | DATE       |  | DRAWING NO. |  | NOTES                                                                                                                                                                                                              |  | REVISION DETAILS |  | MTRH Drafting Services                                                                                                                           |  |
|----------------------------------------------------------|--|------------|--|------------|--|-------------|--|--------------------------------------------------------------------------------------------------------------------------------------------------------------------------------------------------------------------|--|------------------|--|--------------------------------------------------------------------------------------------------------------------------------------------------|--|
| Bilyana Fiteva<br>36 Windsor Road<br>Newport<br>NP19 8NS |  | Elevations |  | 28.11.2025 |  | EL001       |  | 1. All dimensions to be checked on site.<br>2. All discrepancies to be reported back to MTRH Drafting Services.<br>3. This drawing is part of the Planning package, and should only be used for Planning purposes. |  | DATE             |  | 22a, Falbrook Avenue,<br>Kaindeer,<br>Newport<br>NP19 8FX<br>Tel: 07527971687<br>Email: mke@mtrhdrafting@outlook.com<br>Web: www.mtrhgroup.co.uk |  |
|                                                          |  |            |  | DRAWN BY   |  | SCALE       |  |                                                                                                                                                                                                                    |  |                  |  |                                                                                                                                                  |  |
|                                                          |  |            |  | MH         |  | 1:100       |  |                                                                                                                                                                                                                    |  |                  |  |                                                                                                                                                  |  |