


This 'As Built' drawing has been produced based on information provided by Norwest Holst Construction Ltd

DO NOT SCALE

ATKINS

River Usk (Afon Wysg)

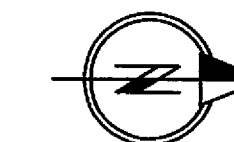

- Key**
- Existing Trees to be Retained
 - Proposed Grass Areas
 - Proposed Native Wildflower Meadow
 - Proposed Safety Surface Grass Matting
 - Proposed Shrub Planting
 - Proposed Woodland Planting Mix
 - Proposed Tree Planting
 - Proposed Native Hedge

AS BUILT ISSUE

Amendments to as built conditions: Fencing to main entrance amended, playground markings moved from nursery to infant play area, litter bins removed, gas intake enclosure added

Proposed location for flagpole indicated. Cycle parking arrangement updated to accommodate covered shelter. Location of equipment store adjusted to suit levels. Location of equipment store adjusted to suit levels. Location of shelter adjusted to suit gate locations. Bridge Street entrance proposals updated as per Authority request.

Grasscover matting added to coloured pencils and toolstoys within grassed areas. Log circle reduced to 3m diameter as per school's request. 1 No. log planter omitted as per Authority instruction. Indicative school signage locations identified as per Authority request. MEWP access route to school added.


White lining and signage added to public car park as per Authority request. Designated delivery bay created as per ACN 08 041. Rubberised play surface area revised as per Authority request. 2 No. optional locations for raised planters identified for Authority selection.

Amendments to Authority Change Notices: Froststranding shelters to main entrance and southeast school access omitted. Trees planted in front of school relocated to Village Green. Area for infants garden indicated. Reconstituted stone benches relocated from Clubhouse to school grounds. Wildlife area arrangement revised to increased sport pitch levels. Location for log circle indicated and proposed orchard tree located to accommodate.

Drop kerb added to car park with kerb to prevent vehicle access to recreation ground. School car park intercom location added.

Location of sprinkler building adjusted to avoid building canopy. Outdoor classroom location indicated. Equipment store location indicated. White lining to bin store added. Pedestrian gate to resource centre omitted.

Rev.	Description	By	Date	CHK	Auth
H	AS BUILT		28/10/09		NR
G	CONSTRUCTION		28/09/09		MD
F	CONSTRUCTION		04/08/09		MD
E	PLANNING		29/05/09		NR
D	COMMENT & APPROVAL BY AUTHORITY		22/05/09		MD
C	COMMENT		15/05/09		NR
B	CONSTRUCTION		14/11/08		NR
A	CONSTRUCTION		06/08/08		NR

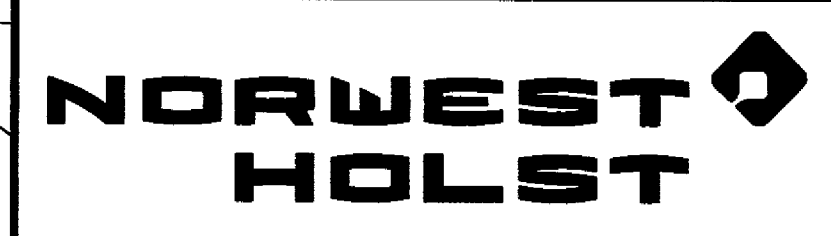


WS Atkins Consultants Limited
 Design, Environment & Engineering
 160 Aztec West, Almondsbury, Bristol, BS32 4TU.
 Tel. 01454 201400 / Fax. 01454 201568

Project
 Glebelands Development
 St Julians
 Newport

Title
 Glan Usk School
 AS BUILT
 General Arrangement

Original Scale	Drawn	Checked	Authorised
1:500	AHL	NR	NR
Date	10/01/08	Date	07/02/06
Date	07/02/06	Date	07/02/06
Drawing Number	5041855 / LA /	4900	Rev H

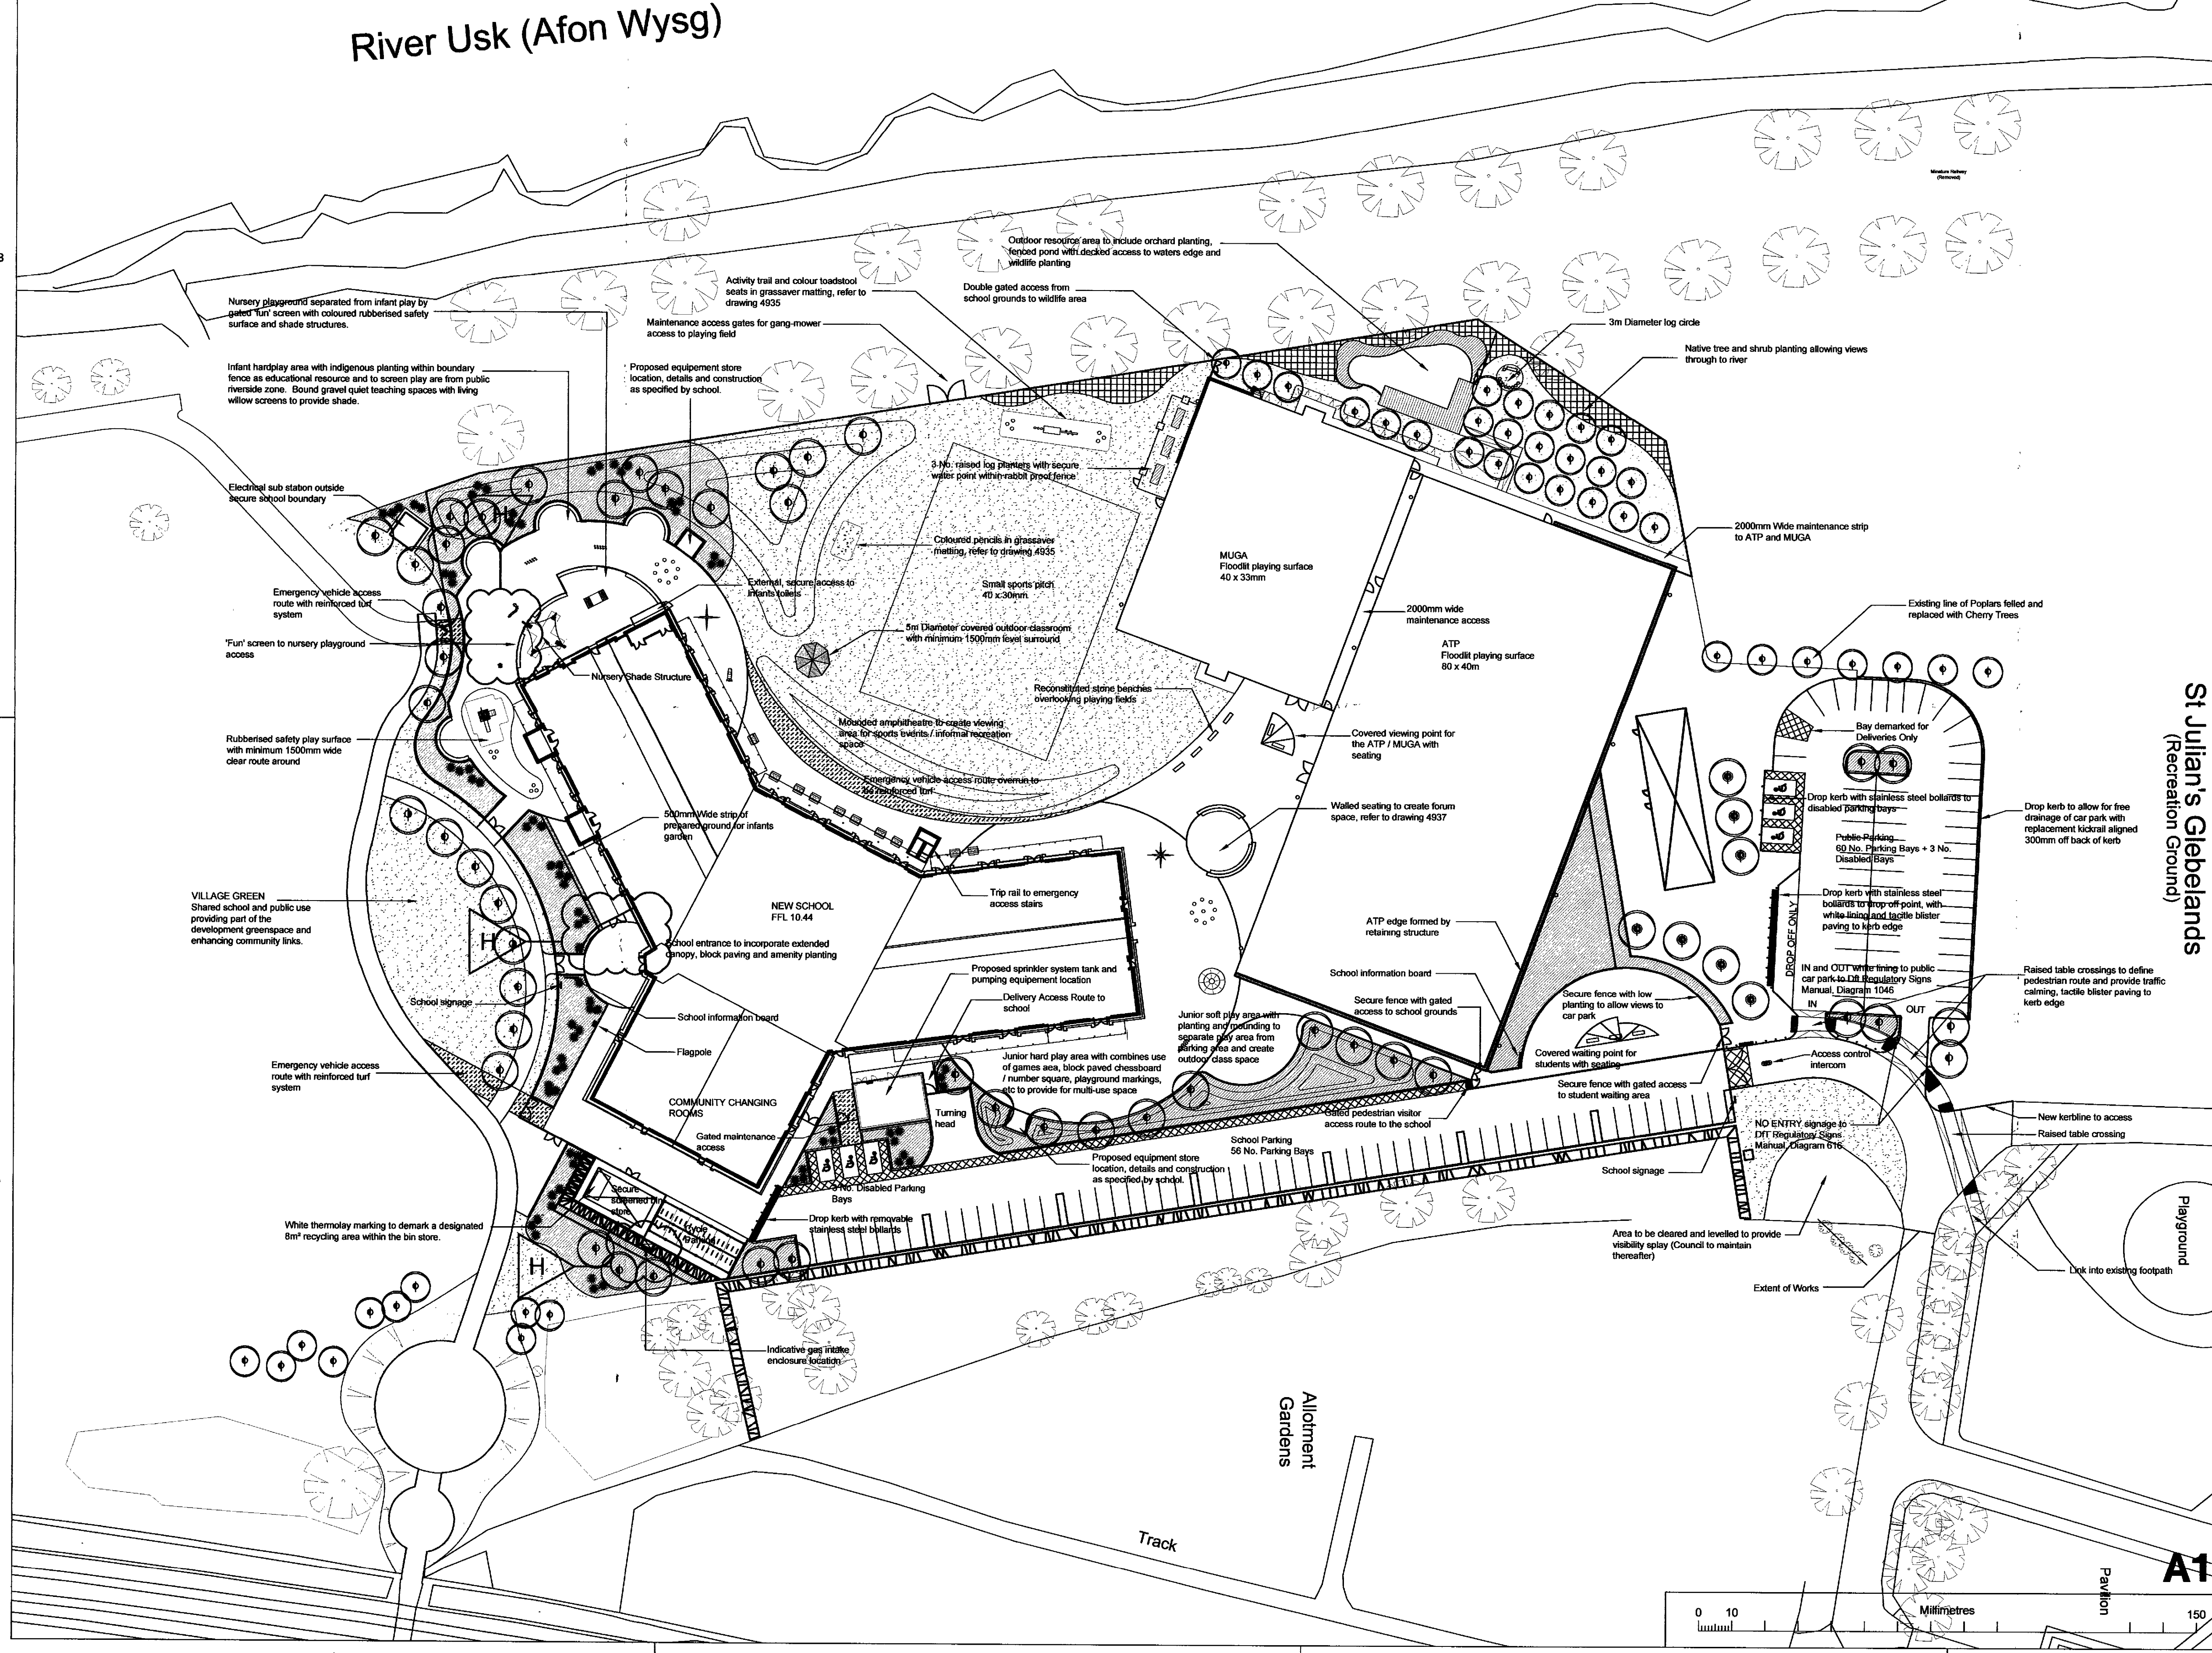

St Julians Glebelands
 (Recreation Ground)

Playground

PAVILION

