




This 'As Built' drawing has been produced based on information provided by Norwest Holst Construction Ltd

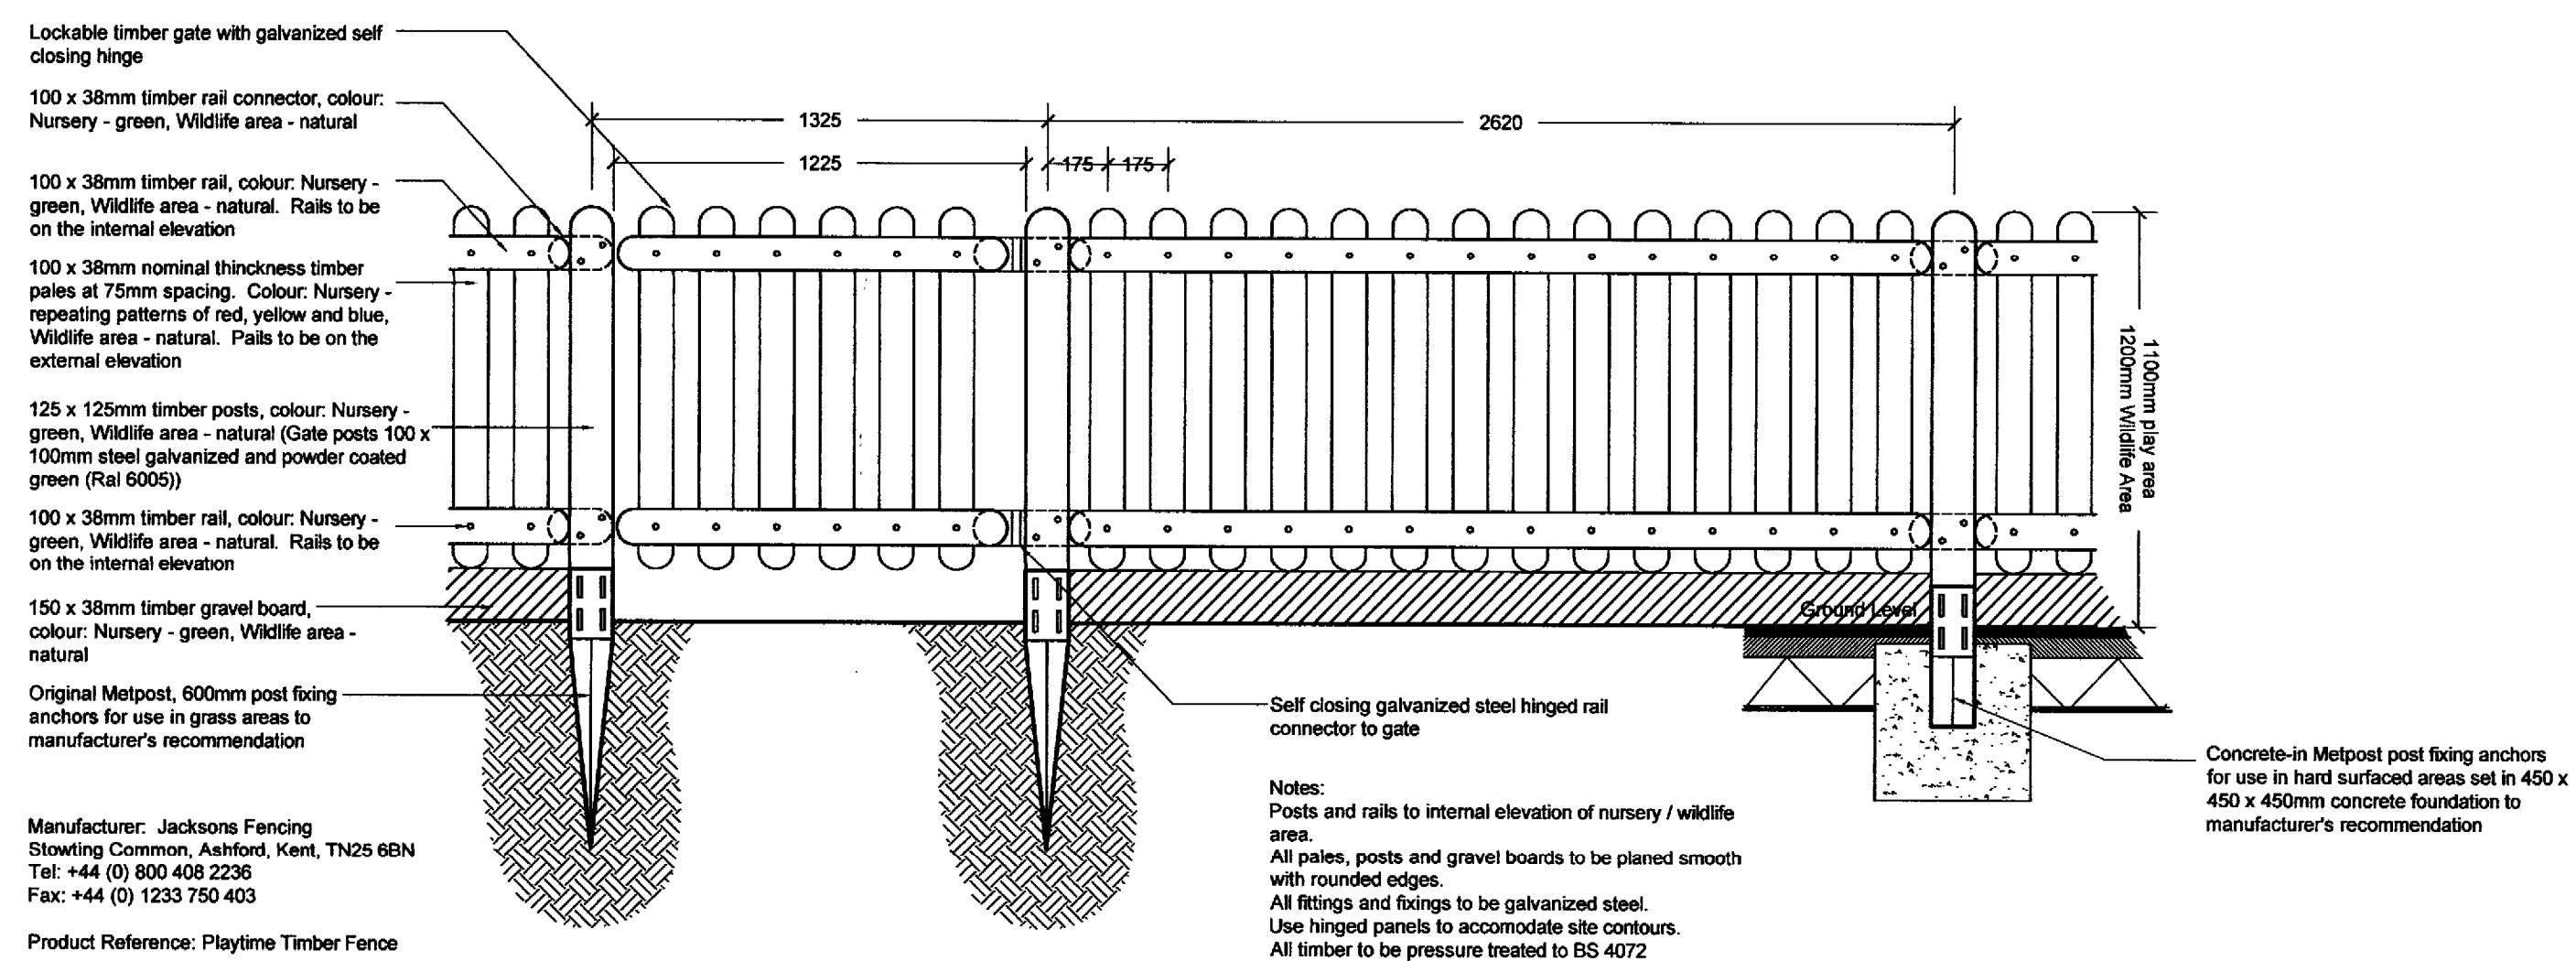

DETAIL 1
TIMBER FENCE AND GATE TO NURSERY PLAYGROUND AND WILDLIFE AREA (Internal Elevation)
Scale 1:20

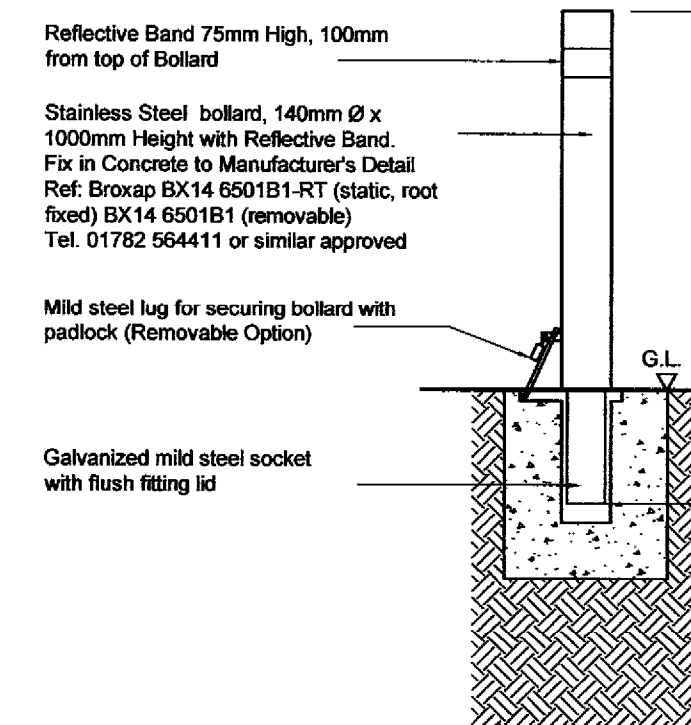


DETAIL 2
STAINLESS STEEL BOLLARD
SCALE 1:20

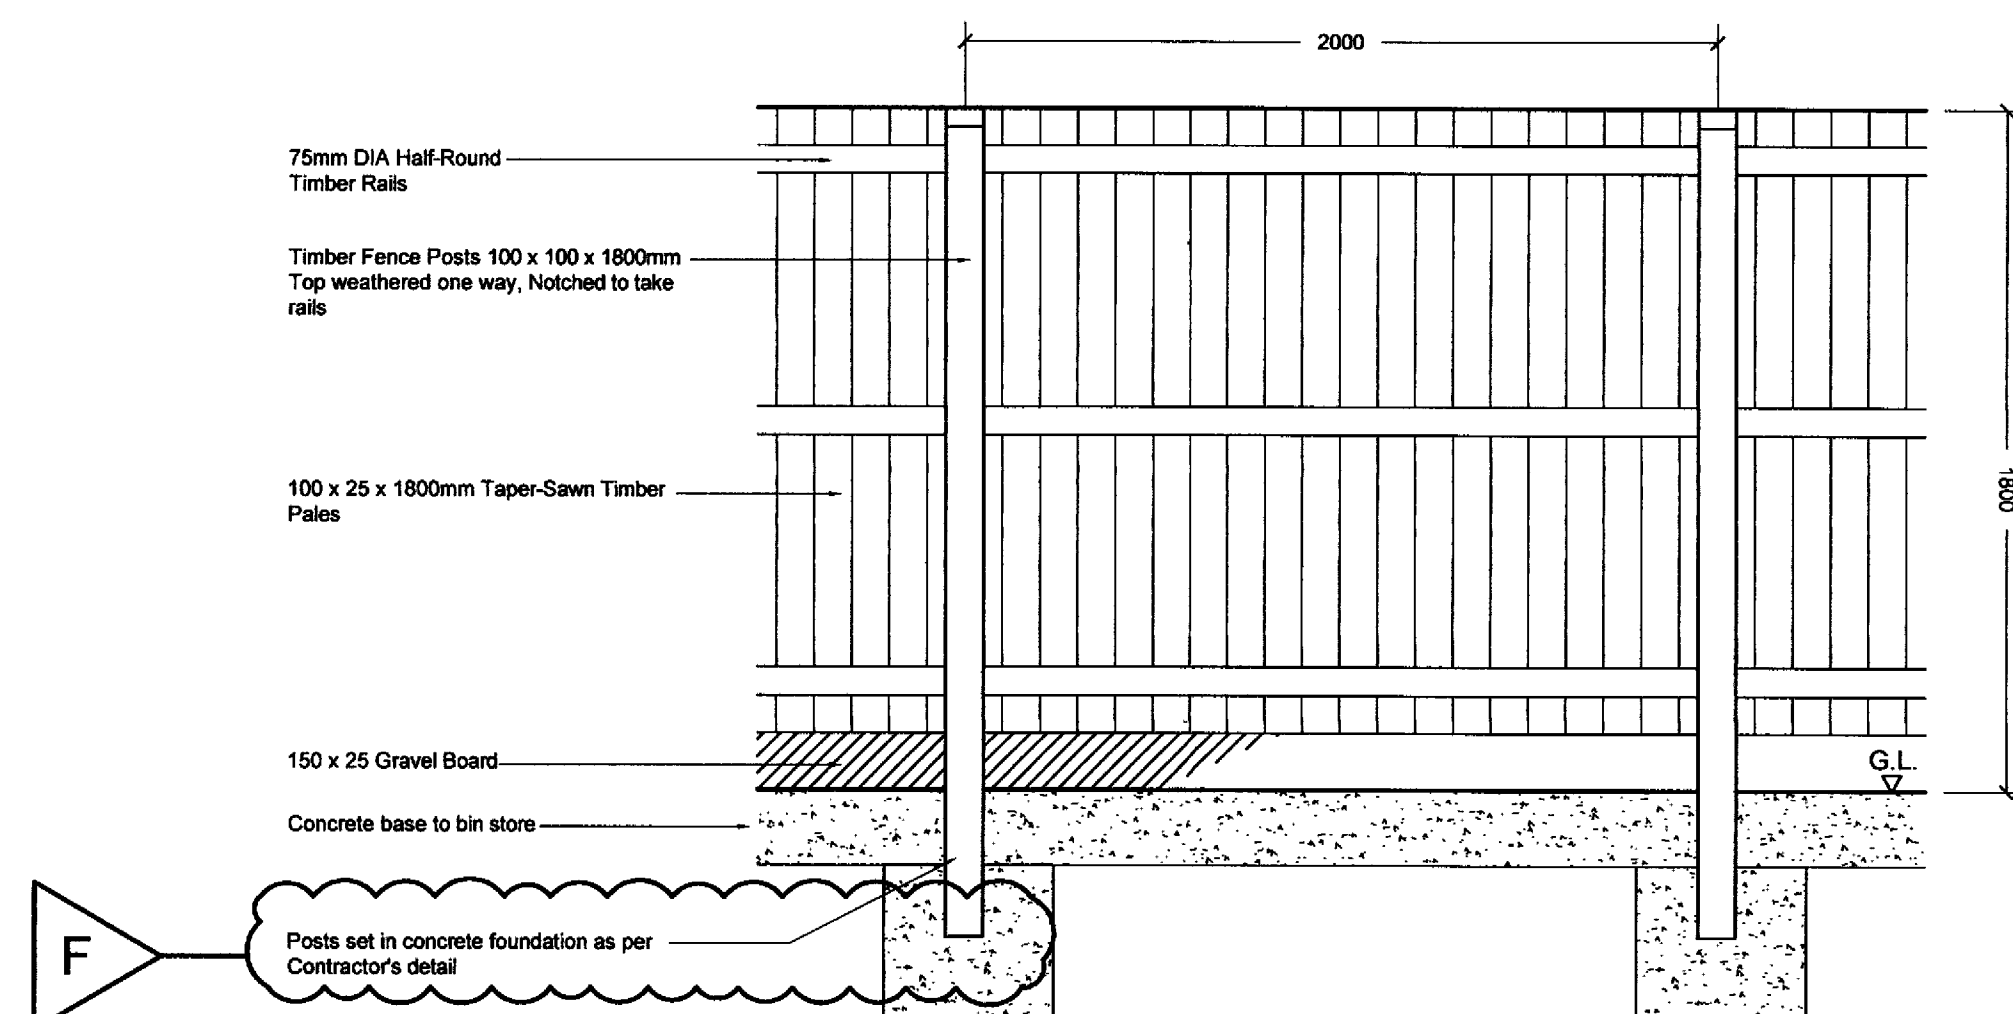

NOTE:
Posts and rails to internal elevation of bin store.
All timber to be stained to match adjacent covered cycle store -refer to manufacturer's details

DETAIL 3
CLOSEBOARDED FENCE ENCLOSURE TO BIN STORE (Internal Elevation)
Scale 1:20

DETAIL 4
OMITTED

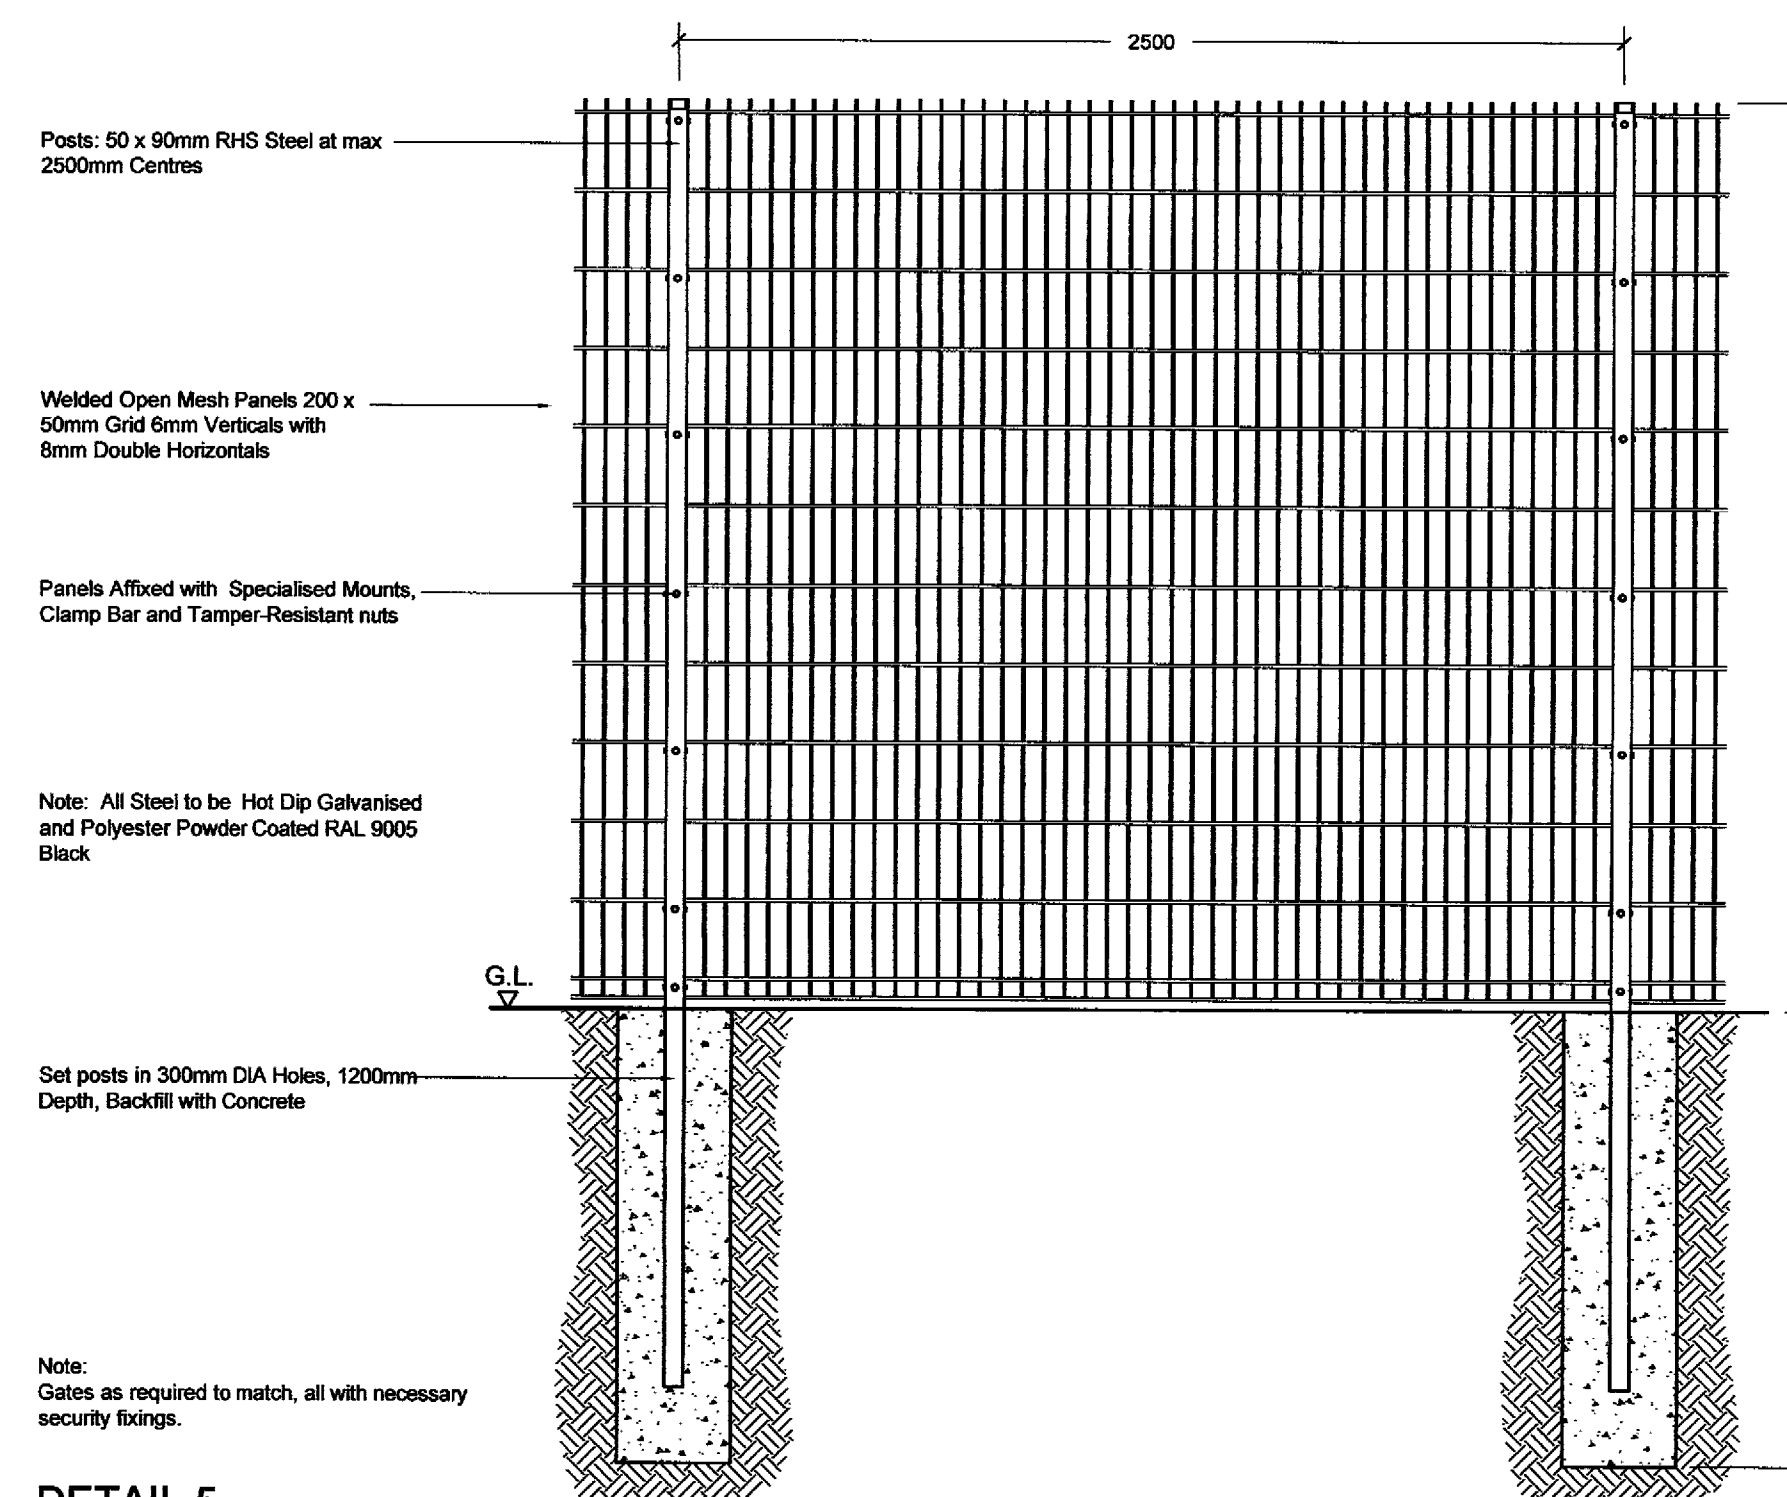

DETAIL 5
SECURE SITE BOUNDARY WELD MESH FENCING
SCALE 1:20

DO NOT SCALE

ATKINS

AS BUILT ISSUE	AL	28/10/09	NR	NR
Amendments to as built conditions: Timber fence to bin store posts set in concrete (melpost fixings omitted)				
Timber fence to bin store to be stained to match cycle shelter note added.	AL	28/08/09	MD	MD
Detail 3, close boarded fence reincluded for use to the bin store enclosure	AL	04/08/09	MD	MD
Melpost fixing anchor added to timber fence, bollard product reference updated	AL	15/14/09	MD	MD
Rev.	Description	By	Date	CHKD
F	AS BUILT		28/10/09	NR
E	CONSTRUCTION		28/08/09	MD
D	CONSTRUCTION		04/08/09	MD
C	PLANNING		29/05/09	NR
B	CONSTRUCTION		15/04/09	MD
A	CONSTRUCTION		08/09/08	VMM
Rev.	Purpose of issue	Date	Authorized	

VINCI

NORWEST
HOLST

WS Atkins Consultants Limited
Design, Environment & Engineering
160 Aztec West, Almondsbury, Bristol. BS32 4TU.
Tel. 01454 201400 / Fax. 01454 201568

Project
Glebelands Development
St Julians
Newport

Title
Glan Usk School
AS BUILT
Site Enclosure Details

Original Scale	Drawn	Checked	Authorised
Var.	AHL	NR	NR
Date	10/01/09	Date	07/02/09

Drawing Number
5041855 / LA / 4910

Rev
F

0 10 150
Millimetres