This 'As Built' drawing has been produced based on information provided by Norwest Holst Construction Ltd

DO NOT SCALE

ATKINS

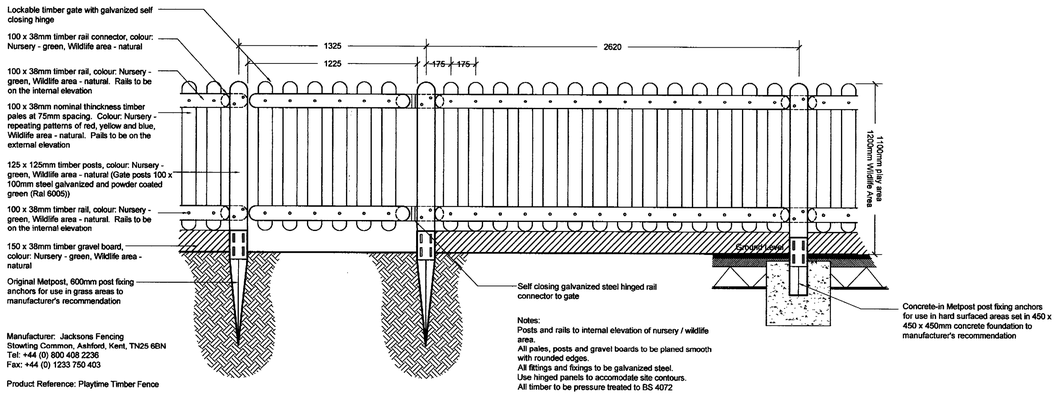

Manufacturer: Jacksons Fencing
Stowting Common, Ashford, Kent, TN25 6BN
Tel: +44 (0) 800 408 2236
Fax: +44 (0) 1233 750 403

Product Reference: Playtime Timber Fence

Notes:
Posts and rails to internal elevation of nursery / wildlife area.
All pales, posts and gravel boards to be planed smooth with rounded edges.
All fittings and fixings to be galvanized steel.
Use hinged panels to accomodate site contours.
All timber to be pressure treated to BS 4072

DETAIL 1
TIMBER FENCE AND GATE TO NURSERY PLAYGROUND AND WILDLIFE AREA (Internal Elevation)
Scale 1:20

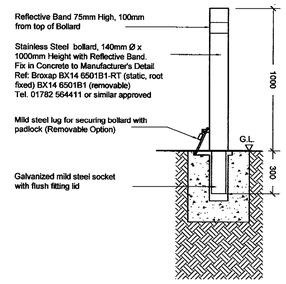

DETAIL 2
STAINLESS STEEL BOLLARD
SCALE 1:20

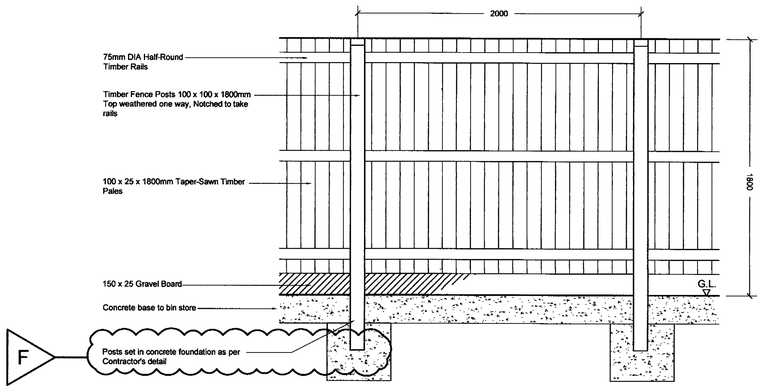

NOTE:
Posts and rails to internal elevation of bin store.

All timber to be stained to match adjacent covered cycle store -refer to manufacturer's details

DETAIL 3
CLOSEBOARDED FENCE ENCLOSURE TO BIN STORE (Internal Elevation)

DETAIL 4
OMITTED

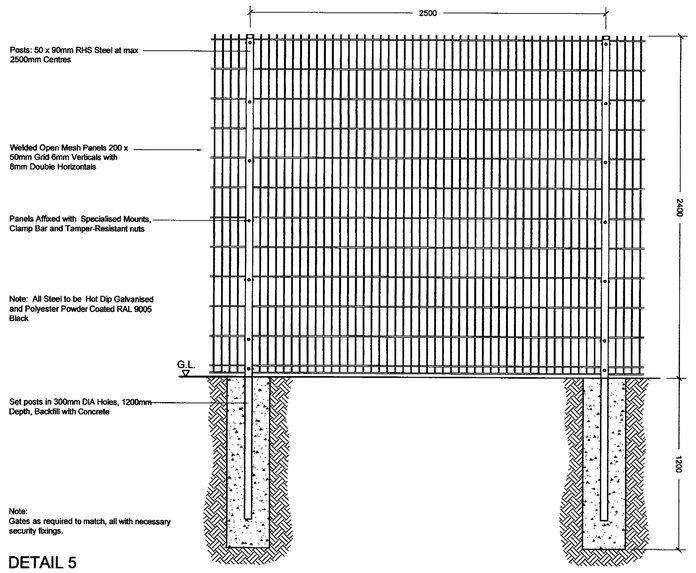

Note:
Gates as required to match, all with necessary security fixings.

DETAIL 5
SECURE SITE BOUNDARY WELD MESH FENCING
SCALE 1:20

Rev.	Description	By	Date	Ch'd	Auth
F	AS BUILT ISSUE Amendments to as built conditions: Timber fence to bin store posts set in concrete (metpost fixings omitted)	AL	28/10/09	NR	NR
E	Timber fence to bin store to be stained to match cycle shelter note added.	AL	28/08/09	MD	MD
D	Detail 3, close boarded fence reincluded for use to the bin store enclosure	AL	04/08/09	MD	MD
B	Metpost fixing anchor added to timber fence, bollard product reference updated	AL	15/14/09	MD	MD

Rev.	Purpose of issue	Date	Authorised
F	AS BUILT	28/10/09	NR
E	CONSTRUCTION	28/08/09	MD
D	CONSTRUCTION	04/08/09	MD
C	PLANNING	29/05/09	NR
B	CONSTRUCTION	15/04/09	MD
A	CONSTRUCTION	06/09/08	WM

VINCI

NORWEST HOLST

WS Atkins Consultants Limited ©
Design, Environment & Engineering
160 Aztec West, Almondsbury, Bristol. BS32 4TU.
Tel. 01454 201400 / Fax. 01454 201568

Project
Glebelands Development
St Julians
Newport

Title
Glan Usk School
AS BUILT
Site Enclosure Details

Original Scale	Drawn	Checked	Authorised
Var.	AHI.	NR	NR
	Date 10/01/06	Date 07/02/06	Date 07/02/06

A1

0 10 Millimetres 150

Drawing Number
5041855 / LA / 4910

Rev F