


| DESIGN STANDARDS CHECKLIST |    |                  |
|----------------------------|----|------------------|
| DESIGN STANDARDS           | NO | YES              |
| NDSS                       |    |                  |
| WDQR                       |    | AFFORDABLE ONLY. |
| M4(2)                      |    |                  |
| M4(3)                      |    |                  |




| This line should measure 70mm when printed correctly   |            |    |   |
|---|------------|----|---|
| This drawing is the copyright of Roberts Limbrick Ltd and should not be reproduced in whole or in part or used in any manner whatsoever without their written permission.                  |            |    |   |
| Responsibility is not accepted for errors made by others in scaling from this drawing. Use only figured dimensions and report any discrepancies or omissions to the Architect immediately. |            |    |   |
| Rev   | Date       | By | Chk. Description   |
| T01   | 23.12.2025 |    | First Issue   |
| T02   | 11.02.2026 |    | Updated to suit site plan,apartment block updated with additional unit, plots numbers and allocated parking amended to suit. |
| T03   | 08.07.2026 |    | Parking court boundary updates in line with planners comments.                                                               |
| T04   | 21.07.2026 |    | Garden gates shown in red legend updated in line with client comments.                                                       |

## BOUNDARIES PLAN


### Boundary Treatments

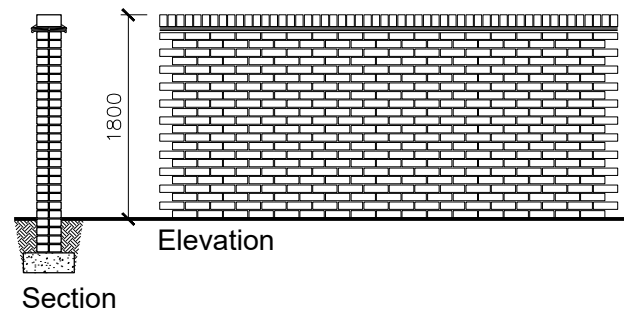


1800mm high Brick Wall. Brick Type to match adjacent houstypes.

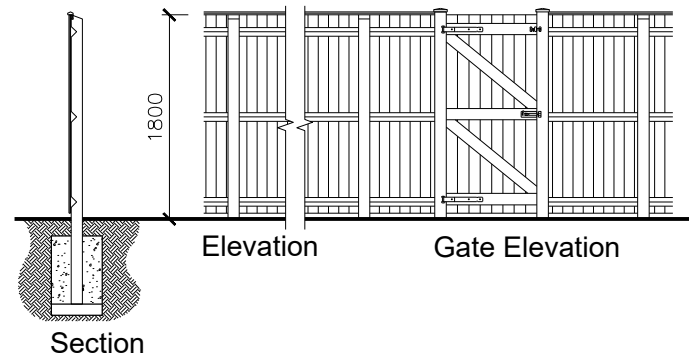


1800mm high Close Boarded Timber Fence with matching gates.

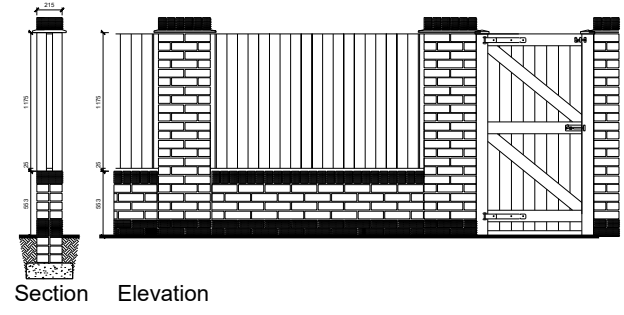


1800mm Dwarf wall Vertical lapped Fence & Piers With Gates.

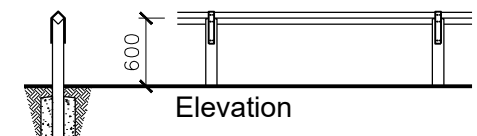

600mm high Timber Knee Rail.

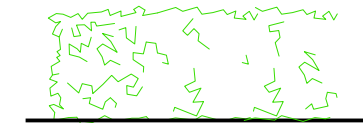

Hedge Treatment to Landscaper's Specification.

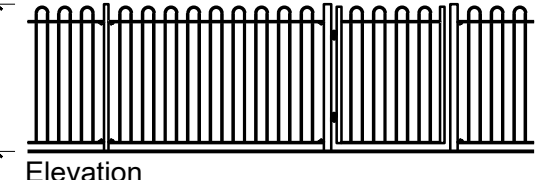


1300mm high Bow Topped Railing and Gate.

### Notes:

For all soft landscaping and front boundary treatments refer to Landscape Architects plans.

Hedgehog friendly gravel boards with a hole 130x130mm at the base of the close boarded fence to be used at intersections with other boundaries

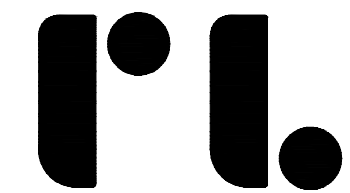

Roberts Limbrick

03333 405 500  
mail@robertslimbrick.com  
robertslimbrick.com

Registered Office: England No. 08958229

### Project Name

RESIDENTIAL DEVELOPMENT  
PHASES 4B & 5D  
GLAN LLYN, NEWPORT

### Client Name

MILLER HOMES

### Drawing Title

PROPOSED BOUNDARIES PLAN

### Scale

1:500 @ A1

### Project No.

9630

### Status

A4

### Purpose Of Issue

Issued for Tender

| Project | Org. | Vol. | Level | Form | Role |
|---------|------|------|-------|------|------|
| R9093   | RLA  | 25   | XX    | DR   | A    |

### Number

3202

### Revision

T04