EXISTING WATER METERS TO BE RETAINED. WELSH WATER TO TUN NEW 32mm MCWS TO THE BOUNDARY LINE.

WELSH WATER TO PROVIDE A 63mm PRIVATE FIRE MAINS TO THE SITE BOUNDARY.

3NO 150MM DUCT 1NO LV 2NO HV

CCT-13 ANPR CABLE TO TERMINATE TO A SEPARATE COLUMN CUT OUT WITHIN THE LIGHTING COLUMN.

CCT-10 INSTALLED ABOVE SINGLE GATE

LEFT TURN ONLY

NO ENTRY

LEFT ONLY


SERVICE VEHICLES ONLY


Existing trees to be retained in accordance with Landscape Consultants design and Tree Report

Retaining wall to be provided by Structural Engineer design


DEXTRA LIGHTING PROPOSAL REV A

		qty			
A		2	HBEX3 XL L102 C74	55.1W	OPUS 3
A/E		1	HBEX3 XL L102 C74 EMERGENCY	55.1W	OPUS 3
B		1	HBEX3 L L102 C74 AS	55.1W	OPUS 3
BE		4	HBEX3 L L102 C74 AS LE3 EMERGENCY	55.1W	OPUS 3
C		5	HBEX3 XL L350 C74	199.2W	OPUS 3
C/1E		3	OPU3XL L200 C74 LE3 c/w EMERG	108W	OPUS 3
D		5	HBEX OP36HO L150 S90 AS	85.1W	OPUS 360 HO
E		10	HBEX WP L15 AS LE3 EMERGENCY	10.8W	OPUS WALLPACK
F		7	HBEX OP36HO L300 S90 OA ON COLUMN	162.7W	OPUS 360 HO
GE		4	HBEX WP L25 LE3 AS	18.8W	OPUS WALLPACK
EX		3	AME2 M3 LE3 EMERG BULKHEAD c/w ELK LEGEND KIT		
L		8	TYP L80 PC SS		
LE		4	TYP L80 LE3 PC SS		

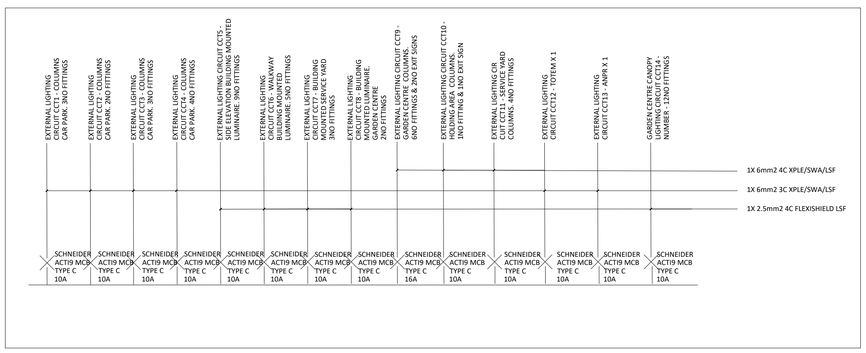


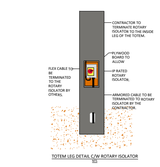


TOTEM LEG DETAIL C/W ROTARY ISOLATOR

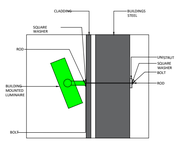

BUILDING MOUNTED LUMINAIRE FIXING

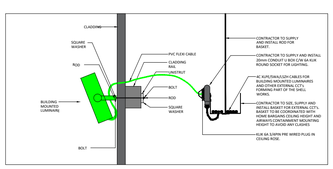

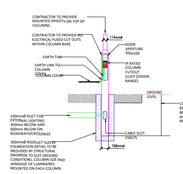

TYPICAL 8m LIGHTING COLUMN DETAIL C/W 24 LOCT CUTOUT FOR LUMINAIRE & AMPR CAMERA

BARKER
electrical UK Ltd.
INDUSTRIAL • COMMERCIAL • DOMESTIC
INSPECTION & TESTING

HOME BARGAINS
NEWPORT
NP20 2NS

TITLE: EXTERNAL LIGHTING & SERVICES
LAYOUT BE003
REVISION: AS BUILT
DATE: 22/01/2025
SCALE: NTS
DRAWN BY: PT
CHECKED BY: BB

LEGEND

- 100mm SERVICES DUCTING
- 100mm LIGHTING DUCTING
- 100mm ANPR DUCT
- 100mm TOTEM DUCT
- 100mm INTERCEPTOR DUCT
- 100mm LIGHTING BASKET
- EV DUCT SIZES AS ZEST NOTES & OTHER DRG'S
- PROPOSED ELECTRIC (hv)
- PROPOSED ELECTRIC (lv)
- PROPOSED WATER
- PROPOSED BT
- 600MM X 600 MM INSPECTION CHAMBER
- 1200MM X 1200 MM INSPECTION CHAMBER
- 8M COLUMN