
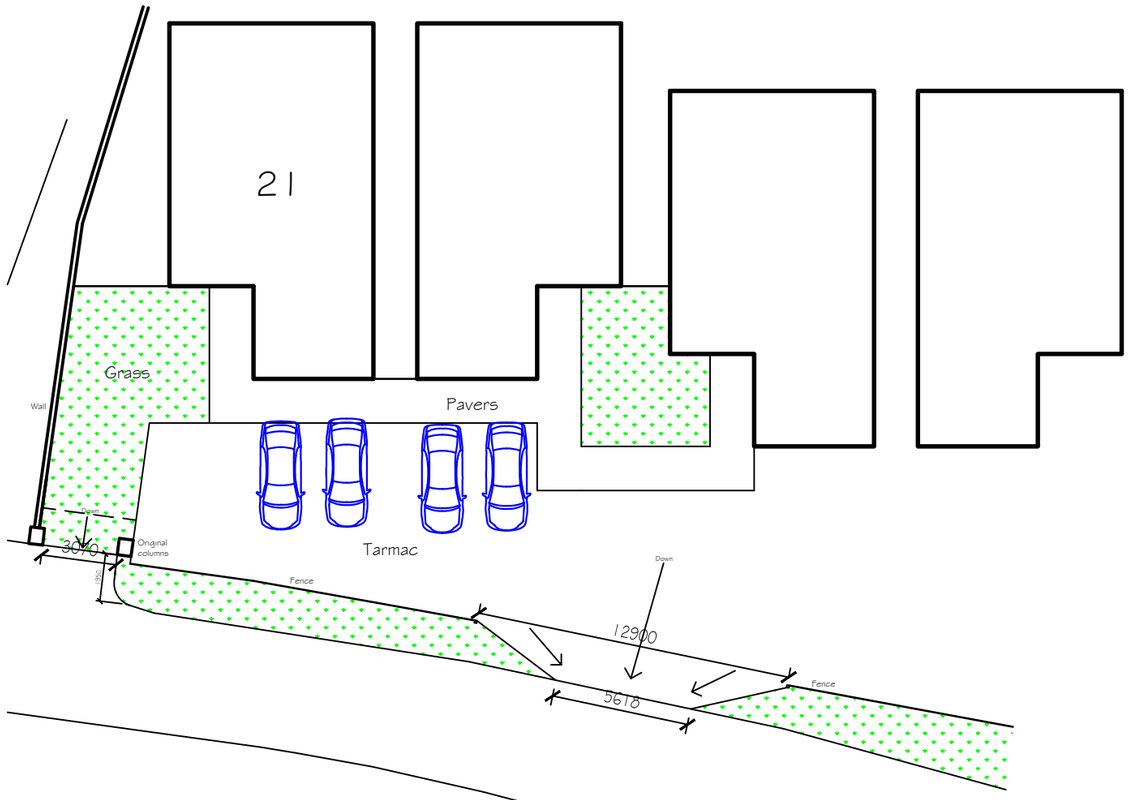


Original Plans

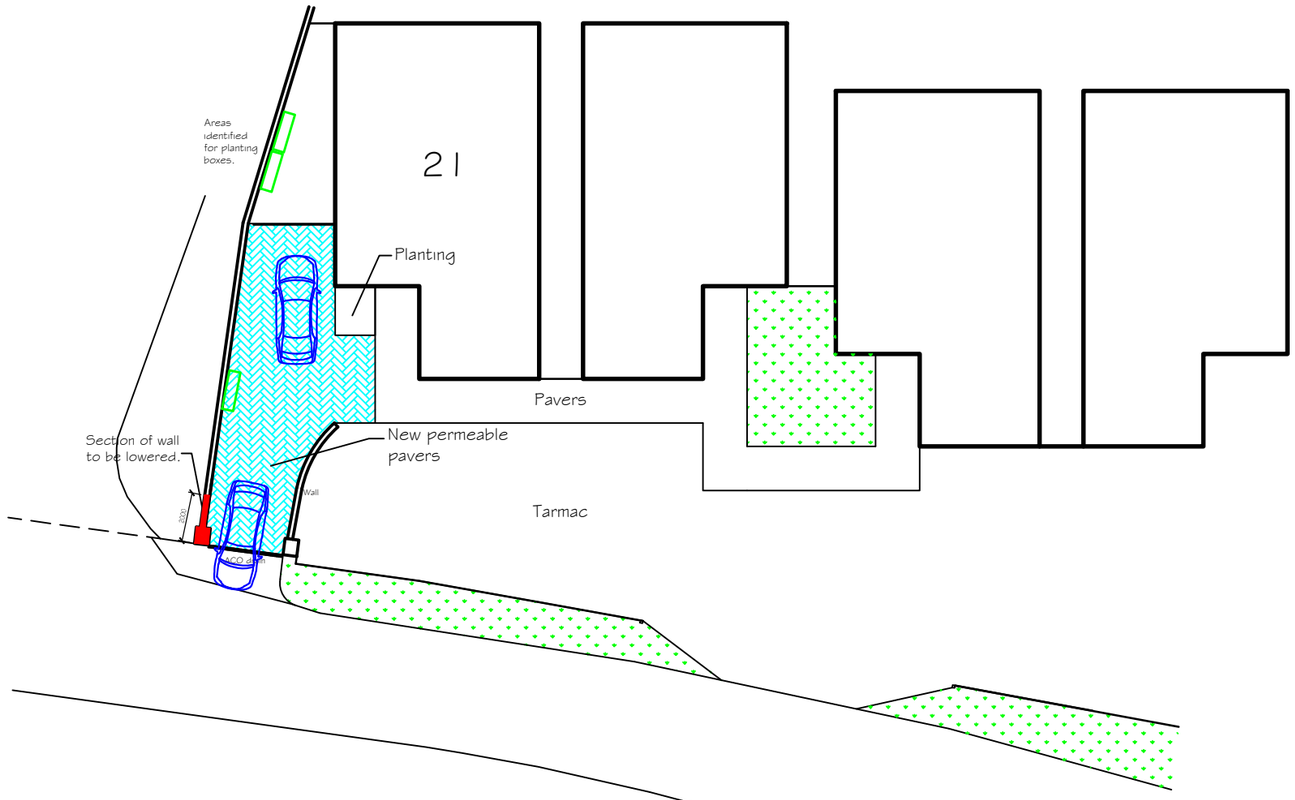

Proposed Plans
(as built except where noted)

© This drawing is copyright.

Palmer Architectural Services

21 St Mellons Road
Marshfields

EXISTING & PROPOSED PLANS

Scale:	Drwg No.
1.250@A3	21SMR/26/01B
Date: April 2026	

Revisions:
1.Proposed planting boxes moved from front to existing side boundary wall.

Drawings not to be scaled, use figured dimensions and levels only. Any inaccuracies should be notified to the architect.