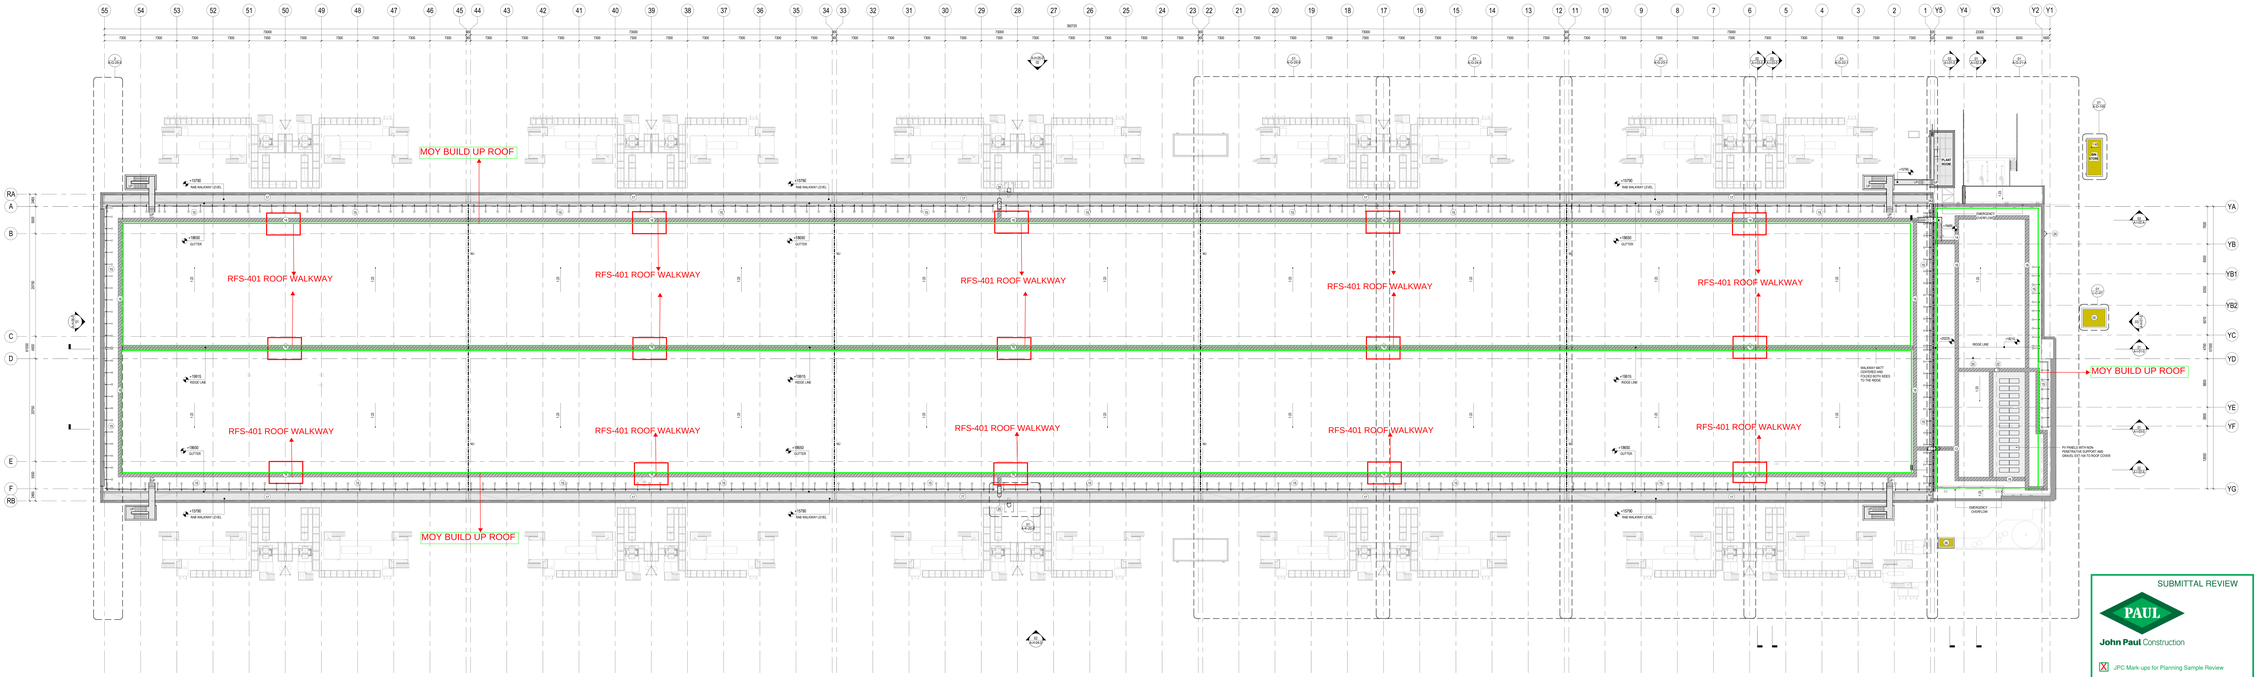

01 ROOF - GA PLAN

SCALE : 1 : 200

1m 4m 8m 12m 16m 20m

SUBMITTAL REVIEW

PAUL

John Paul Construction

[X] JPC Mark-ups for Planning Sample Review

Date :	Initial :	Project :
30/01/25	AS/ GVG	CWL01

SHEET NOTES

ALL VERTICAL DIMENSIONS ARE RELATIVE TO ASSOCIATED BUILDING SLAB (LFL).

DO NOT SCALE FROM DRAWINGS. ALL DIMENSIONS TO BE CHECKED TO GENSLER ARCHITECTS IMMEDIATELY. ALL DIMENSIONS TO BE CHECKED BY CONTRACTOR ON SITE PRIOR TO ANY WORKS.

No.	Description
1	MAIN ENTRANCE
2	TAIR RELIEF AIR WALLCAP / LINE ABOVE
3	GENERATOR YARD
4	AM-401 - ROOF STAIRS FROM ROOF AND RAIL ACCESS
5	EXT-701 - SEDUM ROOF BIKE STORE
6	EXT-702 - SEDUM ROOF SMOKE EVAC FAN
7	DWG.01 - RAIN WATER PIPE
8	TRANSFORMER
9	GENERATOR LINK BANK
10	ACMV GENERATOR
11	GENERATOR EXHAUST
12	LINE CALCULATE
13	AM-401 - ROOF ACCESS CAGED LADDER
14	EXT-703 - SEDUM ROOF SMOKE EVAC FAN
15	BAL-401 - ROOF EDGE PROTECTION FREESTANDING RAILING SYSTEM
16	DWG.01 - RAIN WATER PIPE
17	DWG.01 - RAIN WATER PIPE
18	LINE OF CANOPY OVER
19	BAL-101 - BALCONY DELINEDGE PROTECTION FREESTANDING RAILING
20	AM-401 - STAIRS CAGED LADDER FROM ROOF AND RAIL HAUGHY
21	AM-401 - INTERNAL NON-PENETRATIVE STAIRS
22	DWG.01 - RAIN WATER PIPE
23	DWG.01 - INTERNAL RAIN WATER PIPE
24	UPS CLOCK ANTENNA
25	LINE PENETRATION ENCLOSURE - ROOF VENT

LEGEND

No. MOVEMENT JOINT LOCATION

	MOVEMENT JOINT
	ROOF SLOPE
	SEDUM ROOF
	EXTERNAL METAL CAT/TRG RAIL/WALKWAY - IMA 0371
	ROOF GUARDRAIL BAL-401
	PV PANEL
	EXT-104 GRAVEL UNDER PV PANEL ZONES

RED
Rogers Stirk Harbour + Partners
Roofman Road, Bermondsey
London, SE1 2AA, UK
www.rsh-p.com
T: +44 (0)20 3328 5600
F: +44 (0)20 3328 5777
info@rsh-p.com, www.rsh-p.com

Gensler
6 St Pancras Place
First Floor
Granary
Square
King's Cross
Tel: +44 (0)121 285 7600

Microsoft

CWL01

Duffryn Lane Newport
NP10 8BE

Design Team

Drawn	GVG/AS
Checked	JH
Scale	1:200
Date	30.01.25
Drawing Number	0A1-ZZ-DR
B.E.S. Project No.	P-00000

Approvals

Last Update	MICROSOFT	Date
Microsoft Design Manager	JULIE HOLLAND	
Microsoft Electrical Engineer	JAMES GUERRA	
Microsoft Mechanical Engineer	JAYANTH CHANNA	
Microsoft Structural Engineer	JAMES LUCAS	
CDM	SOUTH WALES CONSTRUCTION (SUB-CONTRACTOR)	
Planner	JULIA ZIMMERMANN, SIMON BRAY	
Director Manager	DAVIDE MEDALLA	
Architect/Lead	ROGERS STIRK HARBOUR + PARTNERS	

PROJECT MANAGEMENT

Project Planner	
Project Manager	Date
Director Project Manager	
Development Manager	
Project Manager	
Quality Control Reviewer	
Quality Control Plan	

Revisions

No.	Date	Description
A	30.01.25	JPC ISSUE

Registration

COLOR: FADE/UV COLOUR: COLOUR: DEGLAZ

0	1	2	3	4	5	6	7	8	9	10	11	12	13	14	15	16	17	18	19	20	21	22	23

SITE NORTH

Bar Code

Drawt Title/Number

ROOF - GA PLAN

CWL01-
A-D-05-0

© 2018 RSH
All rights reserved, including but not limited to the Copyright, Design and Patents Act 1988.

CWL01-A-D0A-0-A