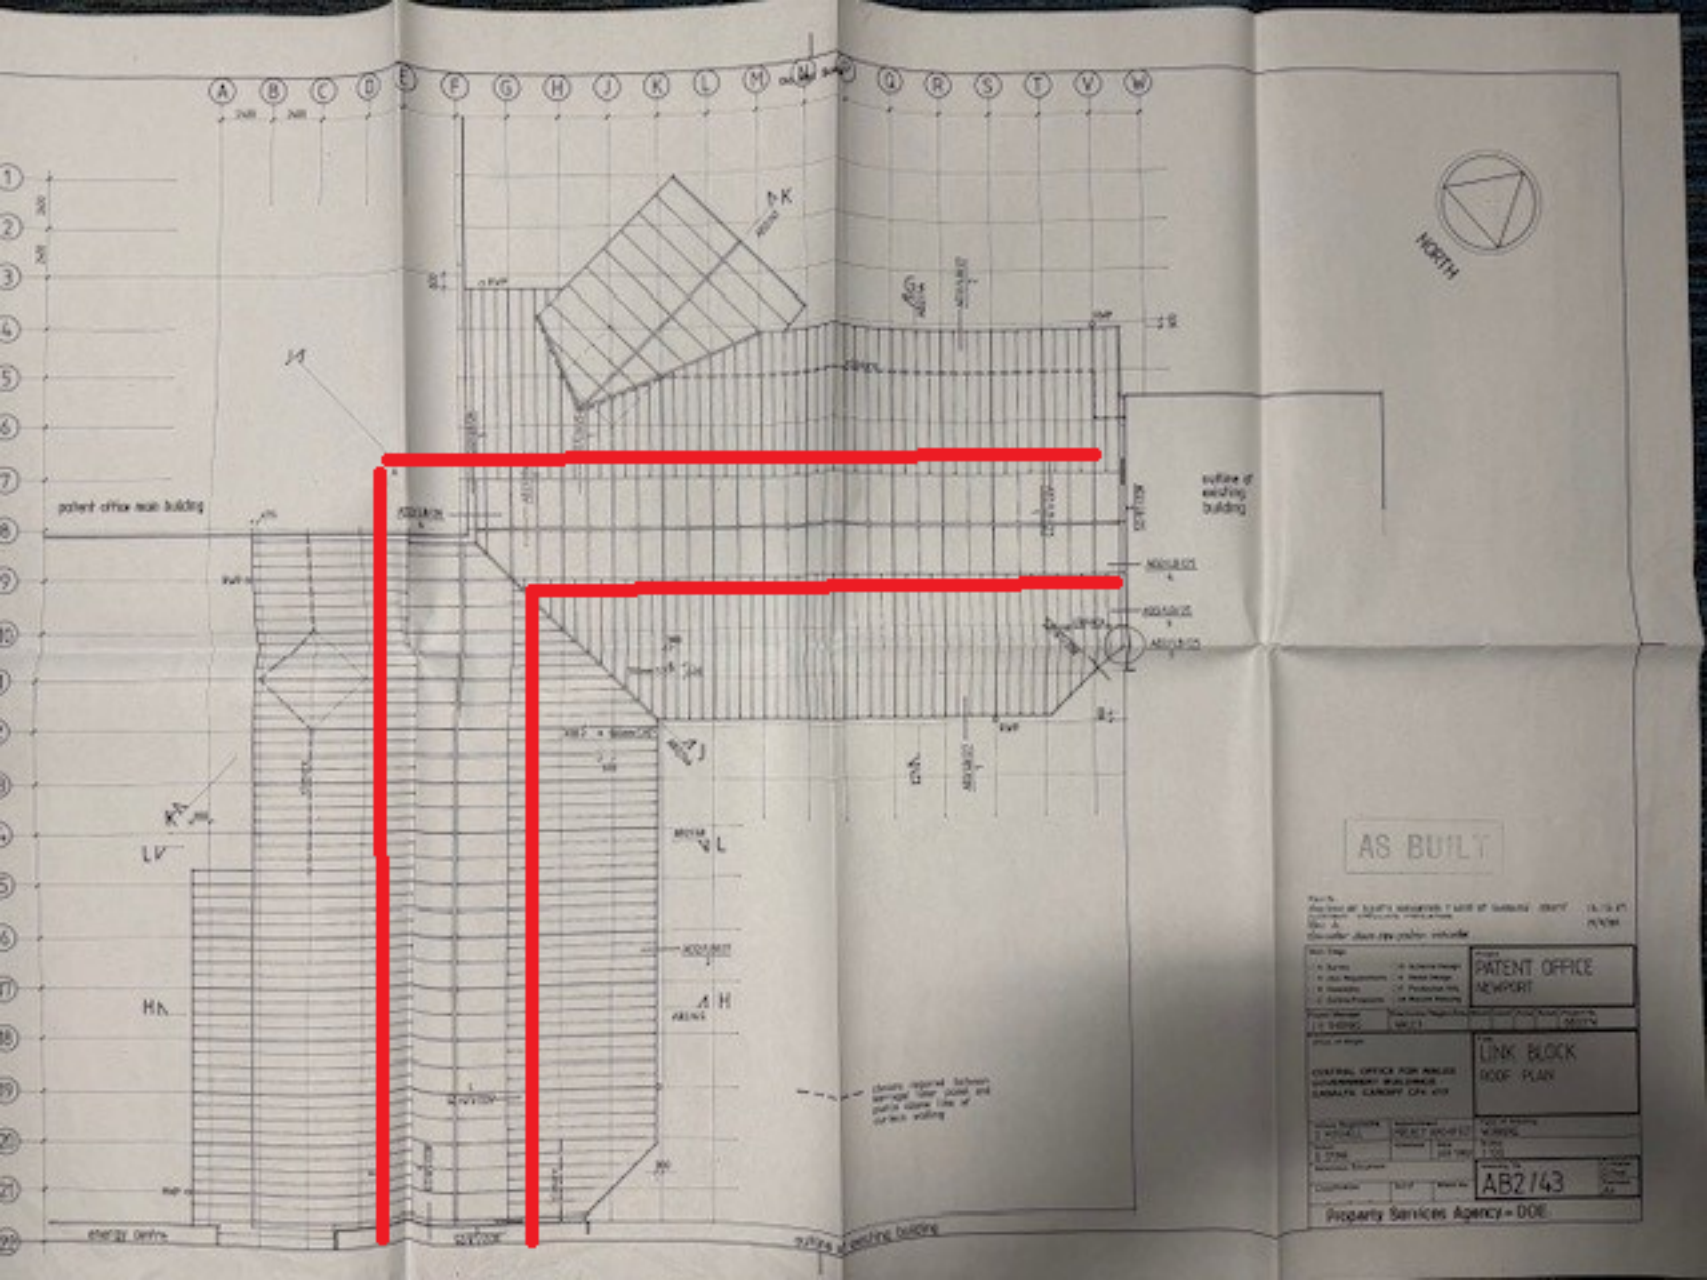
NORTH
patent office main building
outline of existing building
AS BUILT
PATENT OFFICE
NEWPORT
LINK BLOCK
ROOF PLAN
AB2143
Property Services Agency - DOE