


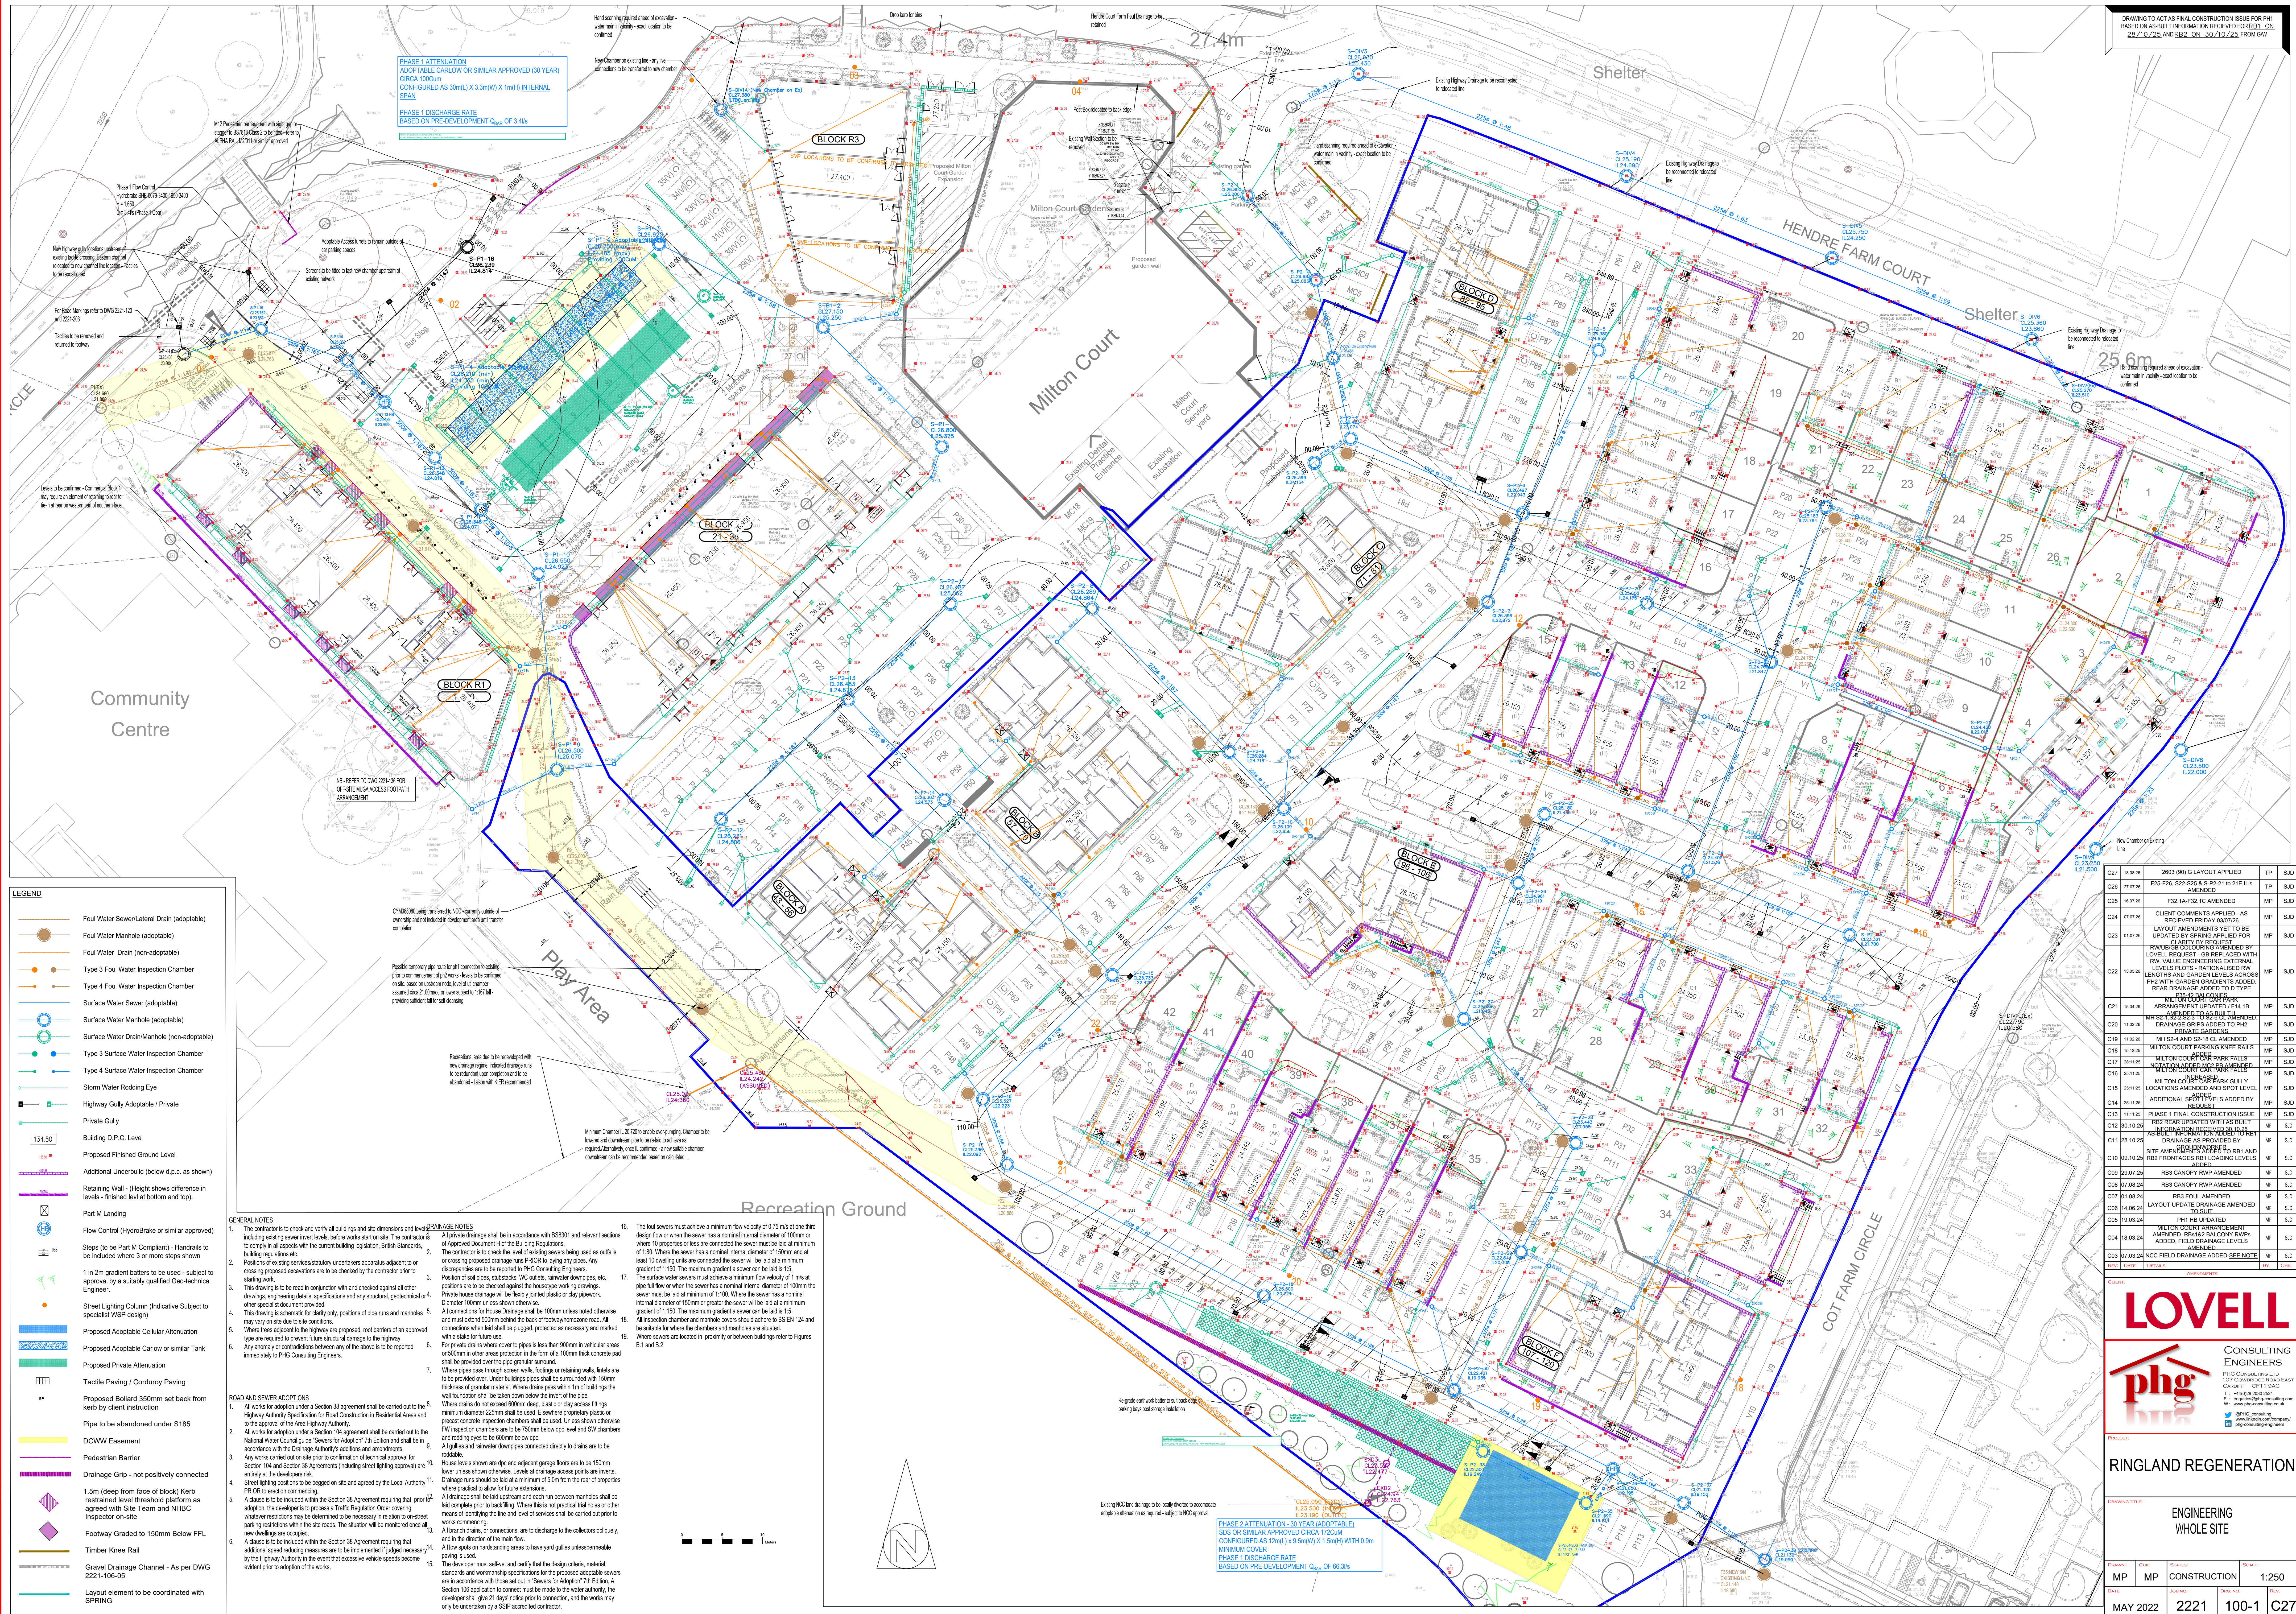

LEGEND

- Foul Water Sewer/Lateral Drain (adoptable)
- Foul Water Manhole (adoptable)
- Foul Water Drain (non-adoptable)
- Type 3 Foul Water Inspection Chamber
- Type 4 Foul Water Inspection Chamber
- Surface Water Sewer (adoptable)
- Surface Water Manhole (adoptable)
- Surface Water Drain/Manhole (non-adoptable)
- Type 3 Surface Water Inspection Chamber
- Type 4 Surface Water Inspection Chamber
- Storm Water Rooding Eye
- Highway Gully Adoptable / Private
- Private Gully
- Building D.P.C. Level
- Proposed Finished Ground Level
- Additional Underbuild (below d.p.c. as shown)
- Retaining Wall - (Height shows difference in levels - finished level at bottom and top)
- Part M Landing
- Flow Control (HydroBrake or similar approved)
- Steps (to be Part M Compliant) - Handrails to be included where 2 or more steps shown
- 1 in 2m gradient barriers to be used - subject to approval by a suitably qualified Geo-technical Engineer.
- Street Lighting Column (Indicative Subject to specified WSP design)
- Proposed Adoptable Cellular Attenuation
- Proposed Adoptable Carlow or similar Tank
- Proposed Private Attenuation
- Tactile Paving / Cordonary Paving
- Proposed Bullard 350mm set back from kerb by client installation
- Pipe to be abandoned under S185
- CDWM Easement
- Pedestrian Barrier
- Drainage Grip - not positively connected
- 1.5m (deep from face of block) Kerb restrained level threshold platform as agreed with Site Team and NRB/C Inspector on-site
- Footway Graded to 150mm Below FFL
- Timber Knee Rail
- Gravel Drainage Channel - As per DWG 2221-106-05
- Layout element to be coordinated with SPRING

- GENERAL NOTES**
- The contractor is to check and verify all buildings and site dimensions and levels including existing sewer invert levels, before works start on site. The contractor is to comply in all aspects with the current building legislation, British Standards, building regulations etc.
 - Positions of existing services/infrastructure/underground apparatus adjacent to or crossing proposed excavations are to be checked by the contractor prior to starting work.
 - This drawing is to be read in conjunction with and checked against all other drawings, engineering details, specifications and any structural, geotechnical or other specialist documents provided.
 - Where new drains are proposed, not barriers of an approved type are required to prevent future structural damage to the highway.
 - Any anomaly or contradiction between any of the above is to be reported immediately to PHG Consulting Engineers.
- All works for adoption under a Section 38 agreement shall be carried out to the Highway Authority Specification for Road Construction in Residential Areas and to the approval of the Area Highway Authority.
 - All works for adoption under a Section 104 agreement shall be carried out to the National Water Council guide 'Sewers for Adoption' 7th Edition and shall be in accordance with the Drainage Authority's additions and amendments.
 - Any works carried out on site prior to confirmation of technical approval for Section 104 and Section 38 Agreements (including street lighting approval) are to be carried out in accordance with the Local Authority's PROR or erection commencing.
 - A clause is to be included within the Section 38 Agreement requiring that, prior to adoption, the developer is to process a Traffic Regulation Order covering whatever restrictions may be deemed to be necessary in relation to on-street parking restrictions within the site roads. The situation will be monitored once all new dwellings are occupied.
 - A clause is to be included within the Section 38 Agreement requiring that additional speed reducing measures are to be implemented if judged necessary by the Highway Authority in the event that excessive vehicle speeds become evident prior to adoption of the works.

- All private drainage shall be in accordance with BS8001 and relevant sections of Approved Document B of the Building Regulations.
 - The contractor is to check the level of existing sewers being used as outfalls or crossing proposed drainage runs PRIOR to laying any pipes. Any discrepancies are to be reported to PHG Consulting Engineers.
 - Position of all pipes, substations, VC outlets, stormwater overflows, etc., positions are to be checked against the householder's working drawings. Private house drainage will be fixedly jointed plastic or clay pipework. Diameter 100mm unless otherwise stated.
 - All connections for House Drainage shall be 100mm unless noted otherwise and must extend 500mm behind the back of footpath/road. All connections shall be laid at a minimum of 150mm below the finished ground level and be suitable for where the chambers and manholes are situated.

LOVELL

CONSULTING ENGINEERS

PHG CONSULTING LTD
107 COMMERCE ROAD EAST
CARDIFF CF11 1BA
T: +44(0)300 200 200
E: enquiries@phg-consulting.com
W: www.phg-consulting.com

PROJECT

RINGLAND REGENERATION

DRAWING TITLE

ENGINEERING WHOLE SITE

DRAWN	CHECK	REVISION	CONSTRUCTION	SCALE
MP	MP			1:250
DATE	JOB NO.	DWG. NO.	REV.	
MAY 2022	2221	100-1	C27	

