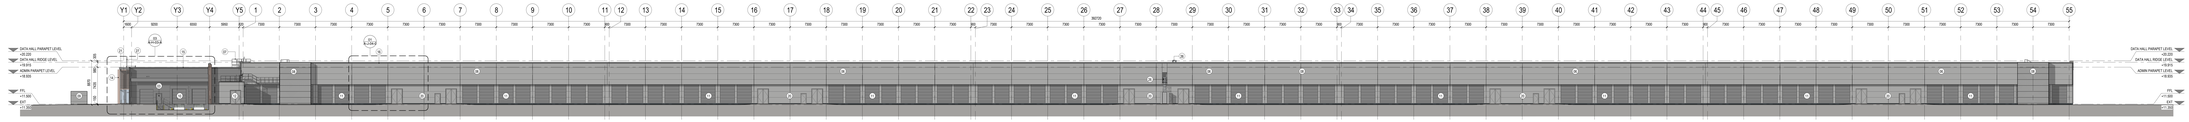

01 NORTH ELEVATION
SCALE 1 : 200

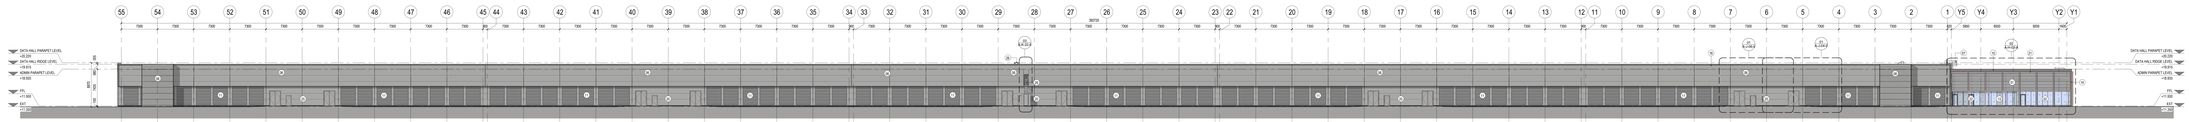

02 SOUTH ELEVATION
SCALE 1 : 200

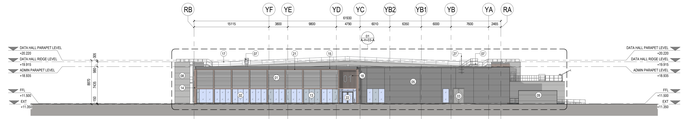

03 EAST ELEVATION
SCALE 1 : 200

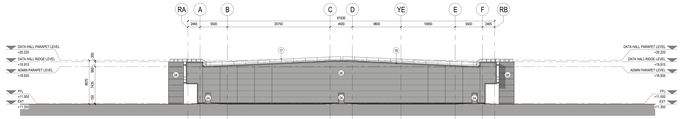

04 WEST ELEVATION
SCALE 1 : 200

SHEET NOTES

No.	ELEMENT DESCRIPTION	MATERIAL & FINISH	COLOUR
1	30MIN RP CLEARANCE	ALUMINIUM, PPC	RAL 7016
2	EWS 101 CURTAIN WALL	ALUMINIUM, PPC	RAL 7016
3	DWS-001 SOLID DOOR - ADMIN	STEEL, PPC	RAL 9007
4	DWS-001 SOLID DOOR - DATA HALL	STEEL, PPC	RAL 9006
5	DWS-002 METAL CLADDING - ADMIN	ALUMINIUM, PPC	RAL 9006
6	DWS-002 METAL CLADDING - DATA HALL	ALUMINIUM, PPC	RAL 9006
7	MM-001-RD ROOF ACCESS STAIRS / LADDER	GALVANISED STEEL	
8	MM-002-RD ROOF ACCESS STAIRS AND ROOF MAINTENANCE ACCESS STAIRCASE BEHIND	STEEL, PPC	RAL 9006
9	DN-100-MM STAIR	STEEL, PPC	
10	LOADING DOCK		
11	EWS-102 ALUMINIUM PANELS	ALUMINIUM, PPC	RAL 9006
12	EXTERNAL PLANT ROOM	RAL GALVANISED STEEL	
13	GL-102 SPANDREL GLAZED PANEL	GLASS	CLEARBL TT
14	VEL3-MM CLOAK	TIMBER	
15	JM-101 PARAPET COPING - ADMIN	ALUMINIUM PROFILE	RAL 9007
16	JM-102 PARAPET COPING - DATA HALL	ALUMINIUM PROFILE	RAL 9006
17	JM4-001 ROOF BALUSTRADE	GALVANISED STEEL	
18	EWL-04 TIMBER SLATTED PANEL	TIMBER	
19	EWS-103 ALUMINIUM EPS	ALUMINIUM, PPC	RAL 7016
20	ADMIN CLOAK	GALVANISED STEEL	
21	DWS-001 TIMBER SOFFIT	TIMBER	
22	EWS-101 ALUMINIUM	ALUMINIUM, PPC	RAL 7016
23	DWS-002 SOLID DOOR - GALVANISED	ALUMINIUM, PPC	RAL 9006
24	DWS-002 FIRE DAMPER MAINTENANCE ACCESS PANELS	ALUMINIUM, PPC	RAL 9006
25	DWS-001 RAM ACCESS DOOR	ALUMINIUM, PPC	RAL 9006
26	MM-001 DEAPM VAULT LADDER FROM ROOF AND RAM WALKWAY	GALVANISED STEEL	
27	GPR DOOR ANTENNA		

GENERAL NOTES

1. ALL VERTICAL DIMENSIONS ARE RELATIVE TO ASSOCIATED BUILDING SLAB LEVEL.
2. DO NOT SCALE FROM DRAWINGS. ALL DISCREPANCIES TO BE REPORTED TO GENSLER ARCHITECTS IMMEDIATELY. ALL DIMENSIONS TO BE VERIFIED BY CONTRACTOR ON SITE PRIOR TO ANY WORKS.
3. THIS DRAWING IS TO BE PRINTED IN COLOUR.

LEGEND

- RAL 9006 ADMIN BUILDING
- RAL 9007 ADMIN ROOF, GENERATORS AND EXTERNAL EQUIPMENT
- RAL 7016 ACCENT COLOURS: DOORS, WINDOWS AND RAINWATER PIPE
- WOOD/TIMBER - FEATURES OF THE BUILDING CANOPIES, SOFFITS
- INSULATED GLAZED SPANDREL PANEL - COLOREDL TT
- DOUBLE GLAZED PANEL - CLEAR GLAZING
- 01 / 02 BUILDING SECTION
- SPOT LEVEL
- 01 SHEET NOTE

AL-XXLxxBxxZZ0000ZR-CWA

MICROSOFT CONFIDENTIAL

RED
Unit 2 Ridge Business Park
Station Road, Bucknell
Oxfordshire OX27 7LW
www.red-dog.com
T: +44 (1869)320600
F: +44 (1869)320777
E: mail@red-dog.com

Gensler
4 St Pancras Place
First Floor
Pancras Square
London
N1C 4AG
United Kingdom
Tel: +44 (0)121 200 1500

Microsoft

CWL01

Duffryn Lane Newport
NP10 8BE

Design Team

Client	Microsoft
Zone	JV
Discipline	A
Title	As Built
Drawing Prefix No.	AL-XX-XX
M.S. Project No.	Y-Zone

Approvals

LANDLORD	MICROSOFT	Date
Microsoft Project Manager	JULIE COLLAGE	
Microsoft Design Manager	JAMIE BURTON	
Microsoft Construction Project Manager	JAMIEBOY PRESSER	
Microsoft Construction Engineer	JAMIE BOOT	
CDM	SHARMARIN ABDUL CHOUDHURY MANDOWAL	
Planning	MARIA MALLYON BARKER	
Security Manager	DAVID MCBRIDE	
Environmental	DAVIDE GORDON	

PROJECT MANAGEMENT

Project Planner	
Project Manager	Date
Senior Project Manager	
Development Manager	
Project Manager	
Quality Control Reviewer	
Quality Control Final	

Revisions

Rev	Date	Description
A	05.08.24	PC ISSUE

Registration

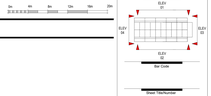

Bar Code

Sheet Title/Number

BUILDING ELEVATIONS - OVERALL COLOUR

CWL01-A-H-02-0

© RED 2024
All rights reserved, including but not limited to The Copyright Design and Patents Act 1988