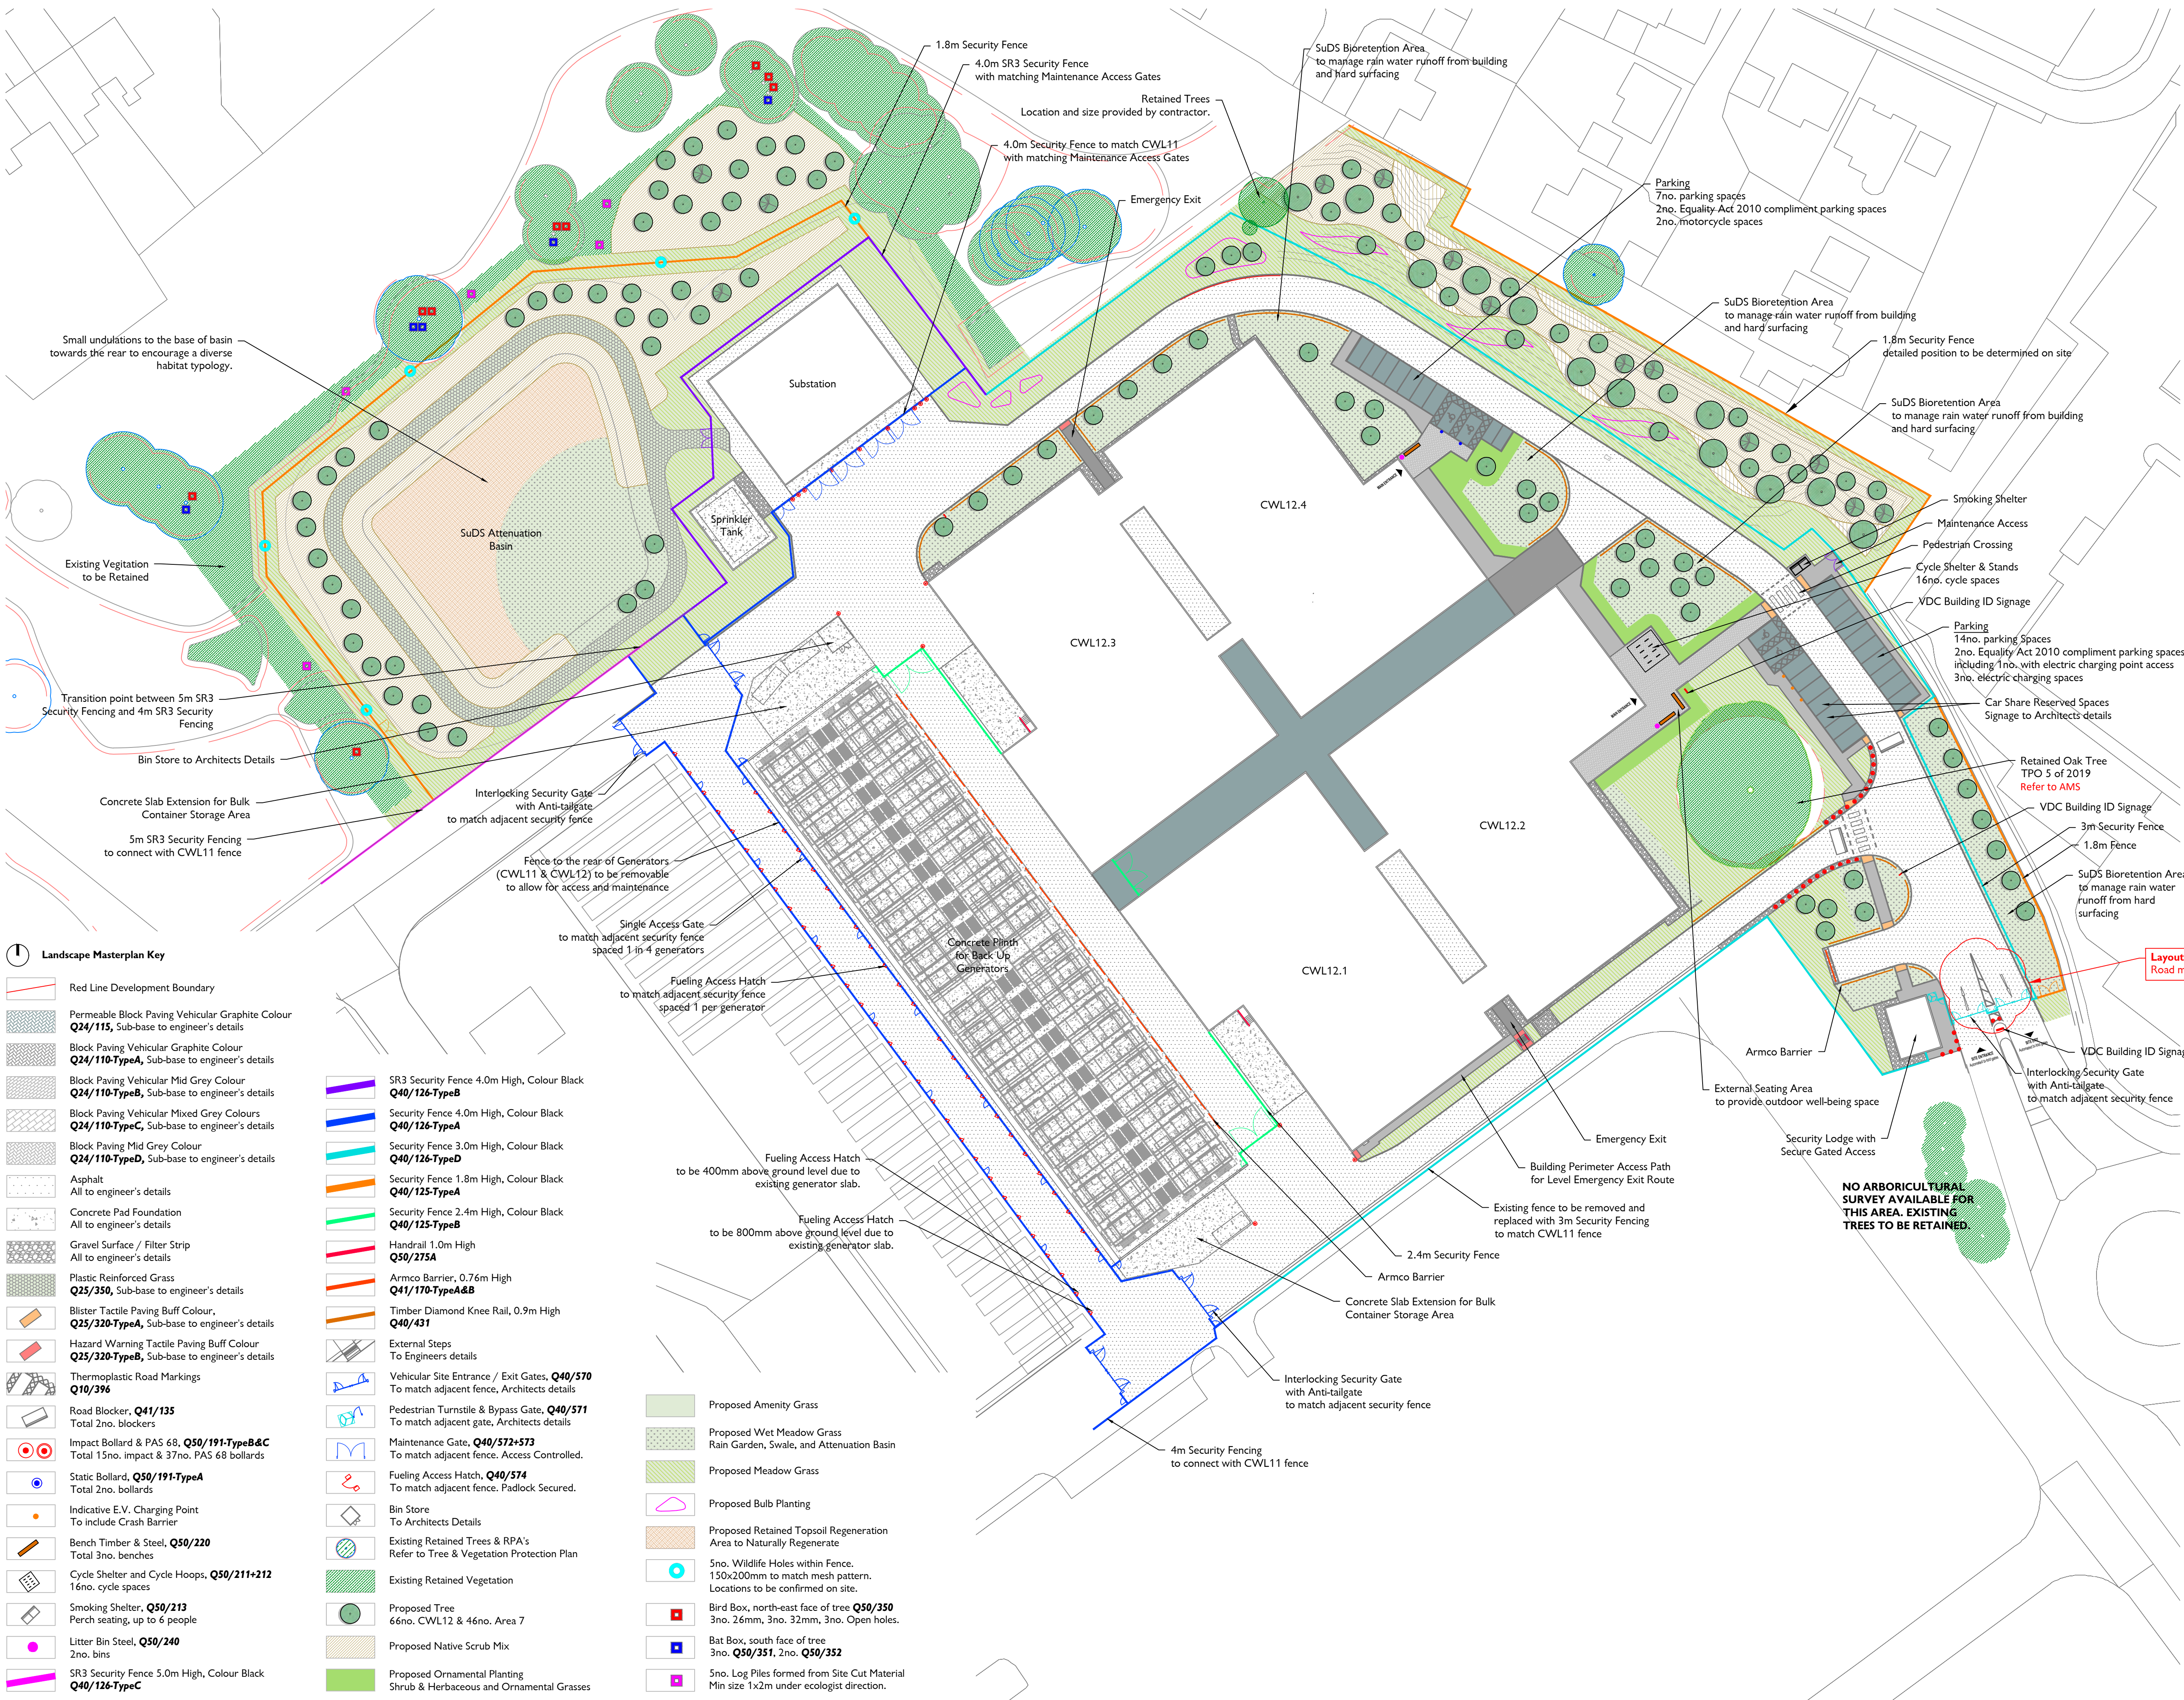


DRAWING NOTES:

- All dimensions are in millimeters unless otherwise stated.
- All landscape drawings are to be read in conjunction with engineering package.
- 'SuDS' - Sustainable Drainage Systems
- For Arboricultural Survey refer to Atkins Arboricultural Impact Assessment, November 2019.
- For Tree & Vegetation Protection & Removal refer to CWL12-SOLB-ZZ-SI-DR-L-900101.
- All proposed tree locations subject to review and coordination as part of developing detail design at WS4.
- For Hard Landscape General Arrangement refer to CWL12-SOLB-ZZ-SI-DR-L-900301.
- For Soft Landscape General Arrangement refer to CWL12-SOLB-ZZ-SI-DR-L-900401.
- For Proposed External Finished Levels refer to CWL12-HYDR-SW-XX-DR-C-900110.

Layout / Design subject to review
Road markings to be detailed by civil engineer.

WS5

C11	17.06.25	Minor tree coordination	RC	SM
C10	04.06.25	13no. additional trees added. Issue for review & comment	RC	SM
C09	22.05.25	Updates to SuD features, gate house path and bollards.	RC	SM
C08	08.04.25	As built fence added. SuD update, additional notes.	RC	SM
C07	28.03.25	Fence, electric charging and gate house amendments	RC	SM
C06	24.02.25	Sub-station retaining wall omitted	RC	SM
C05	18.02.25	Updates to bi-fold gates	RC	SM
C04	19.12.24	Updates to skip area and entrance gates	RC	SM
C03	28.11.24	Updates following Civils comments	RC	SM
P04	22.11.24	Amendments to fencing and eastern bund planting	RC	SM
P03	20.11.24	Amendments to site entrance, Class B updates	RC	SM
P02	04.11.24	Amendments to Fencing	RC	SM
P01	19.07.24	WS5 issue for comments	RC	SM
C02	12.04.24	Bin Store added adjacent to generators	RC	SM
C01	08.04.24	First issue	RC	SM
Rev.	Date	Comment	Approved	Drawn

Previously CWL12-SOLB-SW-XX-DR-L-900102-Landscape Model-S4-C12

PRELIMINARY | PLANNING | DESIGN | TENDER | **CONSTRUCTION**

soltysbrewster

4 Stargate House
Stargate Road
Ponarth, Vale of Glamorgan
CF46 3AA

Telephone: +44(0) 33 0013 0012
e-mail: enquiry@soltysbrewster.co.uk

client



project

CWL12 Vantage Data Centre

drawing title

Landscape Masterplan

scale drawn approved date

1:500 @ A1 SM RC April 2024

drawing no. suitability revision

CWL12-SOLB-ZZ-SI-DR-L-900201 S5 C11

Soltys Brewster Consulting is the trading name of Soltys Brewster Consulting Ltd. Registered Office: 4 Stargate House, Stargate Road, Ponarth, Vale of Glamorgan, CF46 3AA, Registration No. 4263172.
Dimensions should not be scaled from this drawing, only figured dimensions are to be used. All discrepancies or queries regarding this drawing should be referred to Soltys Brewster Consulting Ltd. Soltys Brewster Consulting Ltd accept no liability for any expenses, loss or damage of whatever nature and however arising from variation made to this drawing or in the execution of the work to which it relates which has not been referred to them and their approval obtained.