



Provide round post and 1200 high square galvanised steel sheep fence set at 500mm from the boundary and then to the inside of the fence plant a laurel hedge *Prunus Laurocerasus Rotundiflora* as below

Hedge Planting
Length of hedge from A - B 10m
Length of hedge from C - D 62m

Landscaping Specification
Continuous Hedge Planting 72m total
5 plants per linear metre planted in staggered double row 400mm apart
Size 450-600mm high
Number
72m total will require 360 total Prunus Laurocerasus Rotundiflora Laurel plants
To be kept at 1700mm high when fully grown

Tree Planting
 Sizes standard 100mm root balled and 2-3.5m high

1 tree Plum
1 tree Pear
1 tree Oak
1 tree Magnolia
4 trees total

Requirements

You must

- carry out work between 1st November and 31st March
- prepare the ground along a 1.5m wide strip to provide good soil conditions and as little competition from other vegetation as possible.
- apply any herbicide to the 1.5m strip in the August or September prior to planting only
- plants must be:-
- 2 year old transplants
- at least 450mm to 600mm high
- planted in a staggered double row 400mm apart with a minimum of 6 plants per metre
- kept clear of weeds until they are established
- remove guards and tree shelters once the plants are established
- replace all failures in the following planting season
- trim the newly planted hedge in at least the first 2 years to encourage bushy growth, allowing the hedge to become taller and wider at each cut

Planting

To plant a hedge successfully,

1. Prepare the ground so the soil becomes friable (has a crumbly texture) and is free of other growth.
 2. Take care of rots before planting by keeping them covered at all times, especially when it is sunny or windy.
 3. Avoid opening more than one bag of plants at a time
- | | | |
|---|----------|-----------------------|
| E | 10-7-26 | Planting Improvements |
| D | 18-05-26 | As built |


Control Weeds

Control competitive weeds (including brambles, nettles and grasses) during the first growing season. These weeds reduce the growth rate of the new plants by competing for soil moisture, nutrients and light. Avoid using a strimmer as these can damage the plants

When to Plant

November is generally the best time to plant. However if you are planting into clay soils wait until March. Do not plant in freezing weather or on waterlogged ground.

Confirmation that the orchard and frontage trees retention and that the Sycamore will be allowed to grow back

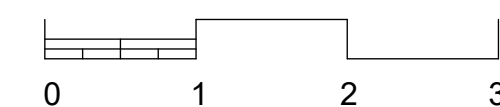

1 A2 scale 1-50
1 : 50

E	10-7-26	Planting Improvements
D	18-05-26	As built
C	07-09-23	notes added plus extra tree (Magnolia)
B	26-07-23	notes added plus extra tree (Oak)

rev	date	description
Planning	23/0201	Building Regs

Maison Design

architectural practice

25 Caldicot Road
Rogiet
Monmouthshire
NP26 3SE

tel 01291 422712
E mail
mark@maisondesign.biz
WEB www.maisondesign.biz

Copyright of this drawing or part thereof is by Maison Design and not to be copied

Project	Proposed Plot Layout
---------	----------------------

Name Mr Tony Kirton
Talisman
Langstone

Date	February 2023	MH-9436
------	---------------	---------

MH-9436